PARENT PARCEL: 05-00-004-102-009, -011

CHILD PARCEL: 05-00-004-102-070 THRU -072

STARTING POINT: NORTHWEST CORNER OF S/L 13 IN HOMESTEAD ACRES

18-03856

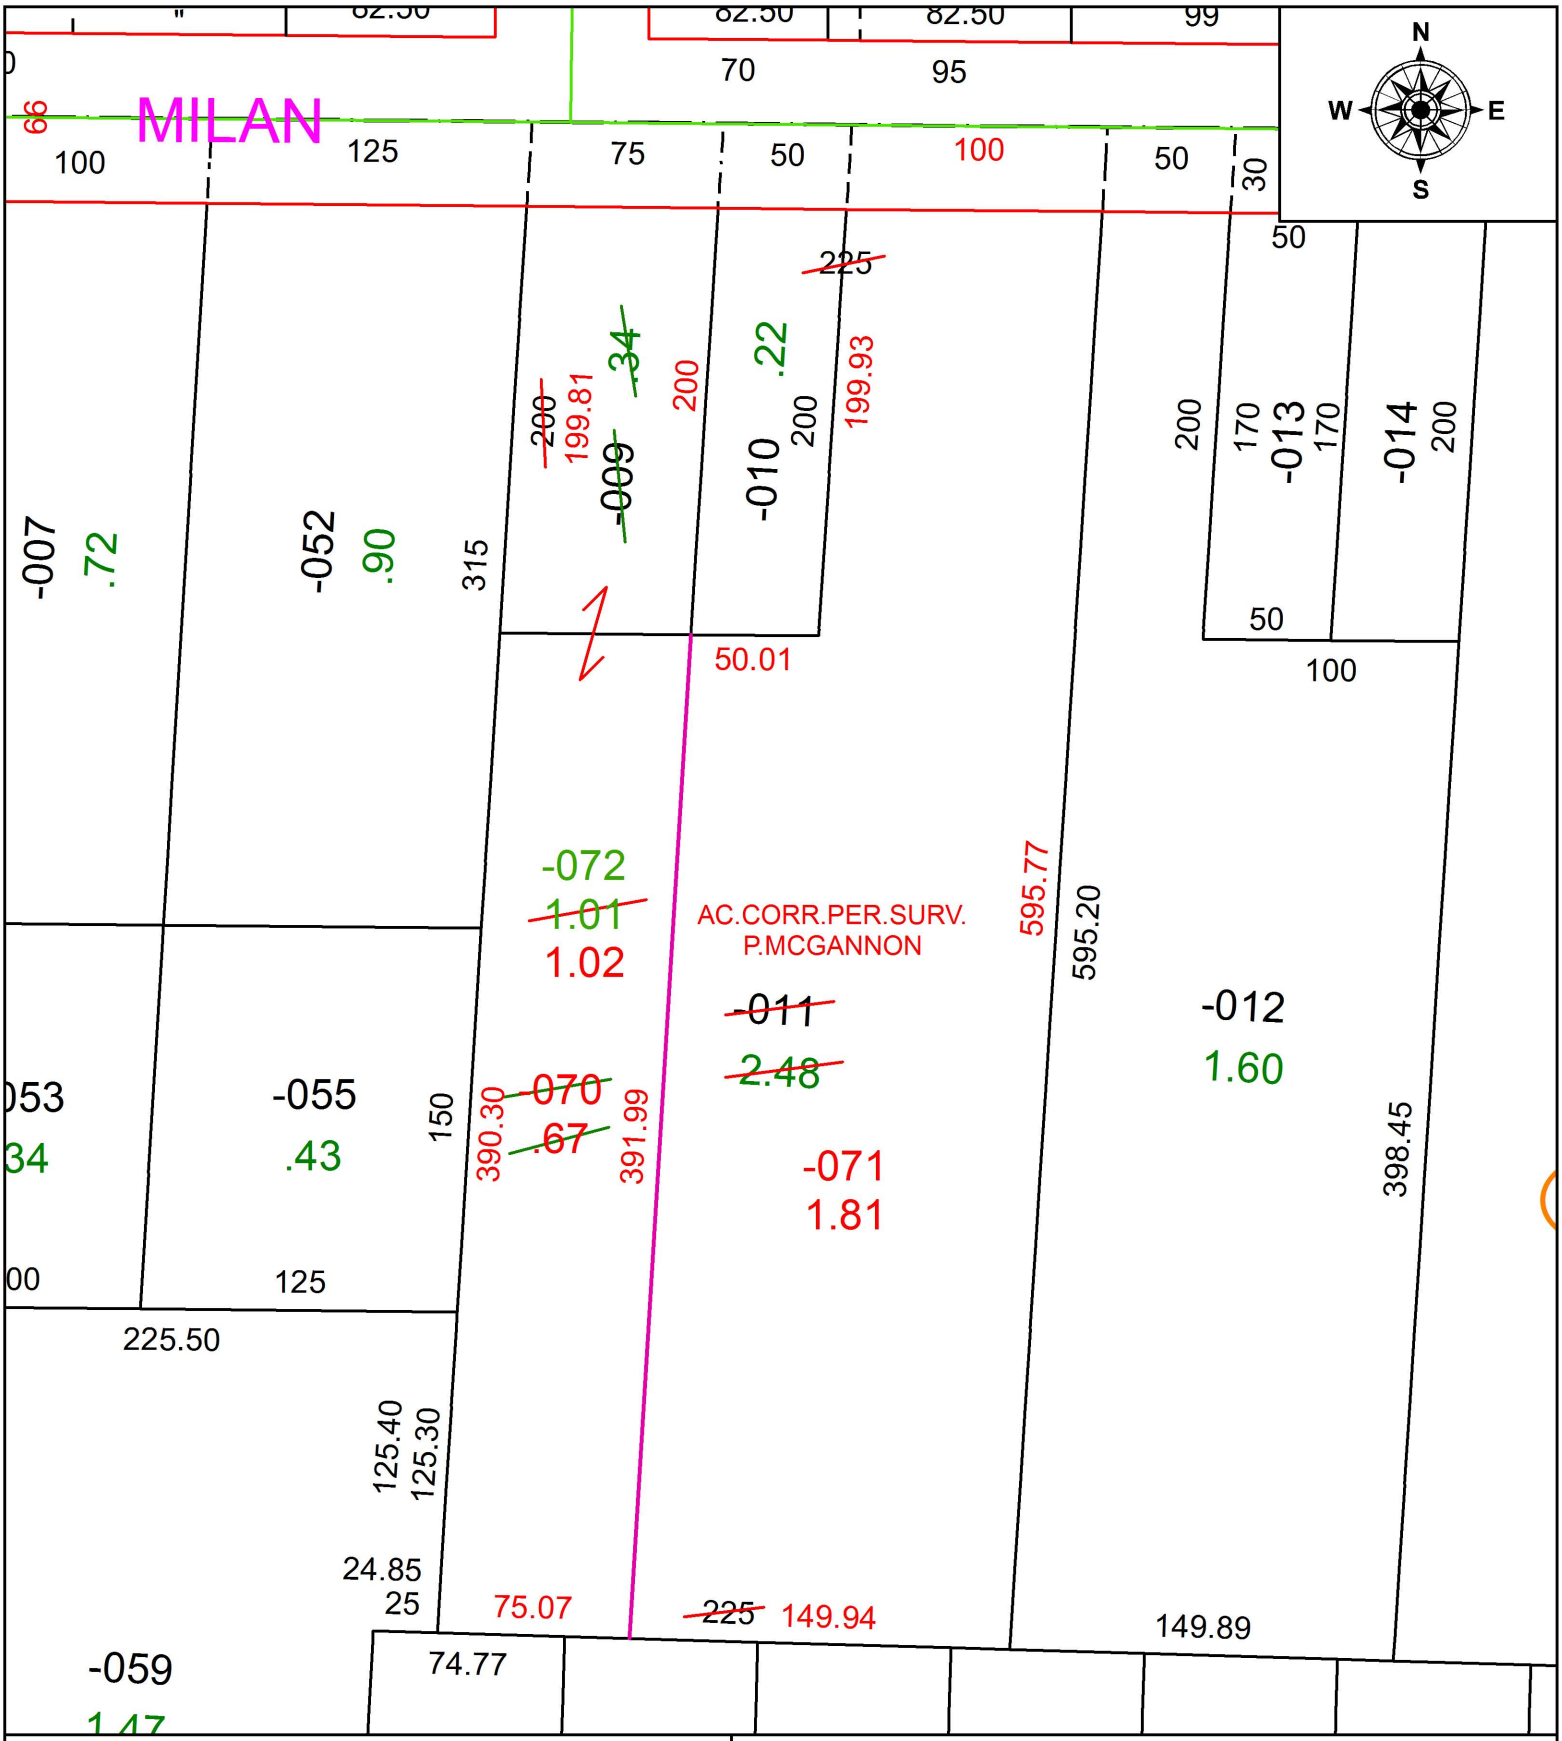

SPLITS/DEEDS PROCESSED

LORAIN COUNTY TAX MAP DEPARTMENT
226 MIDDLE AVE. ELYRIA, OH

SURVEYED BY: PATRICK A. MCGANNON
CLOSURE: 1: 225,577
MAP PAGE(S): 5-00-004
APPOVED BY: RRM **DATE:** 8-13-18
SCALE: 1" = 75 **PRIOR INSTRUMENT:** 20180676879