PARENT PARCEL: 01-00-005-104-019
CHILD PARCEL: XX-XX-XXX-XXX-XXX
STARTING POINT: INTERSECTION OF NORTH LINE OF SHADY LAKE DR. AND EAST LINE OF SUNNYSIDE RD.

18-03857-D

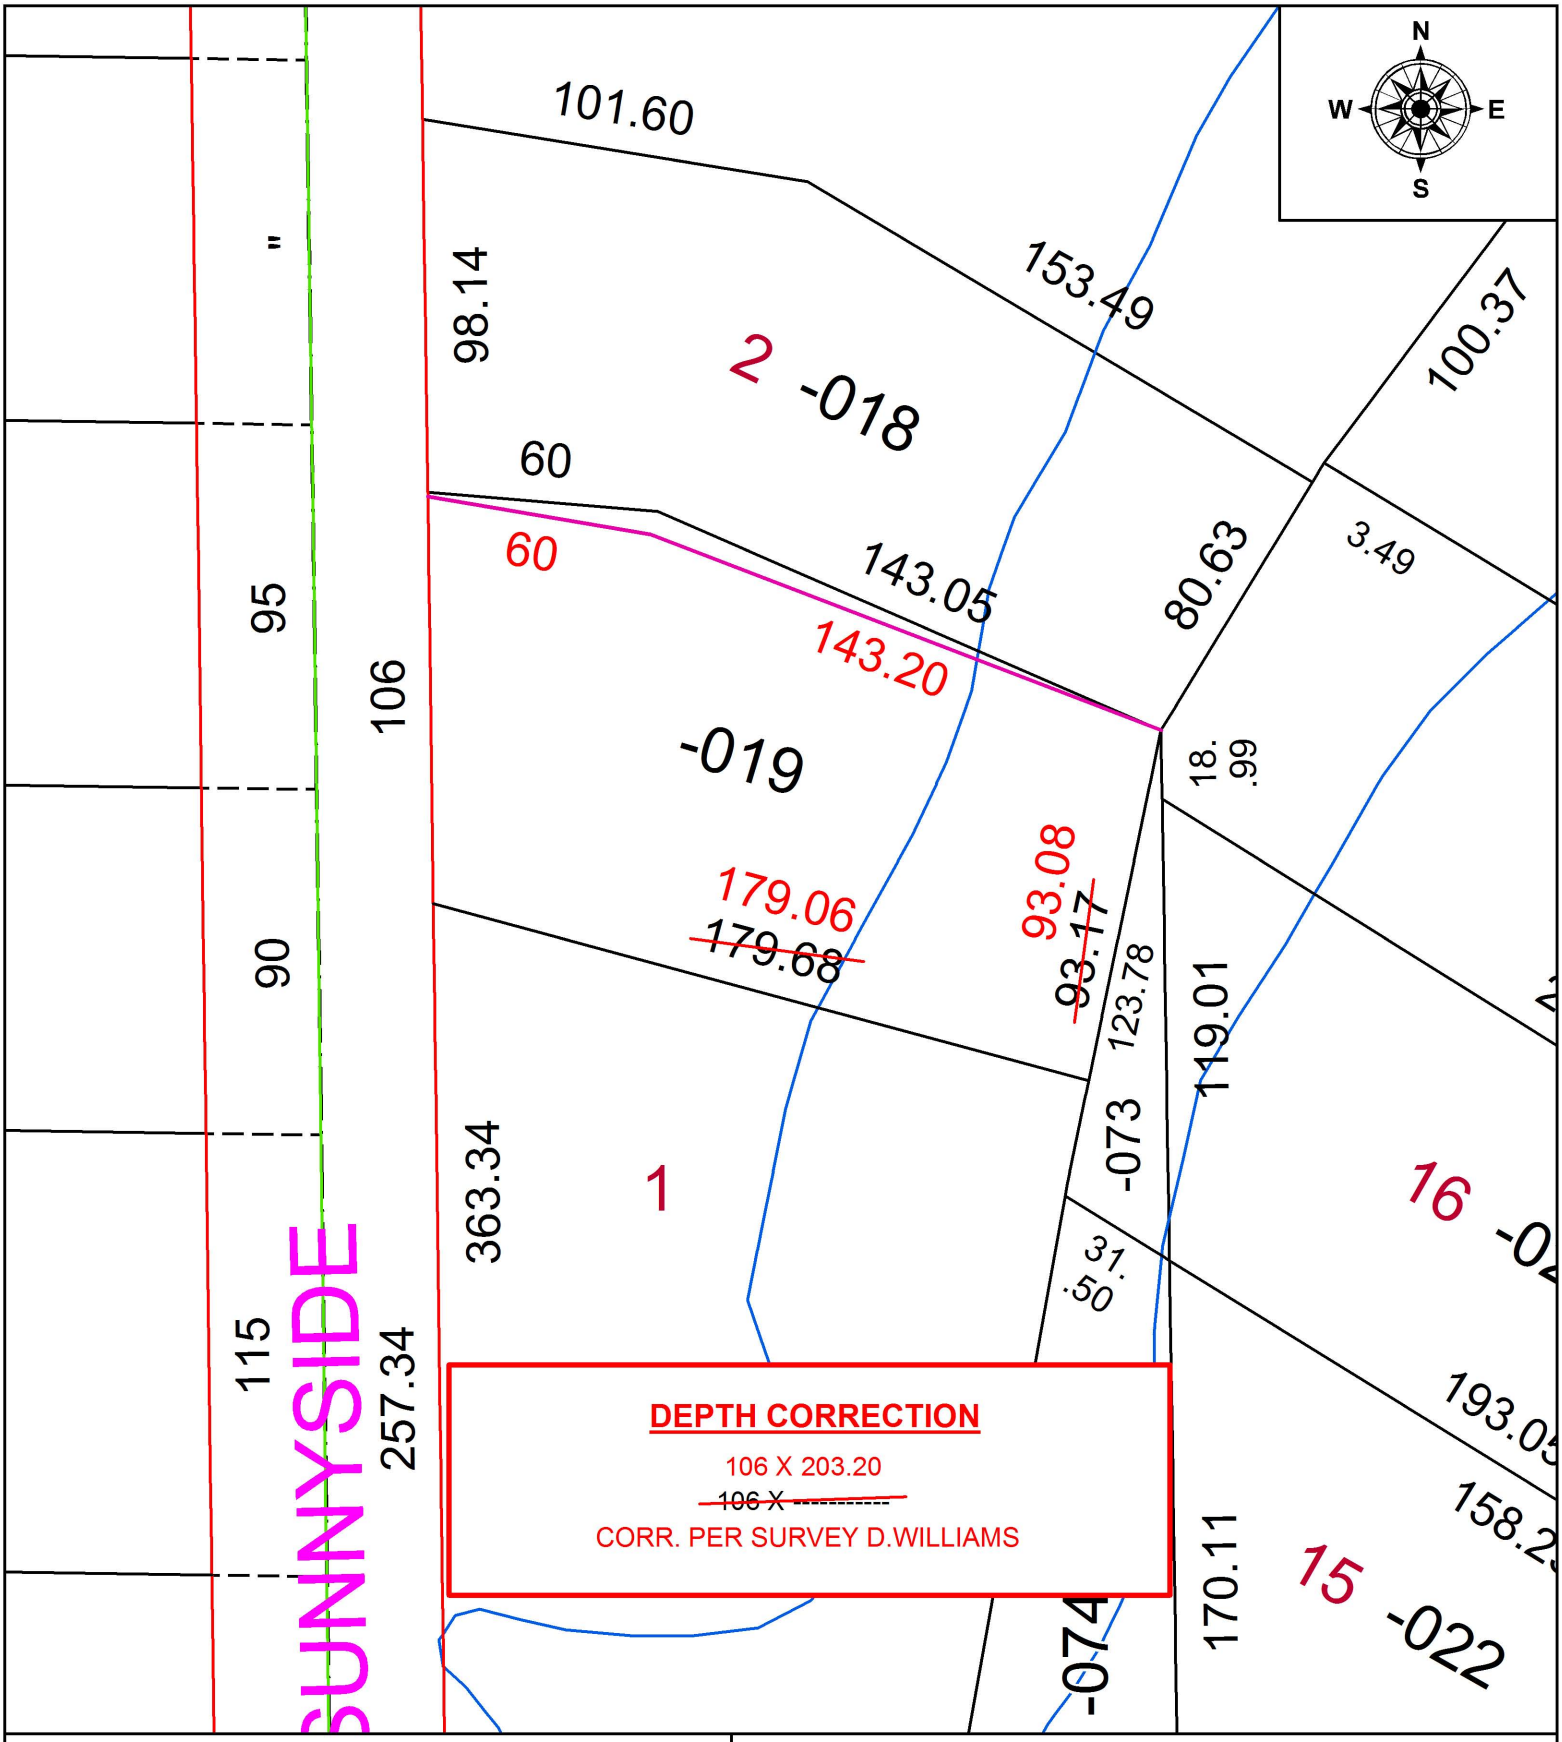

SPLITS/DEEDS PROCESSED
LORAIN COUNTY TAX MAP DEPARTMENT
226 MIDDLE AVE. ELYRIA, OH

SURVEYED BY: DAVID A. WILLIAMS
CLOSURE: 1: 133,001
MAP PAGE(S): 1-00-005
APPOVED BY: RRM **DATE:** 3-15-18
SCALE: 1" = 50 **PRIOR INSTRUMENT:** 20030964182