PARENT PARCEL: 01-00-004-120-055
CHILD PARCEL: 01-00-004-120-058 THRU -062
STARTING POINT: INTERSECTION OF C/L OF ROANOKE DR. AND C/L OF SUNNYSIDE RD.

18-03857

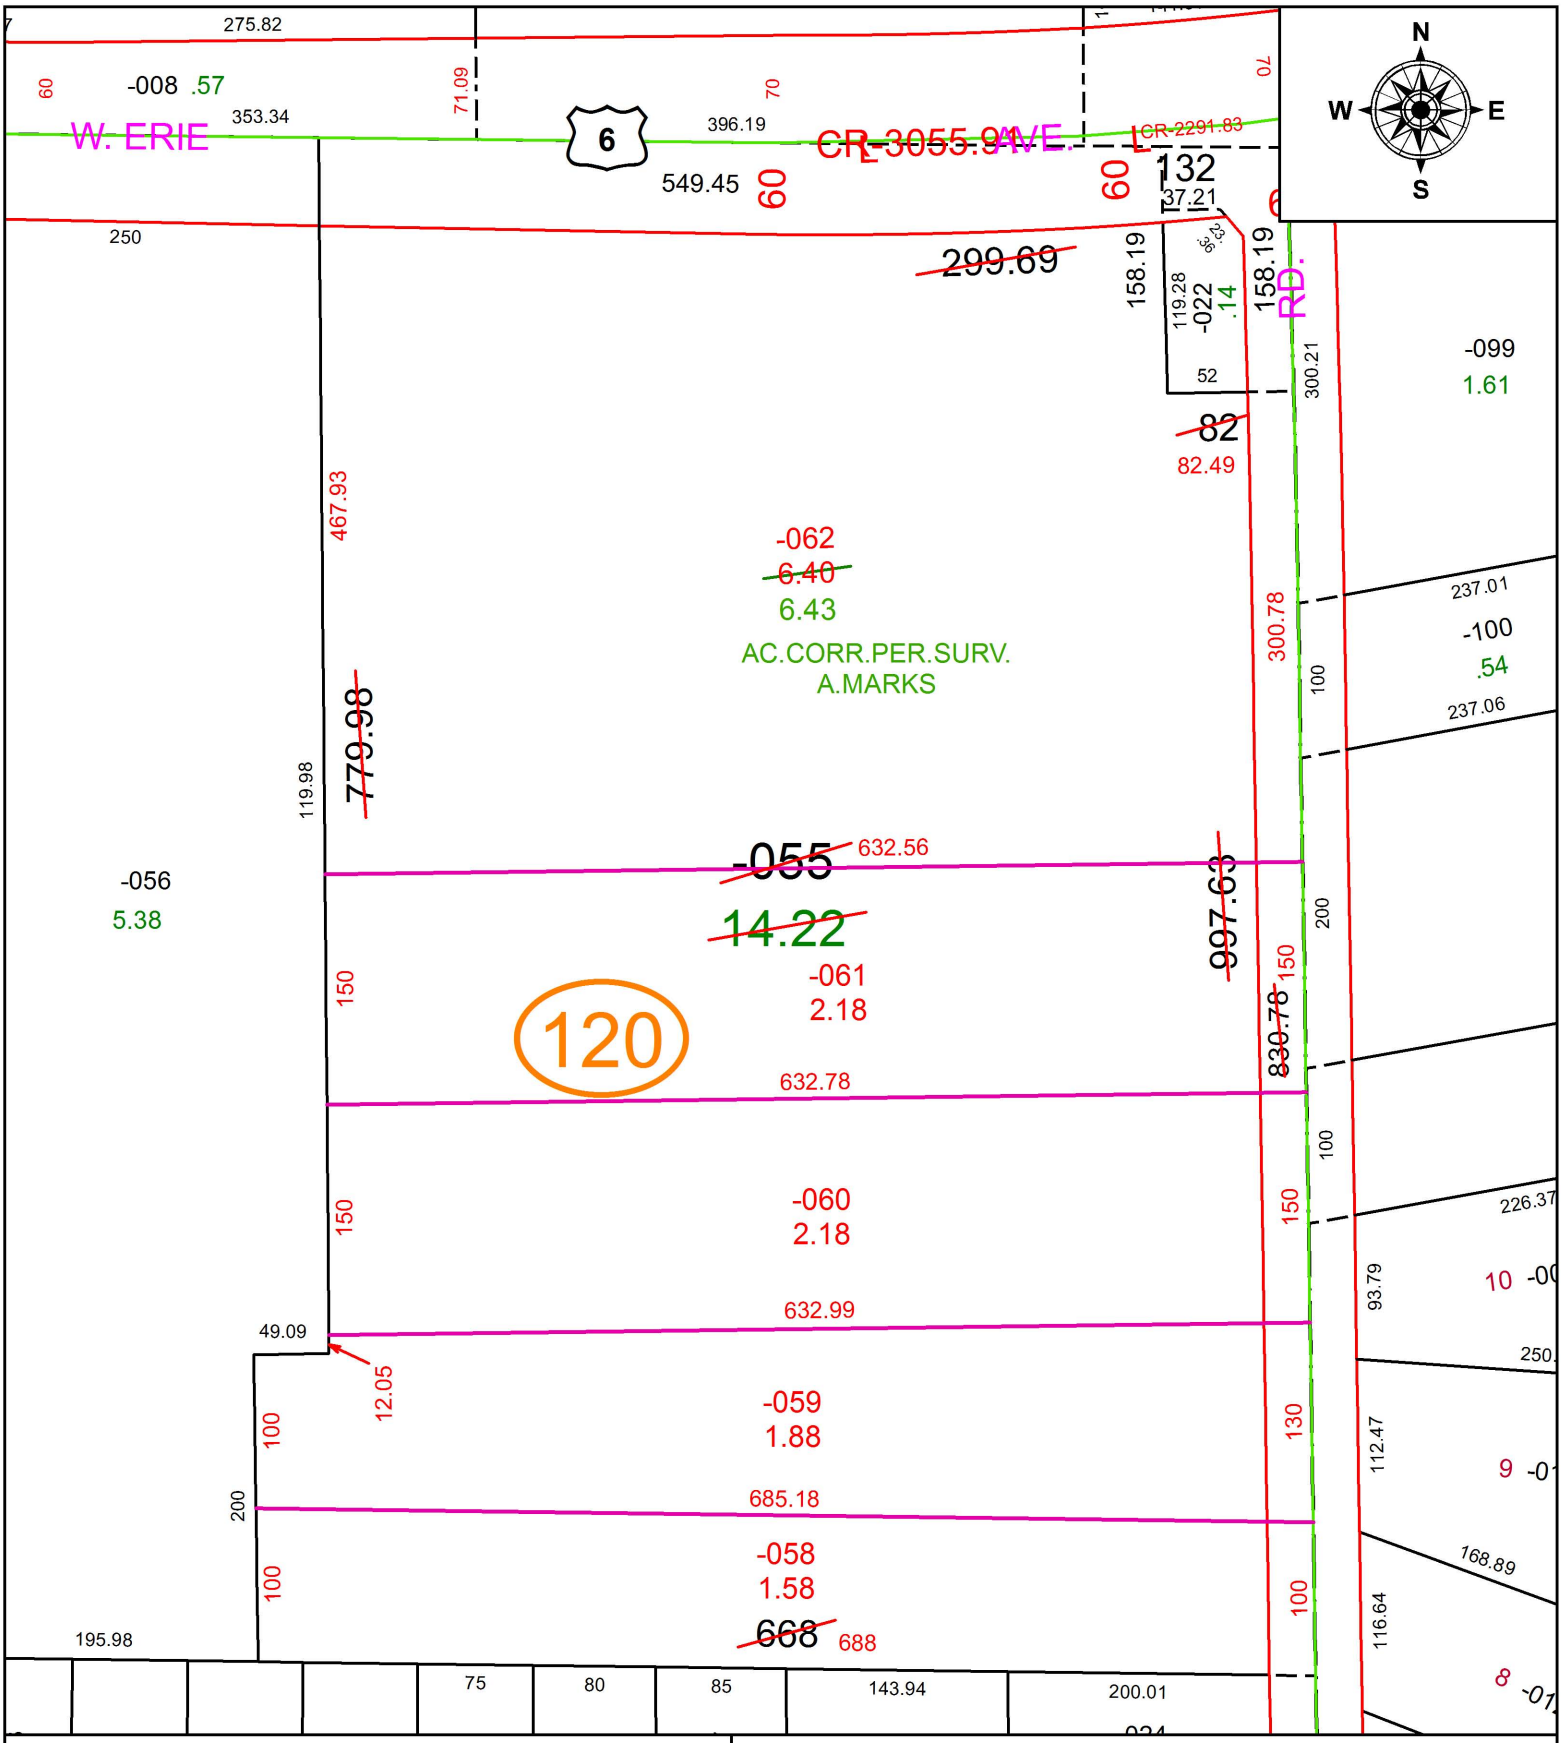

SPLITS/DEEDS PROCESSED
LORAIN COUNTY TAX MAP DEPARTMENT
226 MIDDLE AVE. ELYRIA, OH

SURVEYED BY: ALEX E. MARKS
CLOSURE: 1: 396,794
MAP PAGE(S): 1-00-004
APPOVED BY: RRM **DATE:** 8-14-18
SCALE: 1" = 125 **PRIOR INSTRUMENT:** 20170653481