PARENT PARCEL: 09-00-096-110-001, -002, -004

CHILD PARCEL: 09-00-096-110-026

STARTING POINT: INTERSECTION OF C/L OF S. PARK ST. AND C/L OF GRAFTON ST.

18-03862

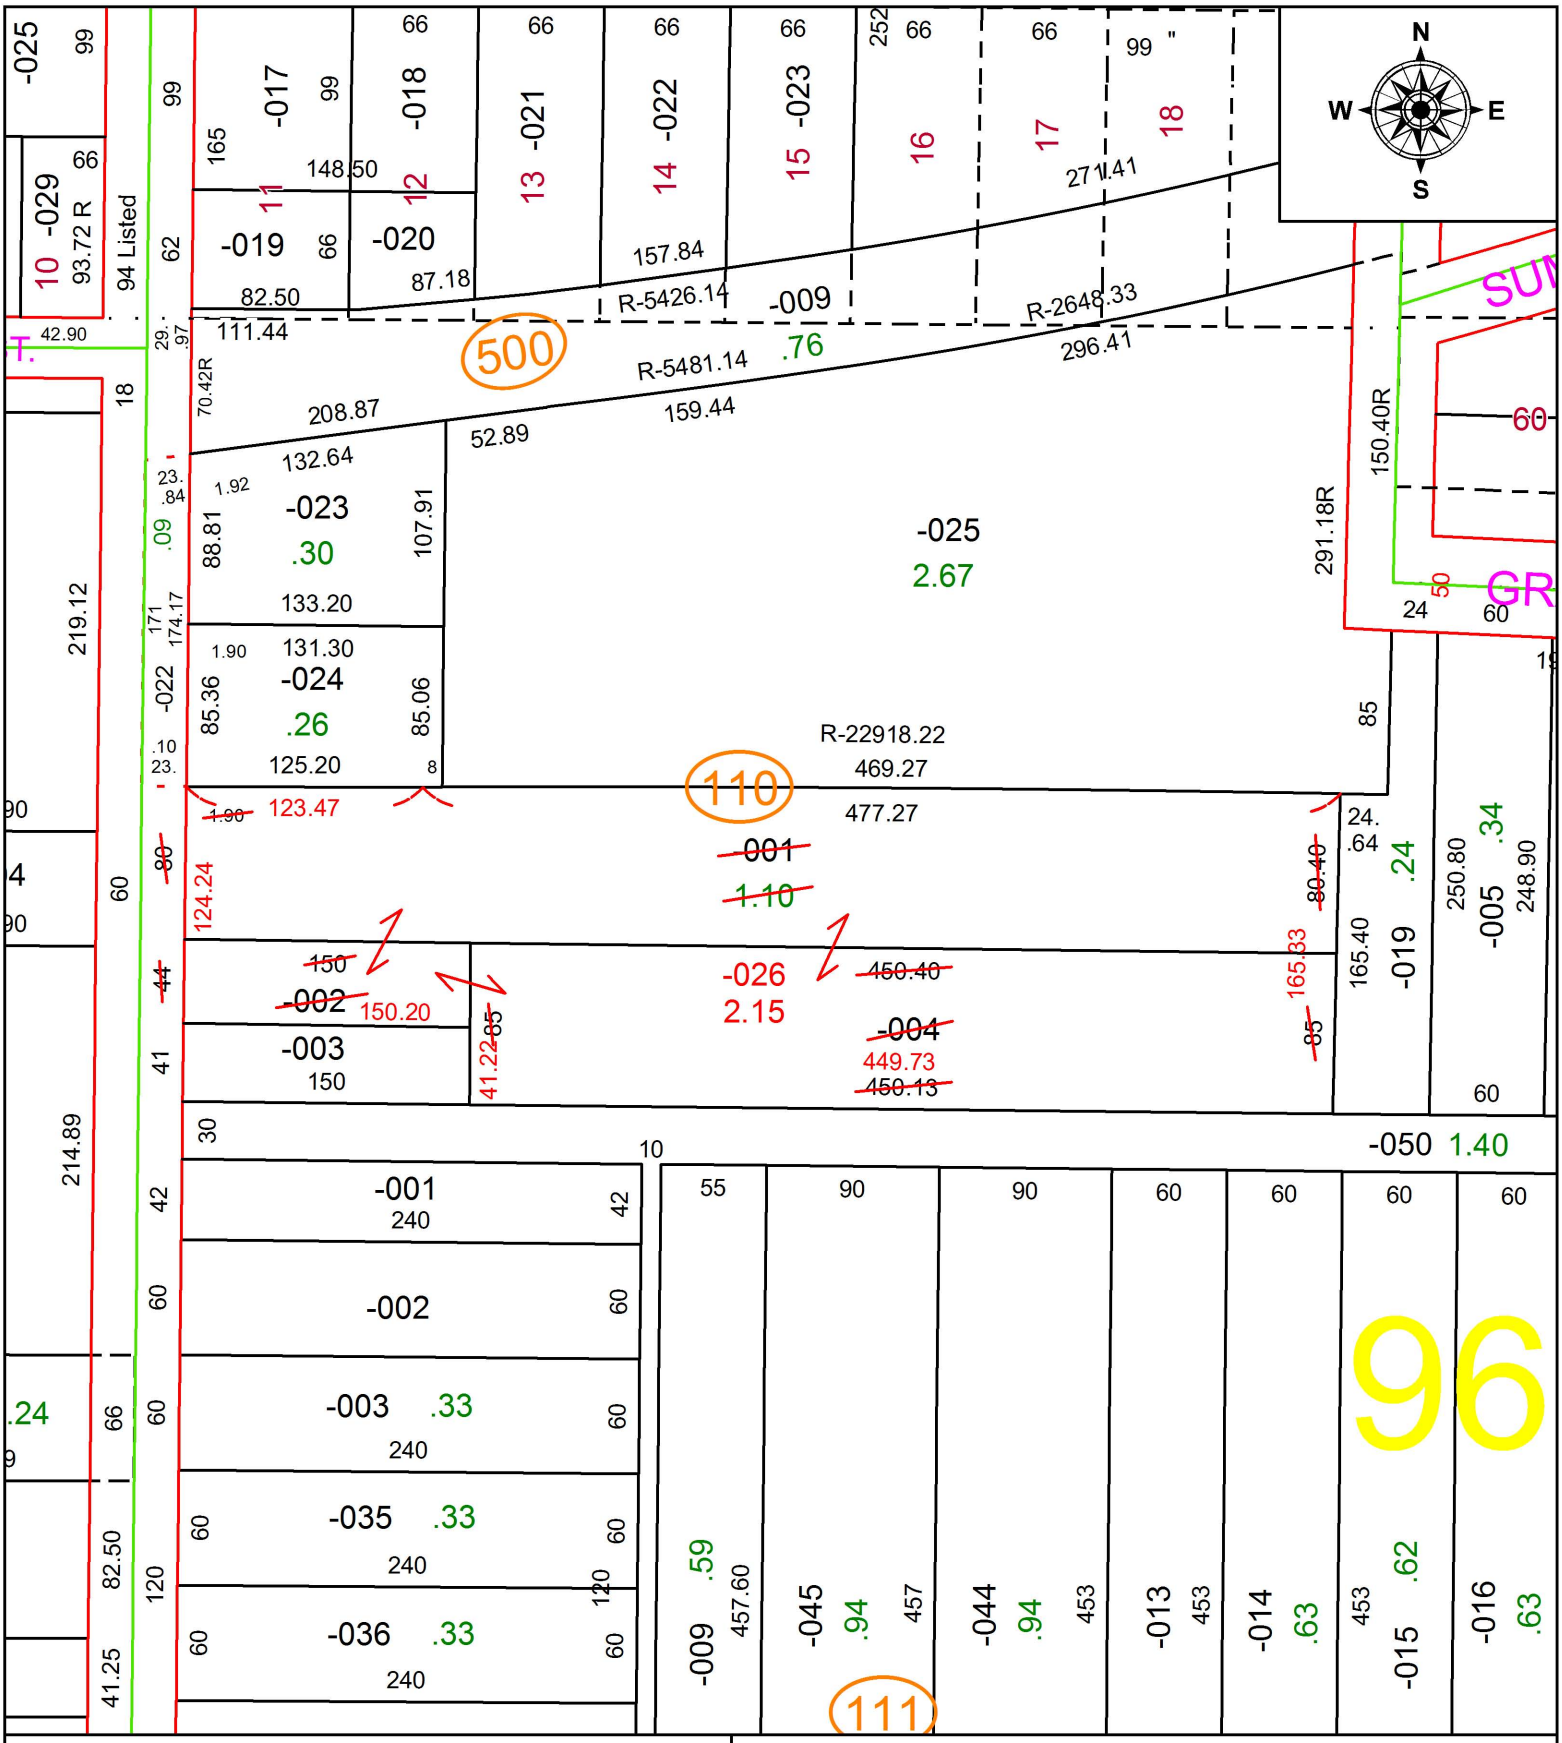

SPLITS/DEEDS PROCESSED

LORAIN COUNTY TAX MAP DEPARTMENT
226 MIDDLE AVE. ELYRIA, OH

SURVEYED BY: JOHN R. ALBAN
CLOSURE: 1: 397,421
MAP PAGE(S): 9-00-096
APPOVED BY: RRM **DATE:** 8-21-18
SCALE: 1" = 100 **PRIOR INSTRUMENT:** 20130443015