PARENT PARCEL: 11-00-098-000-284
CHILD PARCEL: 11-00-098-000-300, -301
STARTING POINT: NORTHEAST CORNER OF S/L 17 IN BARRINGTON PARK SUB. NO.1

18-03863

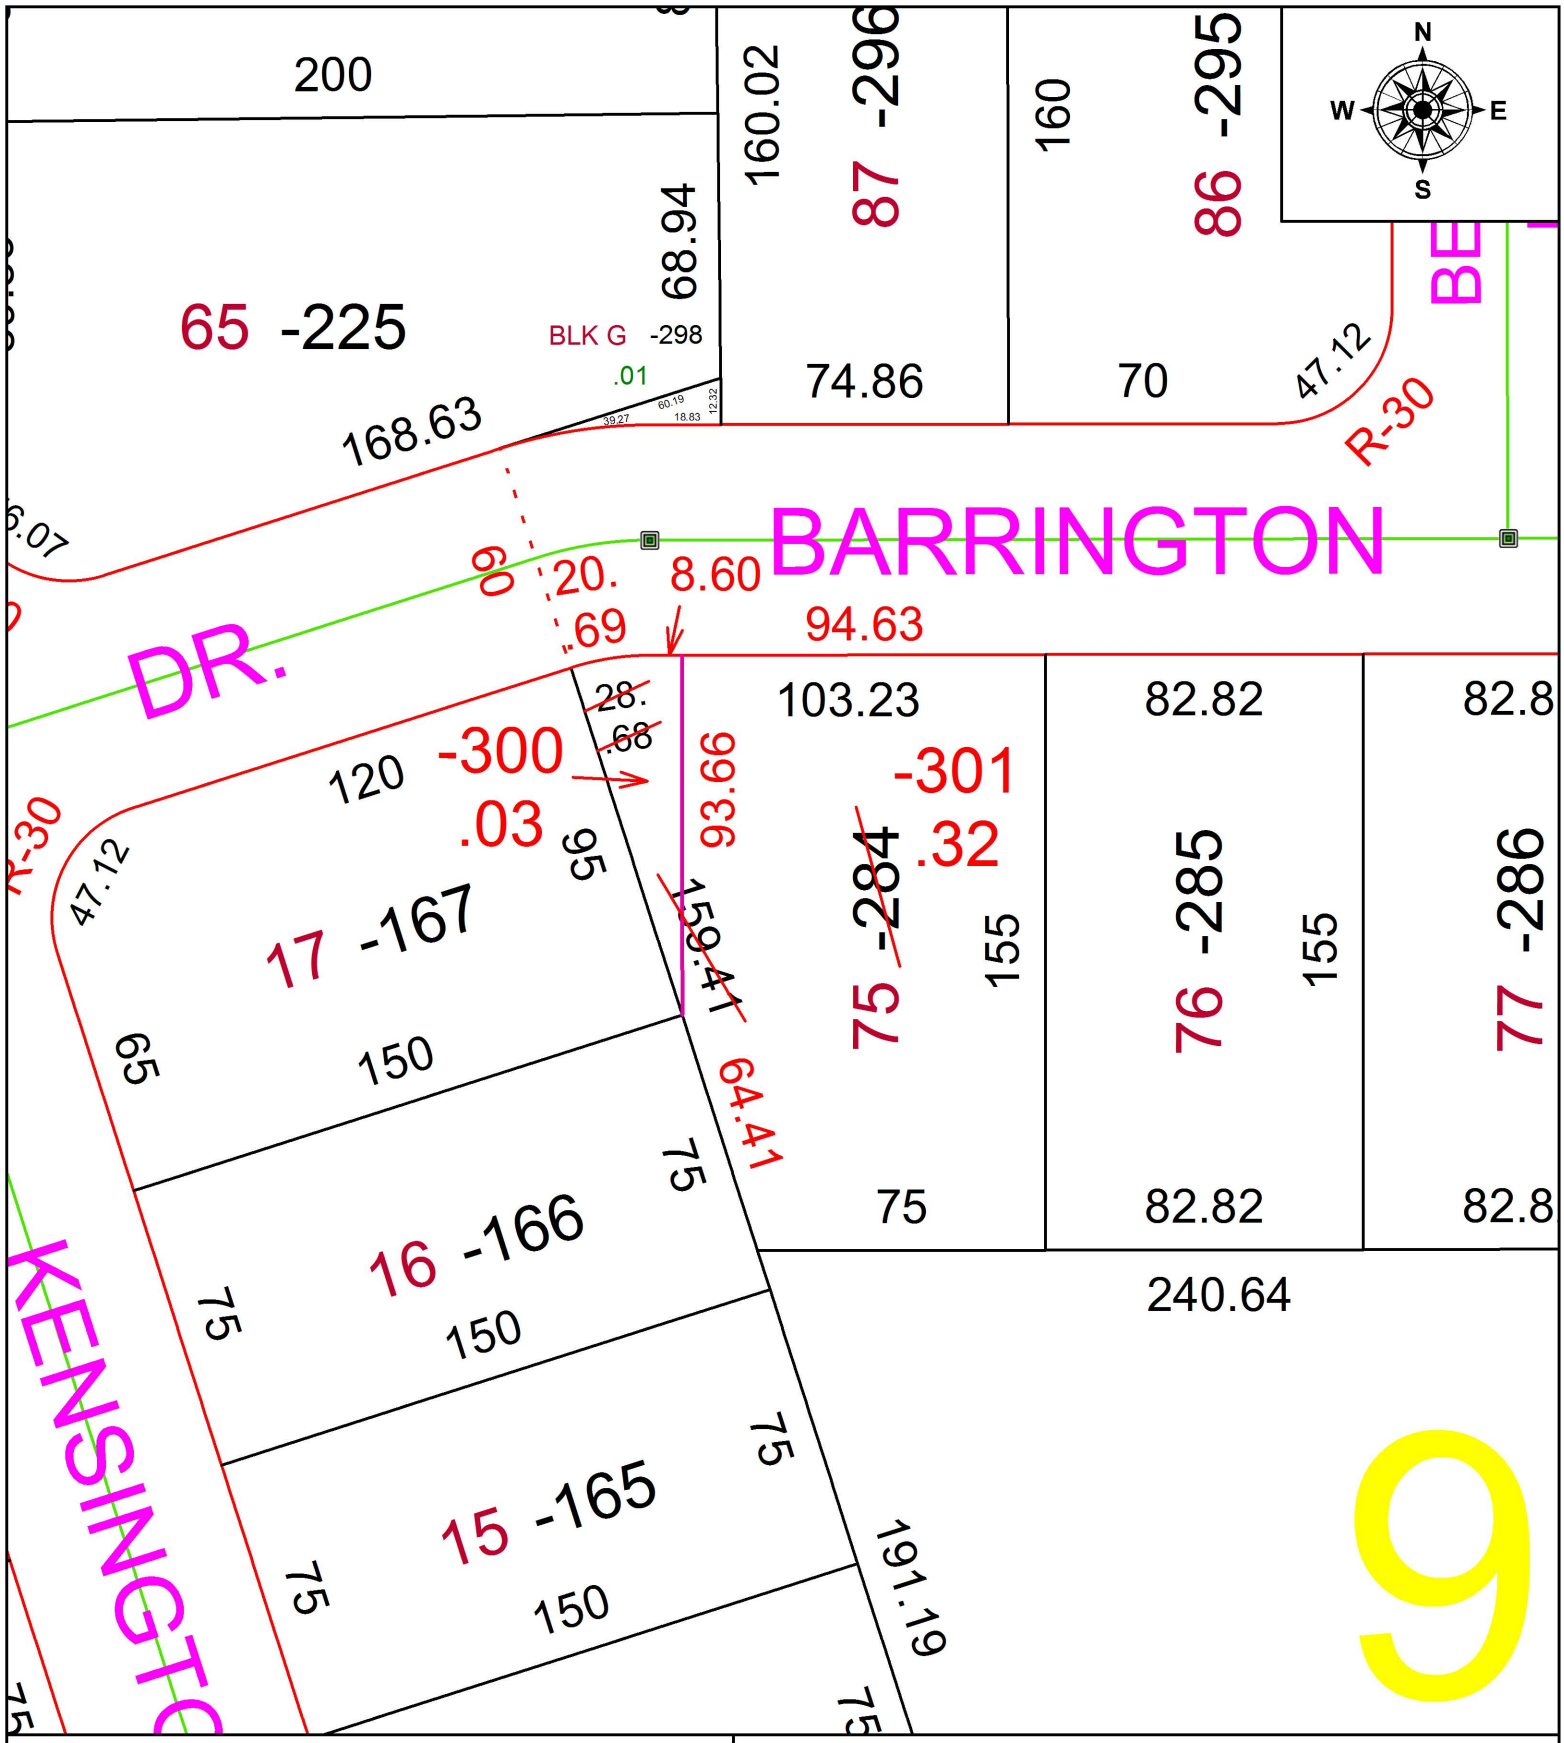

SPLITS/DEEDS PROCESSED
LORAIN COUNTY TAX MAP DEPARTMENT
226 MIDDLE AVE. ELYRIA, OH

SURVEYED BY: THOMAS A. SIMON
CLOSURE: 1: 55,215
MAP PAGE(S): 11-00-098
APPOVED BY: RRM **DATE:** 8-27-18
SCALE: 1" = 50 **PRIOR INSTRUMENT:** 20180669607