PARENT PARCEL: 03-00-020-000-027

CHILD PARCEL: XX-XX-XXX-XXX-XXX

STARTING POINT: INTERSECTION OF C/L OF ABBE RD. AND C/L OF OSTER RD,

18-03866-A

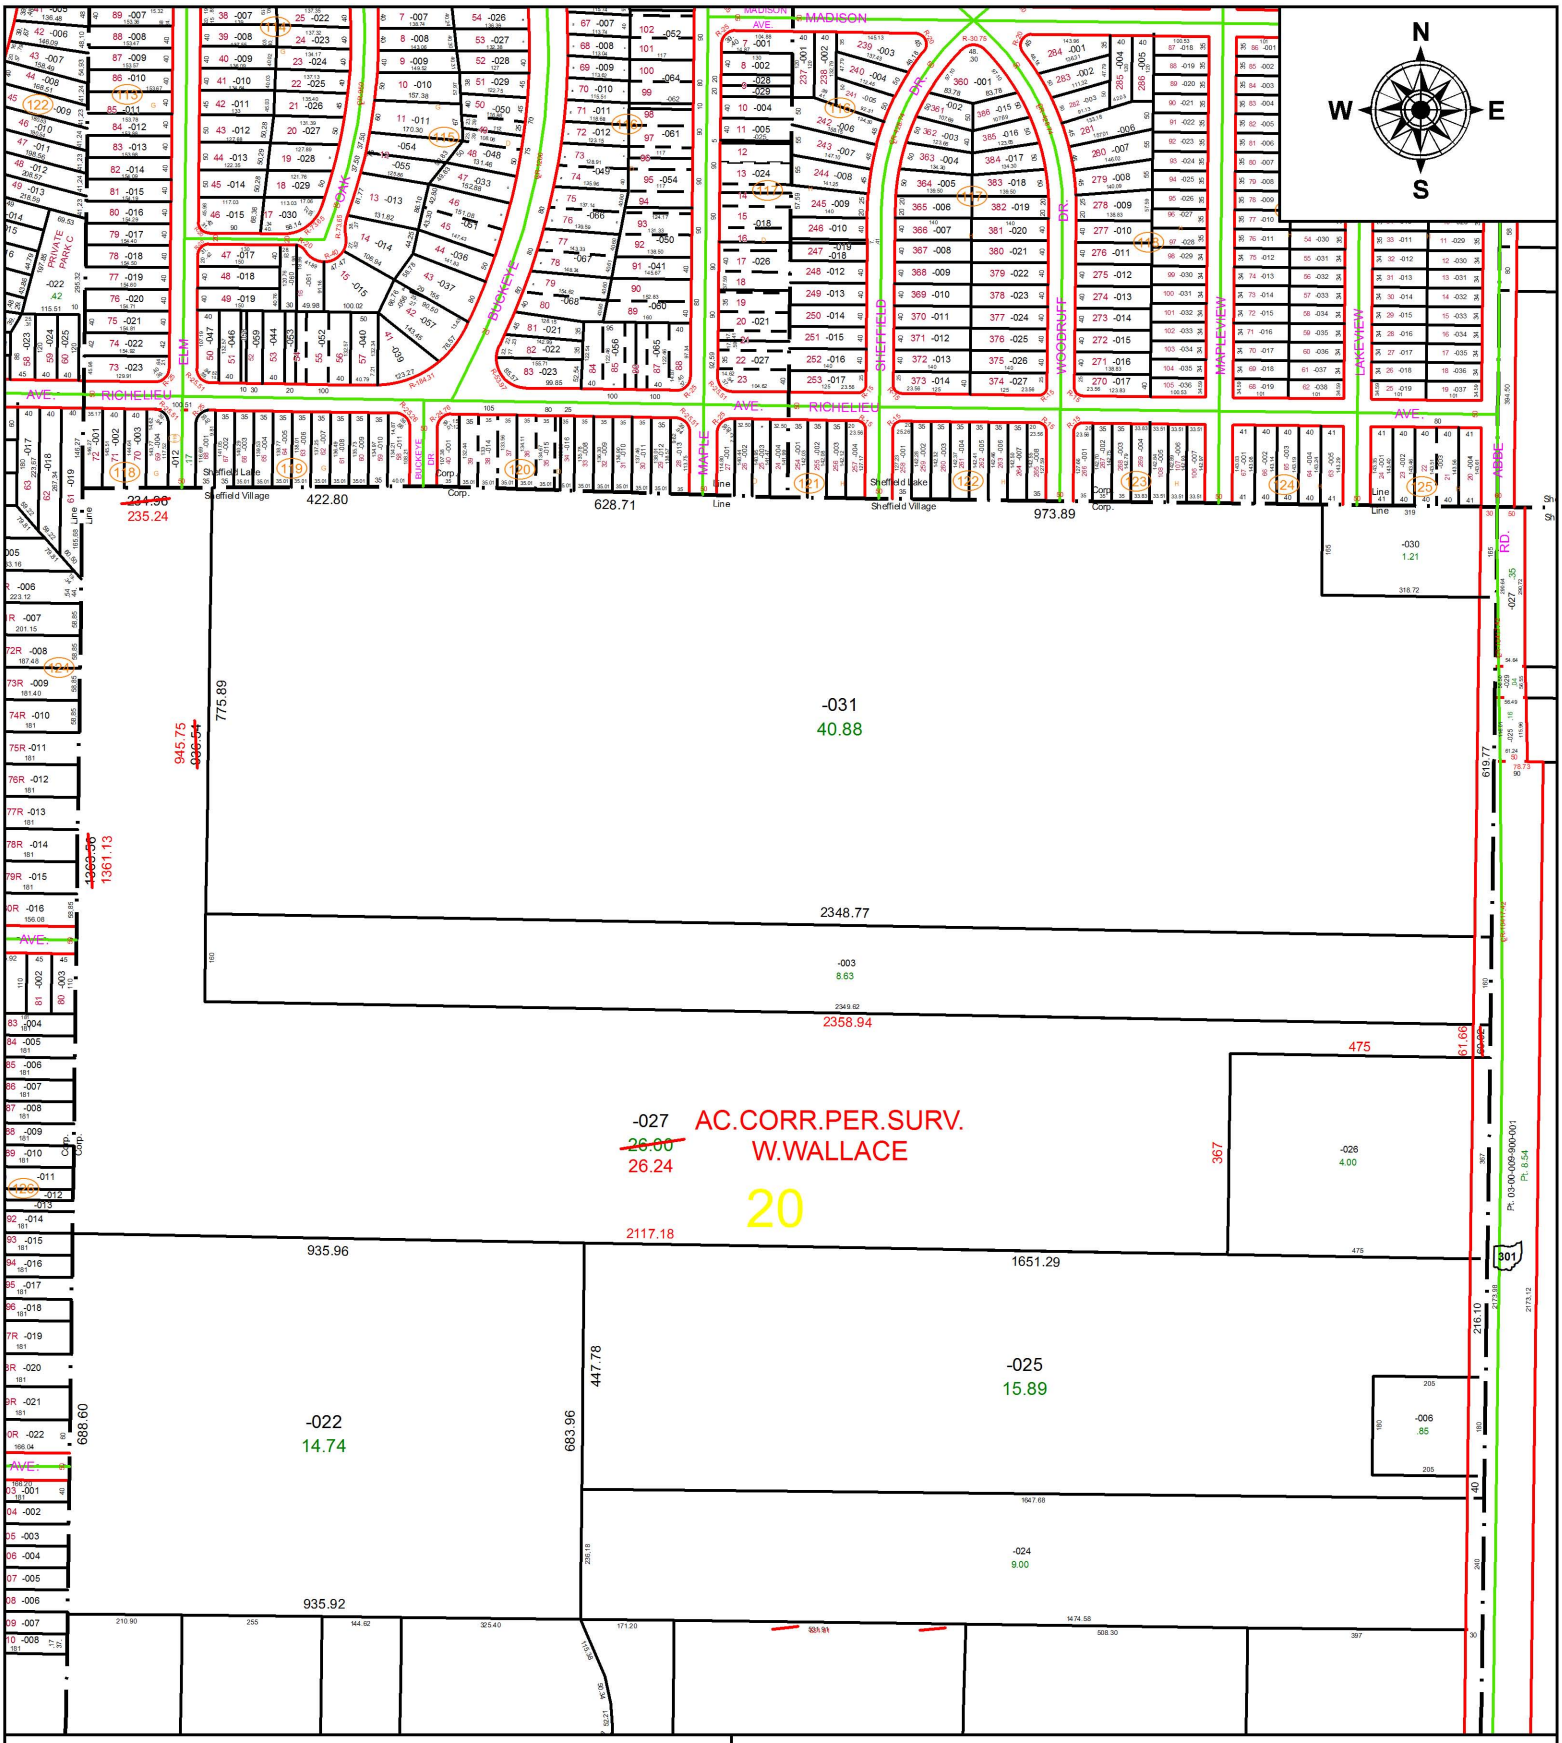

SPLITS/DEEDS PROCESSED

LORAIN COUNTY TAX MAP DEPARTMENT
226 MIDDLE AVE. ELYRIA, OH

SURVEYED BY: WILLIAM R. WALLACE

CLOSURE: 1: 3,177,434

MAP PAGE(S): 3-00-020

APPOVED BY: RRM **DATE:** 3-22-18

SCALE: 1" = 350 **PRIOR INSTRUMENT:** 20160607778