PARENT PARCEL: 05-00-060-105-012

CHILD PARCEL: XX-XX-XXX-XXX-XXX

STARTING POINT: INTERSECTION OF C/L OF NORTH RIDGE RD. AND C/L OF OBERLIN RD.

18-03869-A

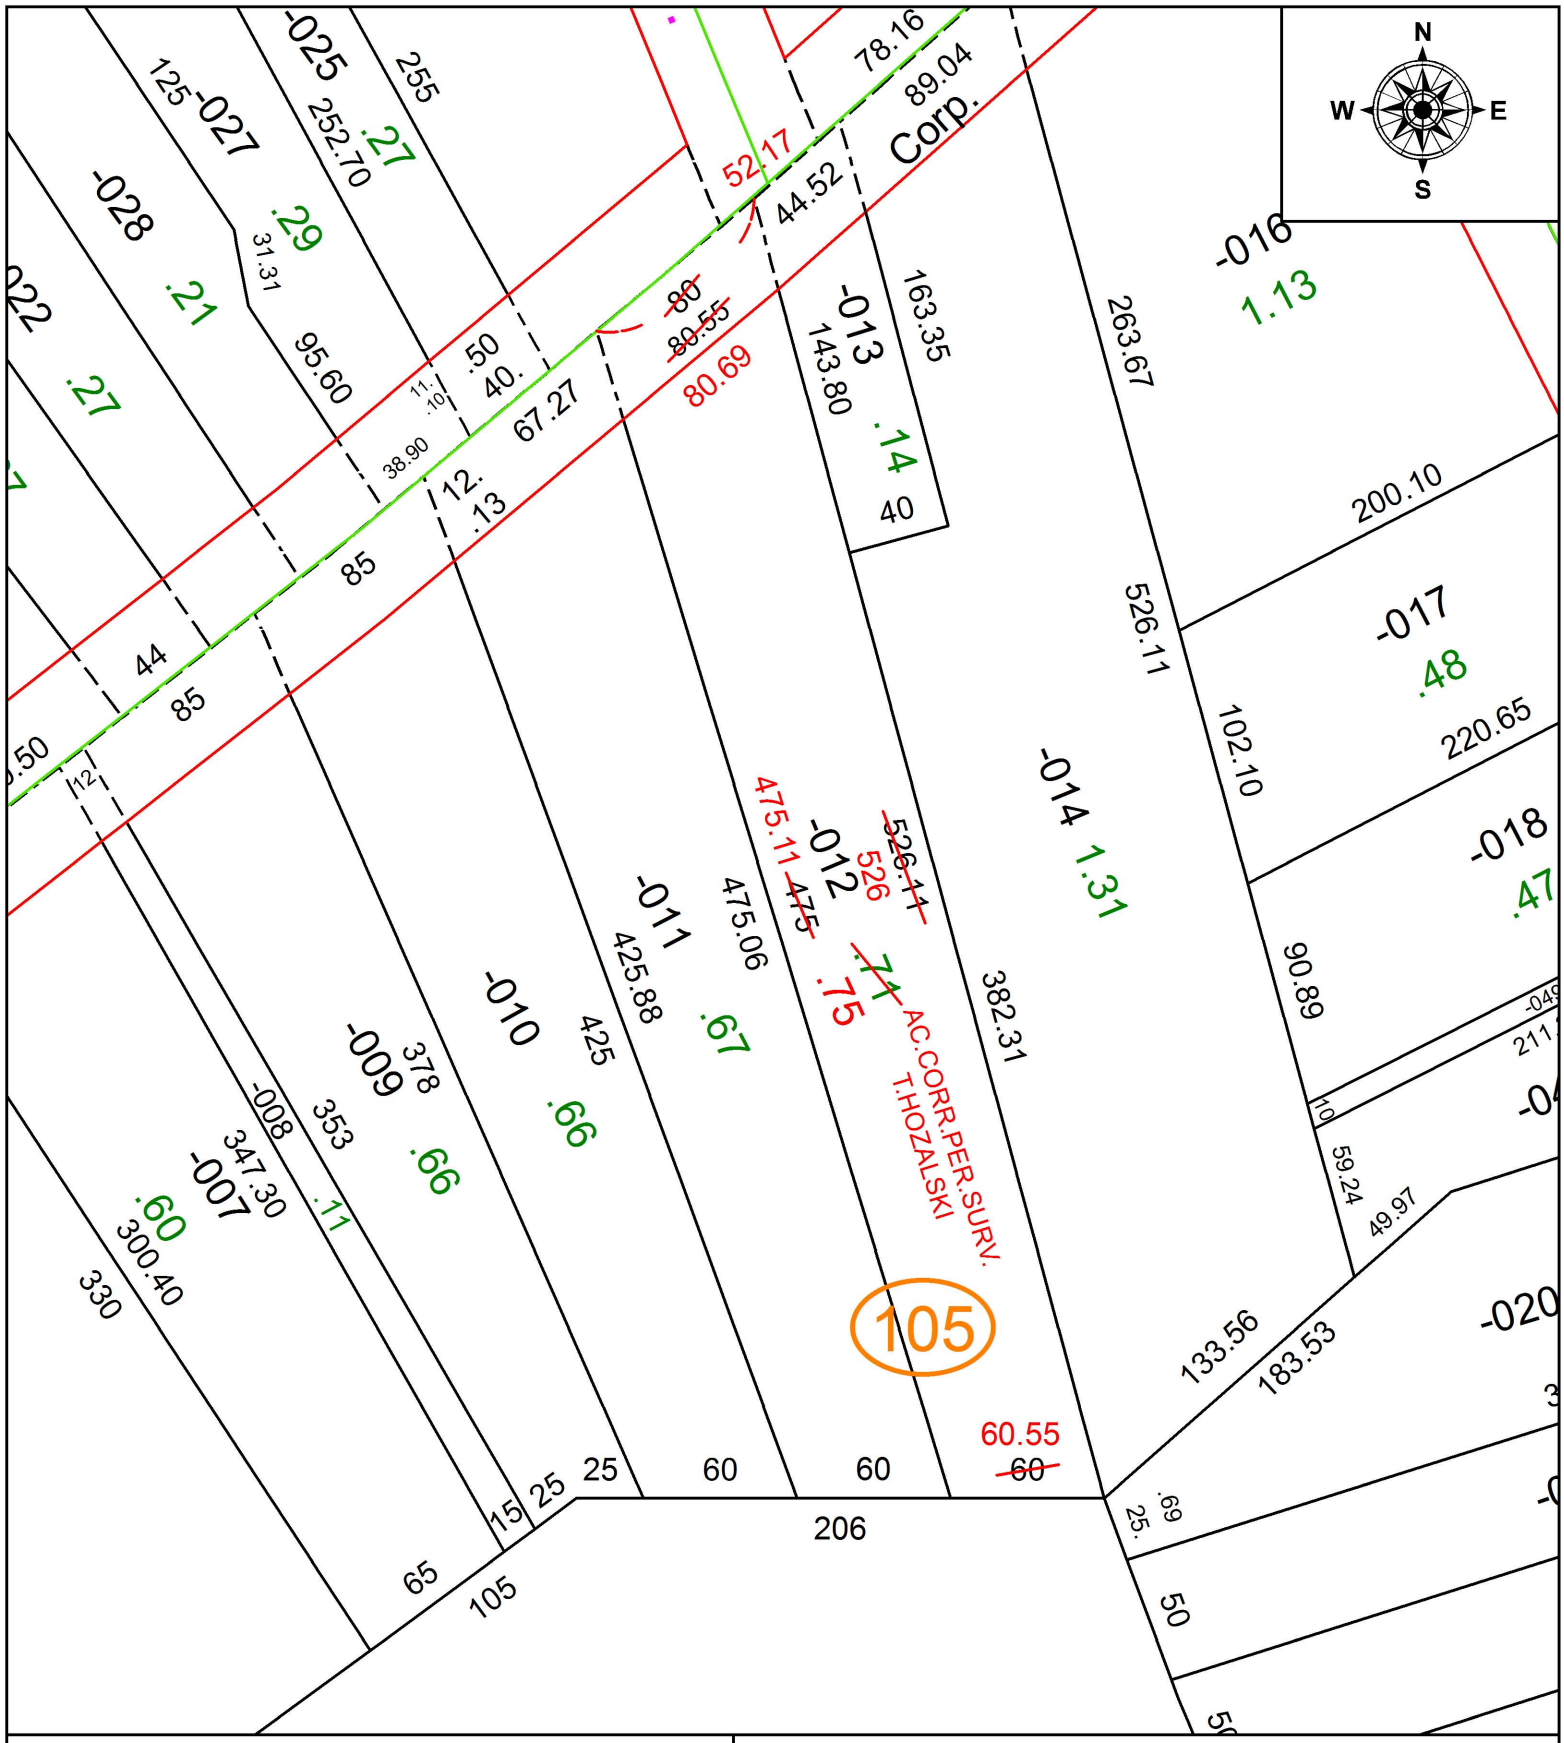

SPLITS/DEEDS PROCESSED

LORAIN COUNTY TAX MAP DEPARTMENT
226 MIDDLE AVE. ELYRIA, OH

SURVEYED BY: TIMOTHY D. HOZALSKI
CLOSURE: 1: 145,096
MAP PAGE(S): 5-00-060
APPOVED BY: RRM **DATE:** 3-29-18
SCALE: 1" = 75 **PRIOR INSTRUMENT:** DV 1000/439