PARENT PARCEL: 06-24-089-000-009

CHILD PARCEL: 06-24-089-000-017 & -018

STARTING POINT: INT. OF NORTH LINE OF LOWELL ST. & WEST LINE OF GATEWAY BLVD.

18-03871-U

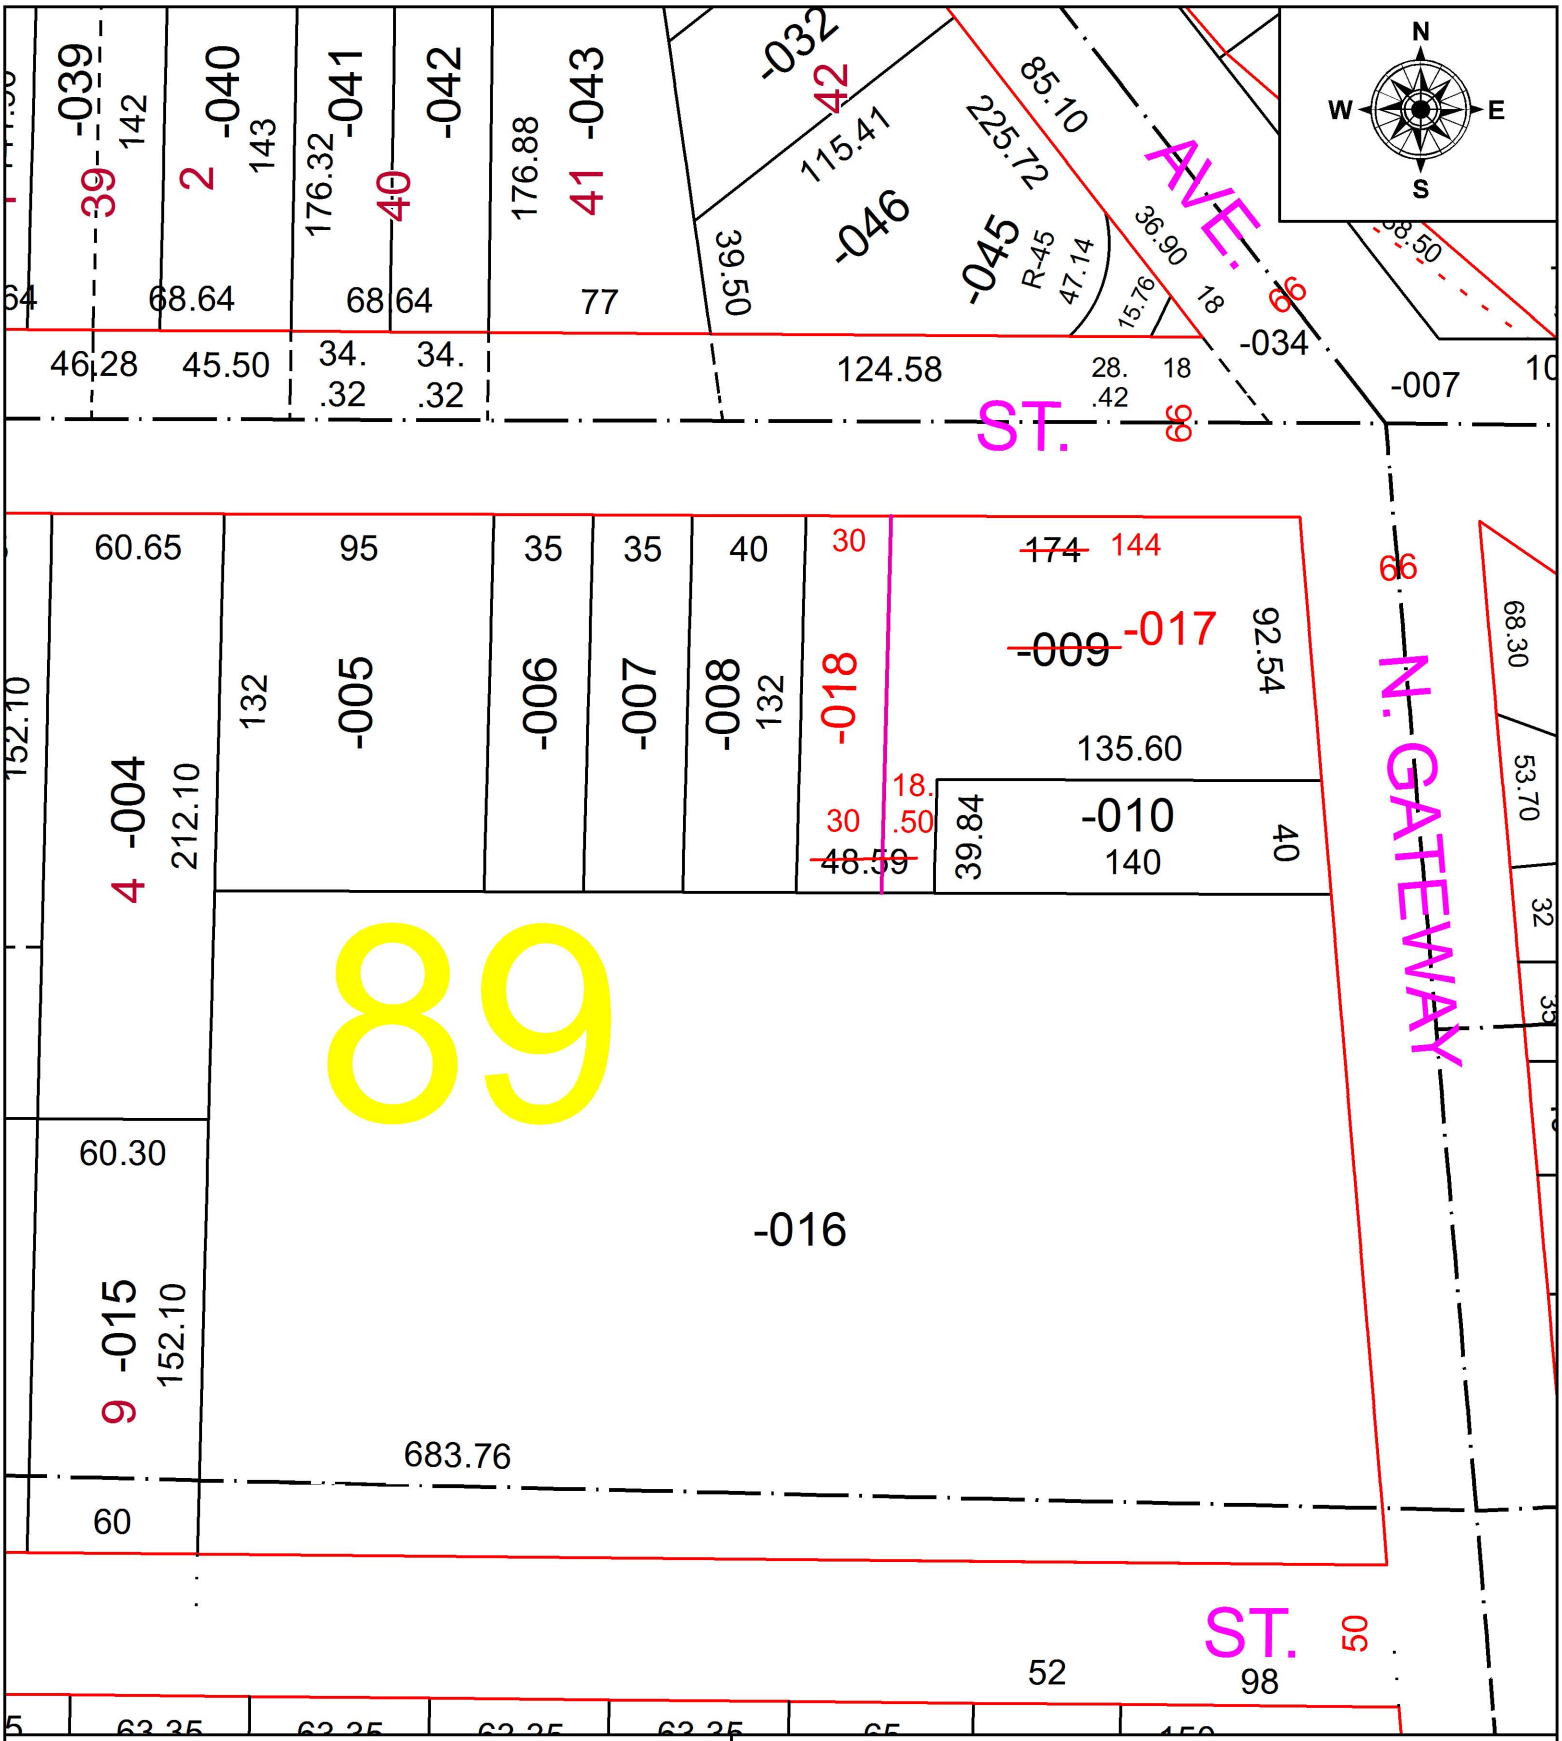

SPLITS/DEEDS PROCESSED

LORAIN COUNTY TAX MAP DEPARTMENT
226 MIDDLE AVE. ELYRIA, OH

SURVEYED BY: J. W. WARDEN
CLOSURE: 1: 33,000
MAP PAGE(S): 06-24-089
APPOVED BY: TJS **DATE:** 4/11/18
SCALE: 1" = 200 **PRIOR INSTRUMENT:** 2015-0556663