PARENT PARCEL: 09-00-033-000-013, 09-00-034-000-001, -007

CHILD PARCEL: 09-00-033-000-013, 09-00-034-000-011 THRU -013

STARTING POINT: NORTHEAST CORNER OF O.L.33

18-03872-D

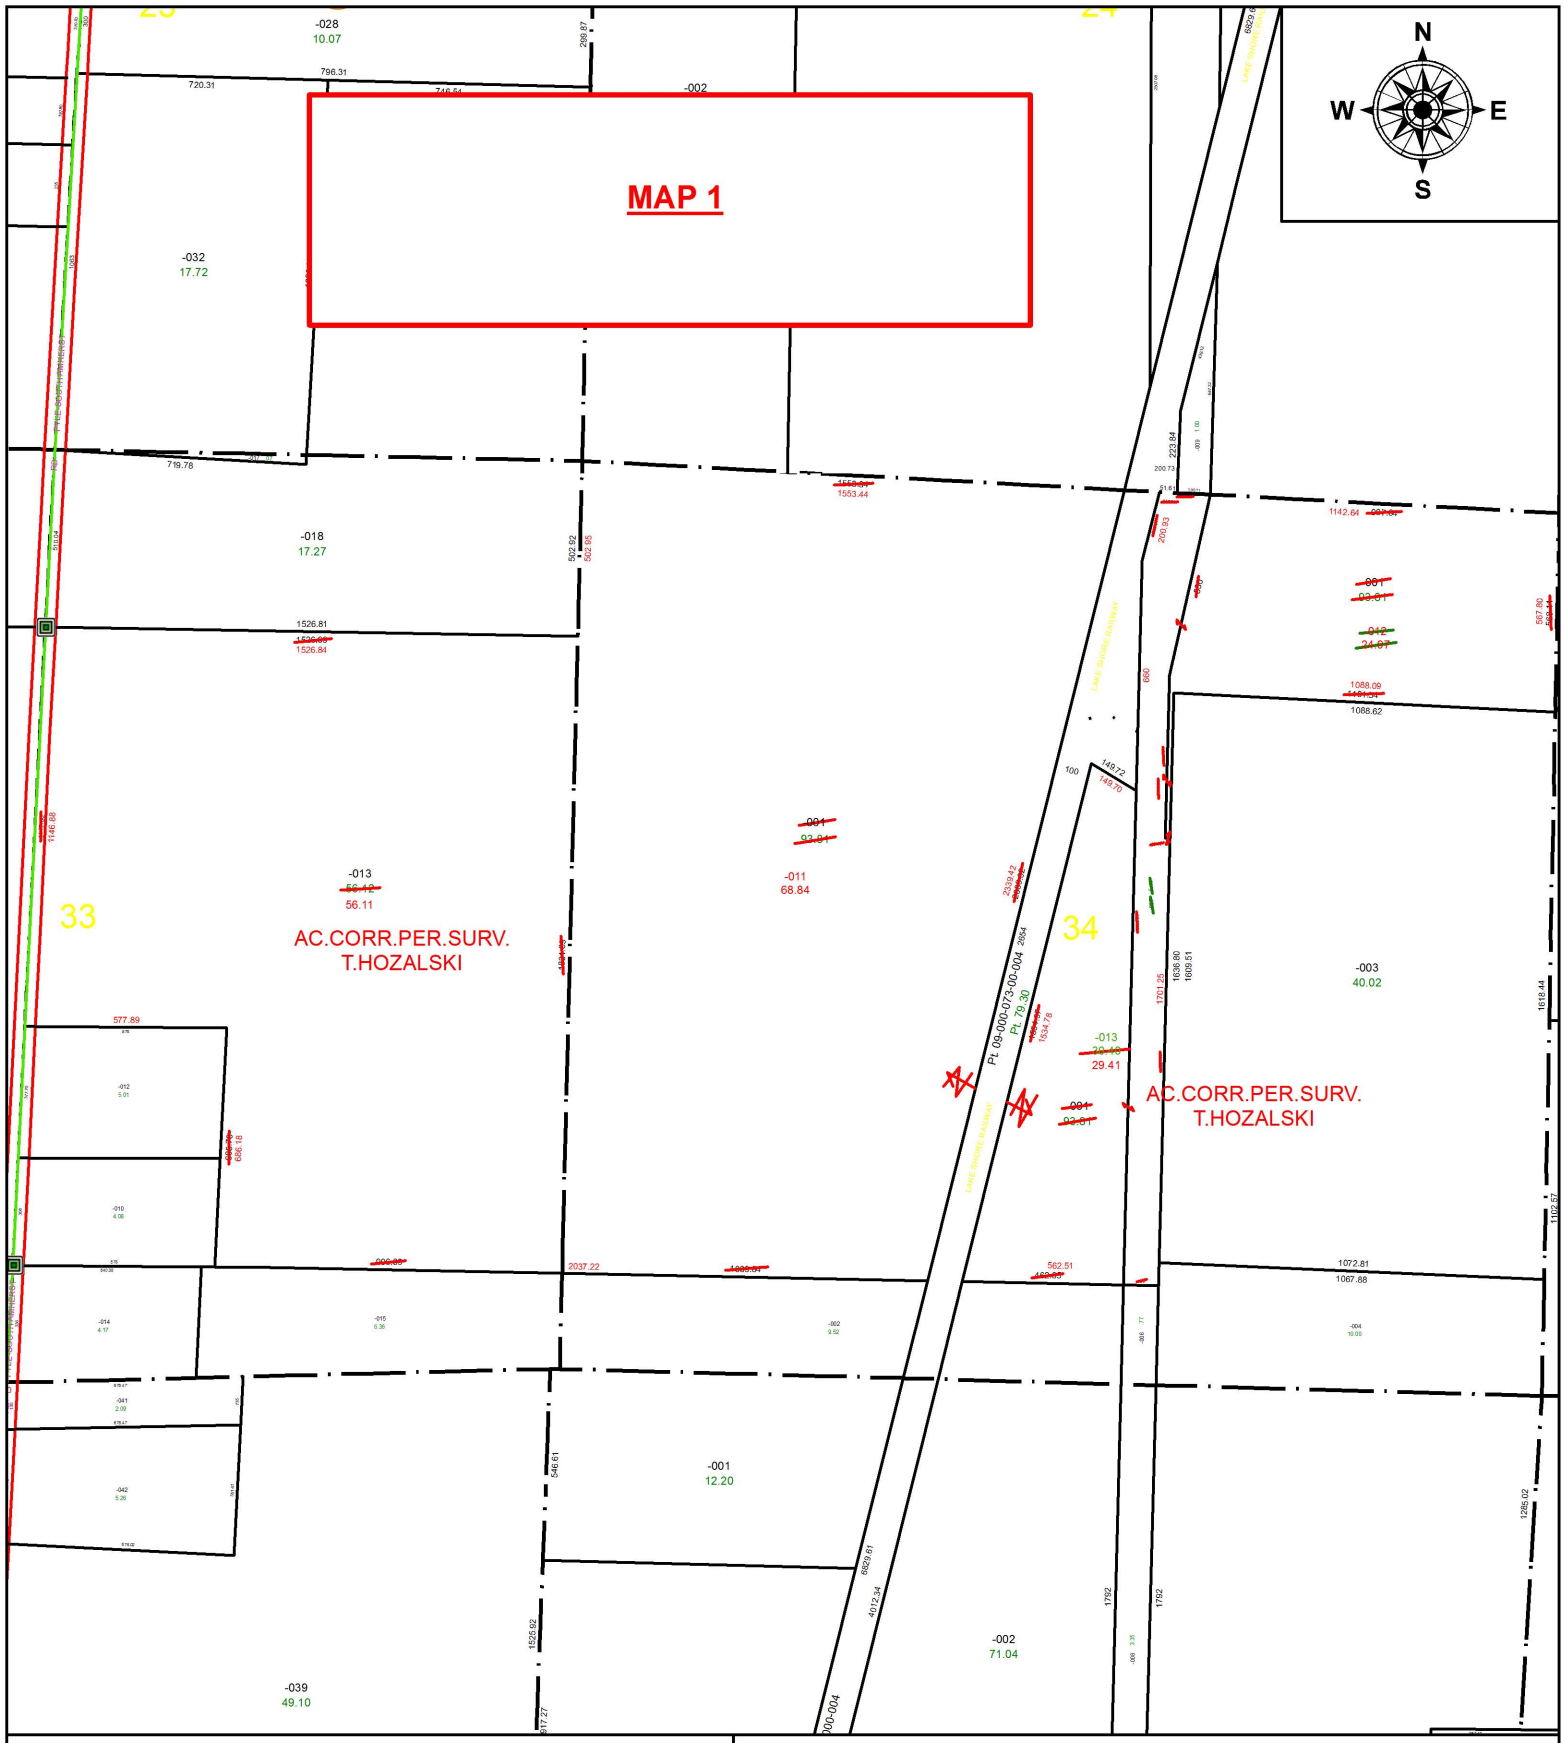

SPLITS/DEEDS PROCESSED

LORAIN COUNTY TAX MAP DEPARTMENT
226 MIDDLE AVE. ELYRIA, OH

SURVEYED BY: TIMOTHY D. HOZALSKI
CLOSURE: 1: 1,345,688
MAP PAGE(S): 9-00-033
APPOVED BY: RRM **DATE:** 4-16-18
SCALE: 1" = 550 **PRIOR INSTRUMENT:** 20120439998