PARENT PARCEL: 14-00-147-000-011, 14-00-146-000-001

CHILD PARCEL: 14-00-147-000-012 THRU -015, 14-00-146-000-001

STARTING POINT: INTERSECTION OF C/L OF MERRIAM RD. AND C/L OF PITTS RD.

18-03875

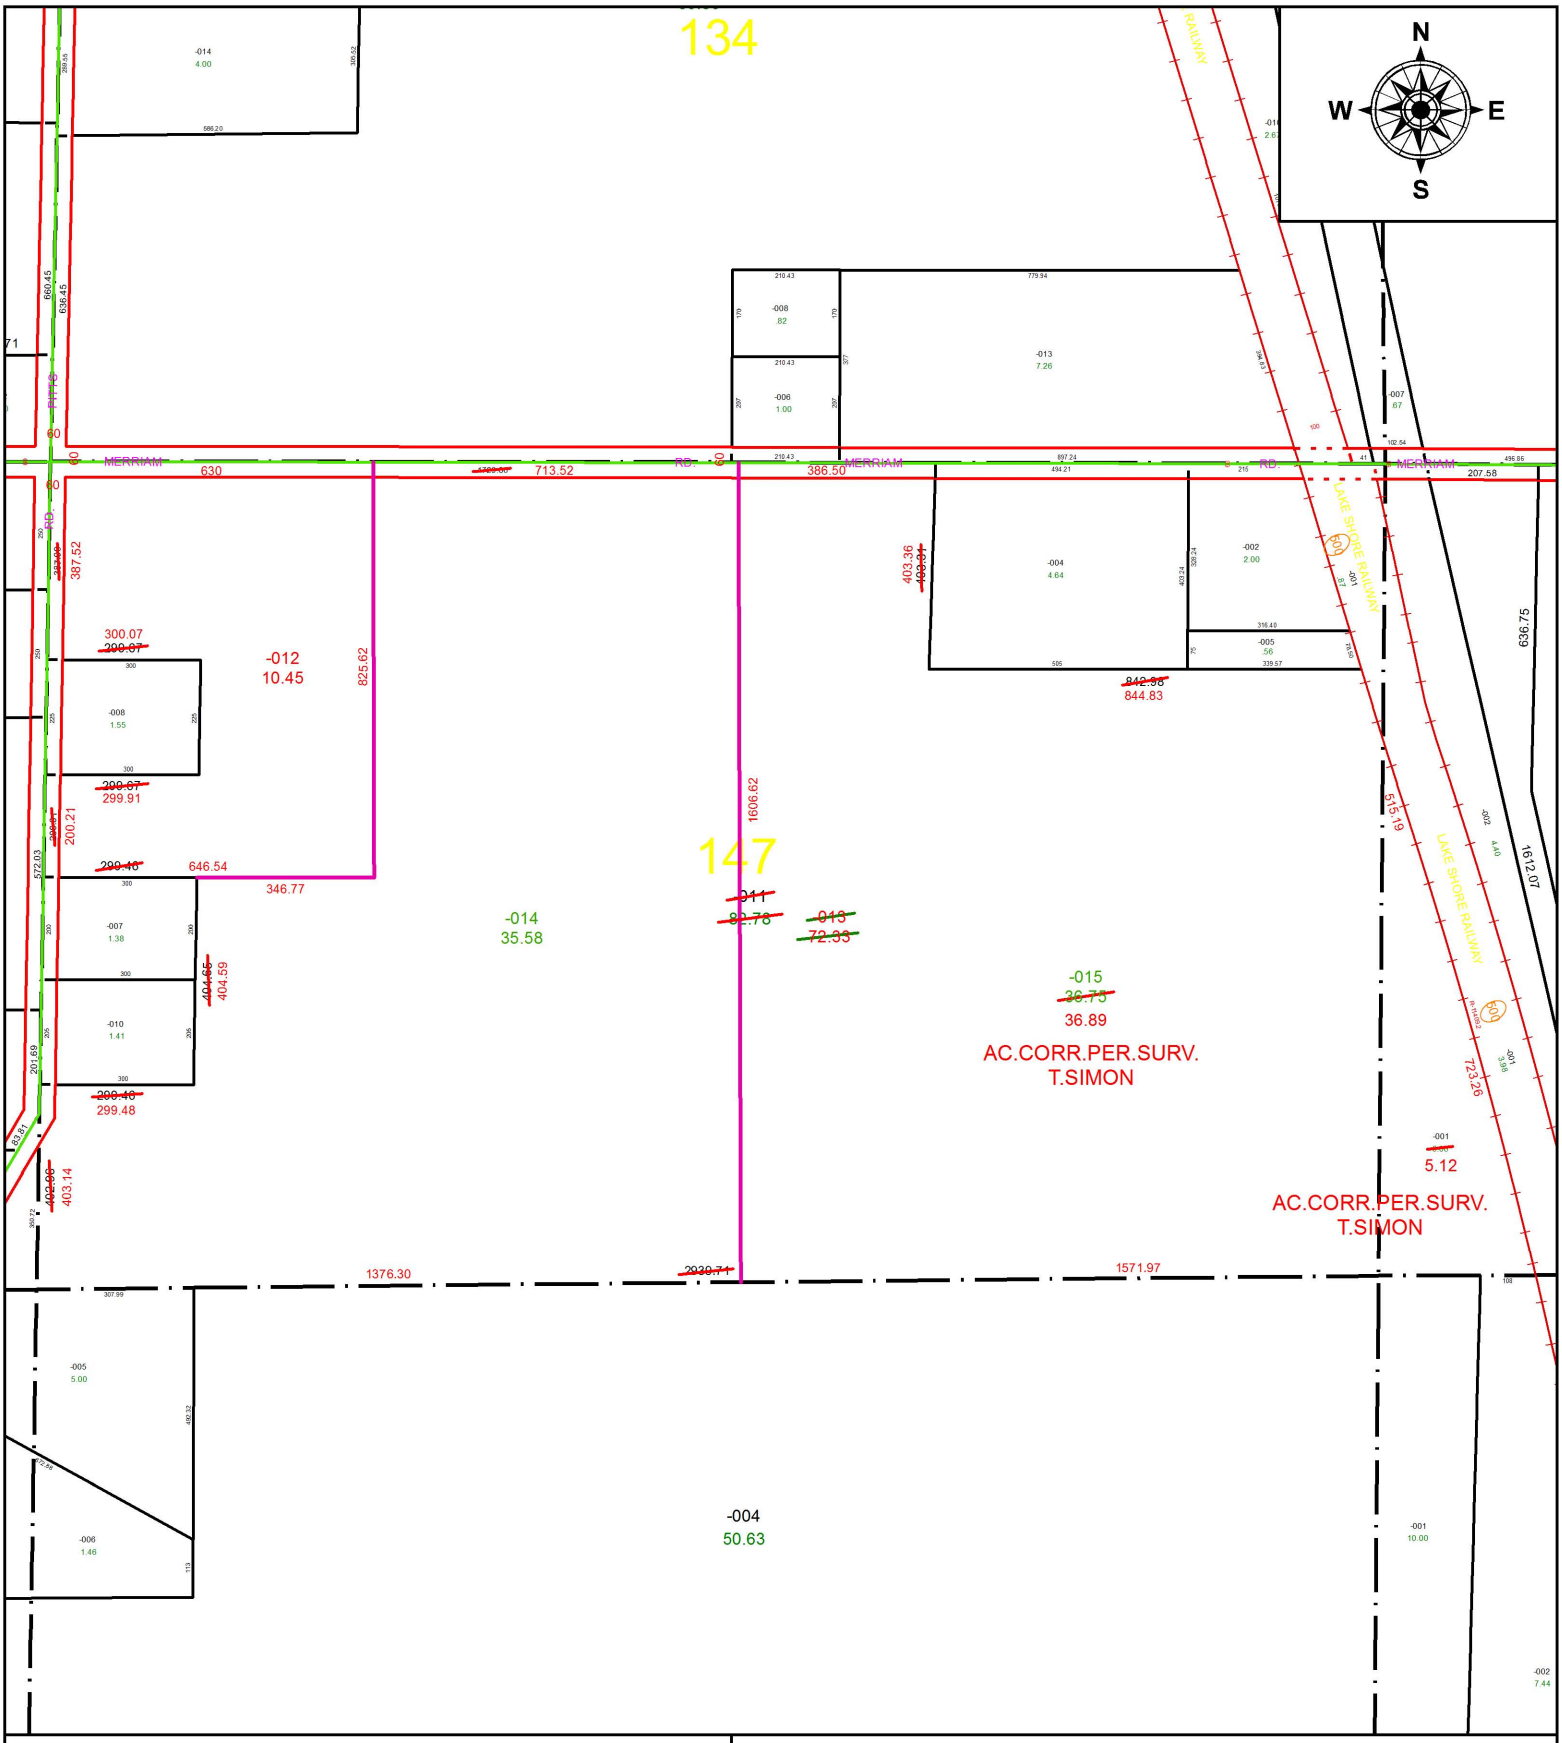

SPLITS/DEEDS PROCESSED

LORAIN COUNTY TAX MAP DEPARTMENT
226 MIDDLE AVE. ELYRIA, OH

SURVEYED BY: THOMAS A. SIMON
CLOSURE: 1: 46,988
MAP PAGE(S): 14-F
APPOVED BY: RRM **DATE:** 9-20-18
SCALE: 1" = 375 **PRIOR INSTRUMENT:** 20100359368