PARENT PARCEL: 07-00-011-103-011, -089

CHILD PARCEL: 07-00-011-103-190 THRU -192, 07-00-014-106-010, -011

STARTING POINT: INTERSECTION OF C/L OF LORAIN RD. AND C/L OF ROOT RD.

18-03876

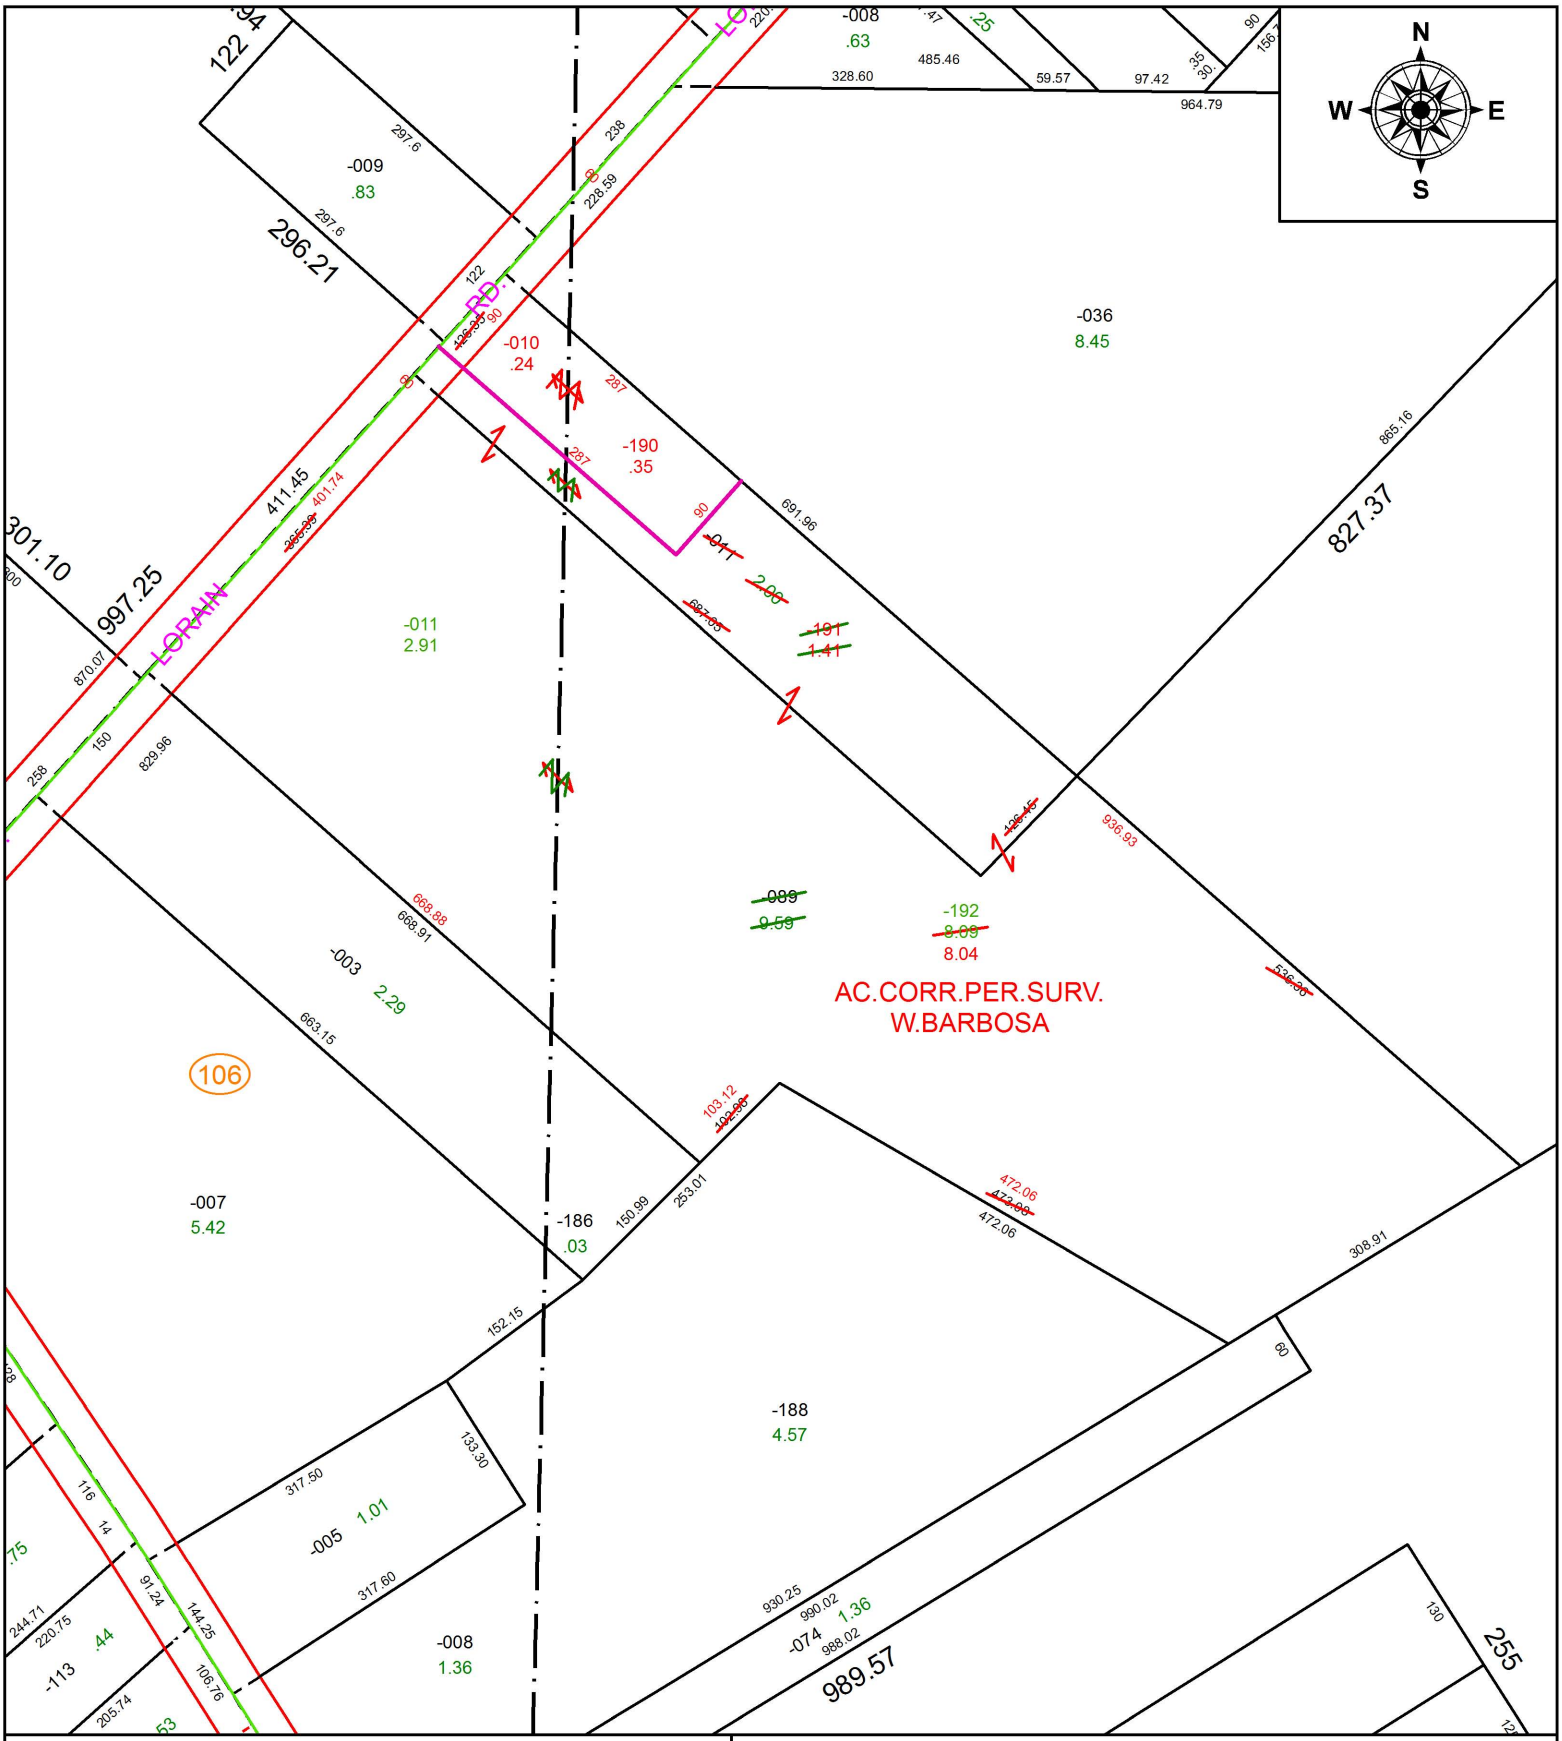

SPLITS/DEEDS PROCESSED

LORAIN COUNTY TAX MAP DEPARTMENT
226 MIDDLE AVE. ELYRIA, OH

SURVEYED BY: WILFREDO BARBOSA
CLOSURE: 1: 282,670
MAP PAGE(S): 7-00-011
APPOVED BY: RRM **DATE:** 9-24-18
SCALE: 1" = 175 **PRIOR INSTRUMENT:** 20120416221