PARENT PARCEL: 01-00-027-000-074, -075

CHILD PARCEL: 01-00-027-000-084, -085

STARTING POINT: INTERSECTION OF C/L OF BAUMHART RD. AND C/L OF COOPER FOSTER PARK RD.

18-03879

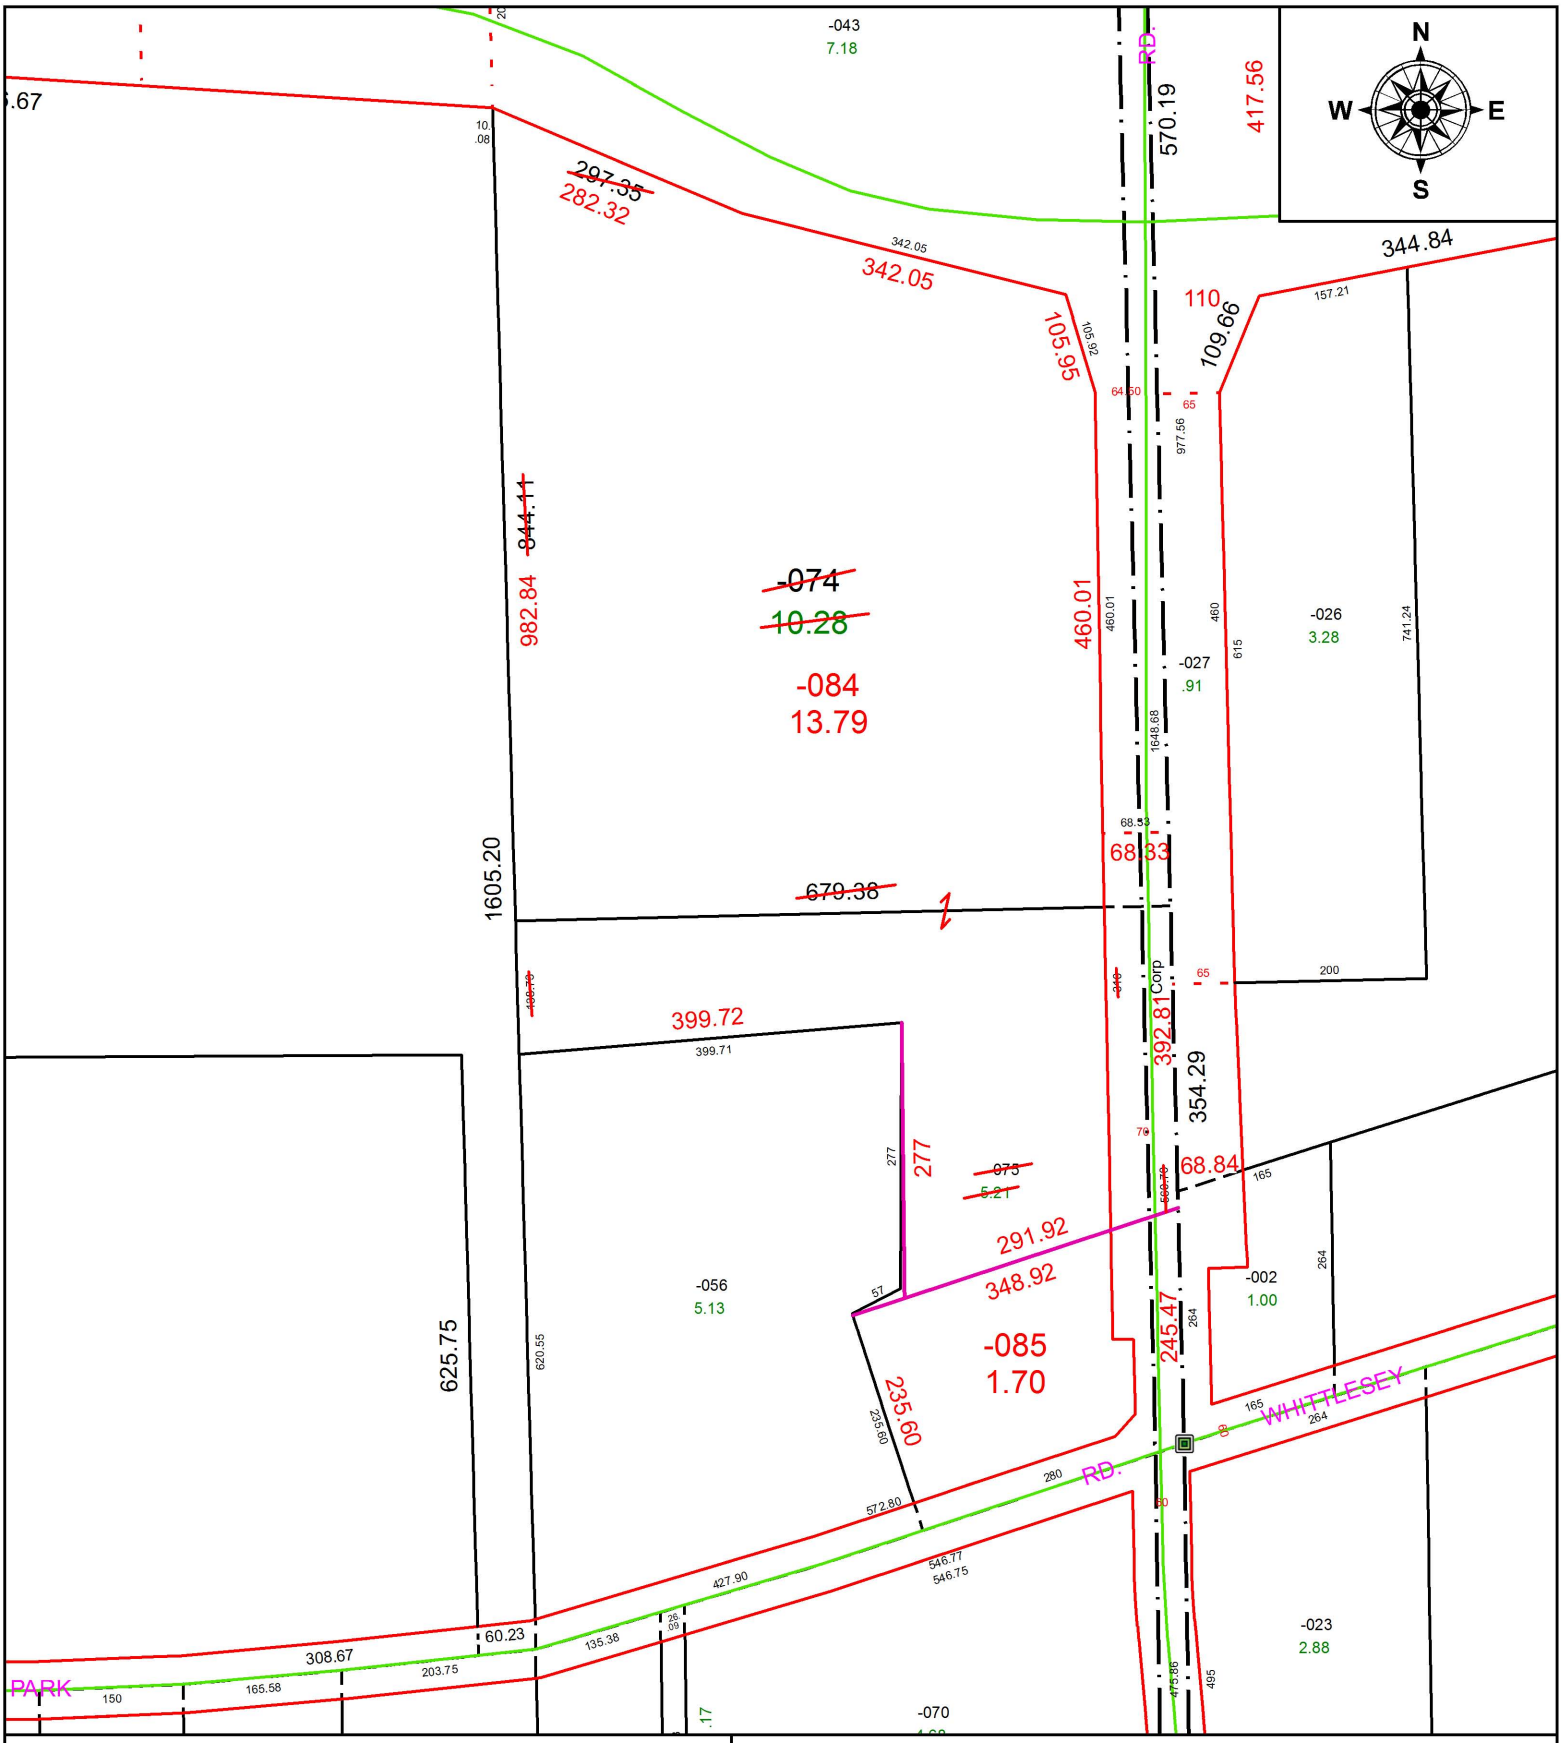

SPLITS/DEEDS PROCESSED

LORAIN COUNTY TAX MAP DEPARTMENT
226 MIDDLE AVE. ELYRIA, OH

SURVEYED BY: PATRICK A. MCGANNON

CLOSURE: 1: 300,903

MAP PAGE(S): 1-00-027

APPOVED BY: RRM **DATE:** 9-28-18

SCALE: 1" = 200 **PRIOR INSTRUMENT:** 20170617267