PARENT PARCEL: 02-03-001-101-008, -009

CHILD PARCEL: 02-03-001-101-010

STARTING POINT: INTERSECTION OF C/L OF KOLBE RD. AND C/L OF US RT. 6

18-03880-D

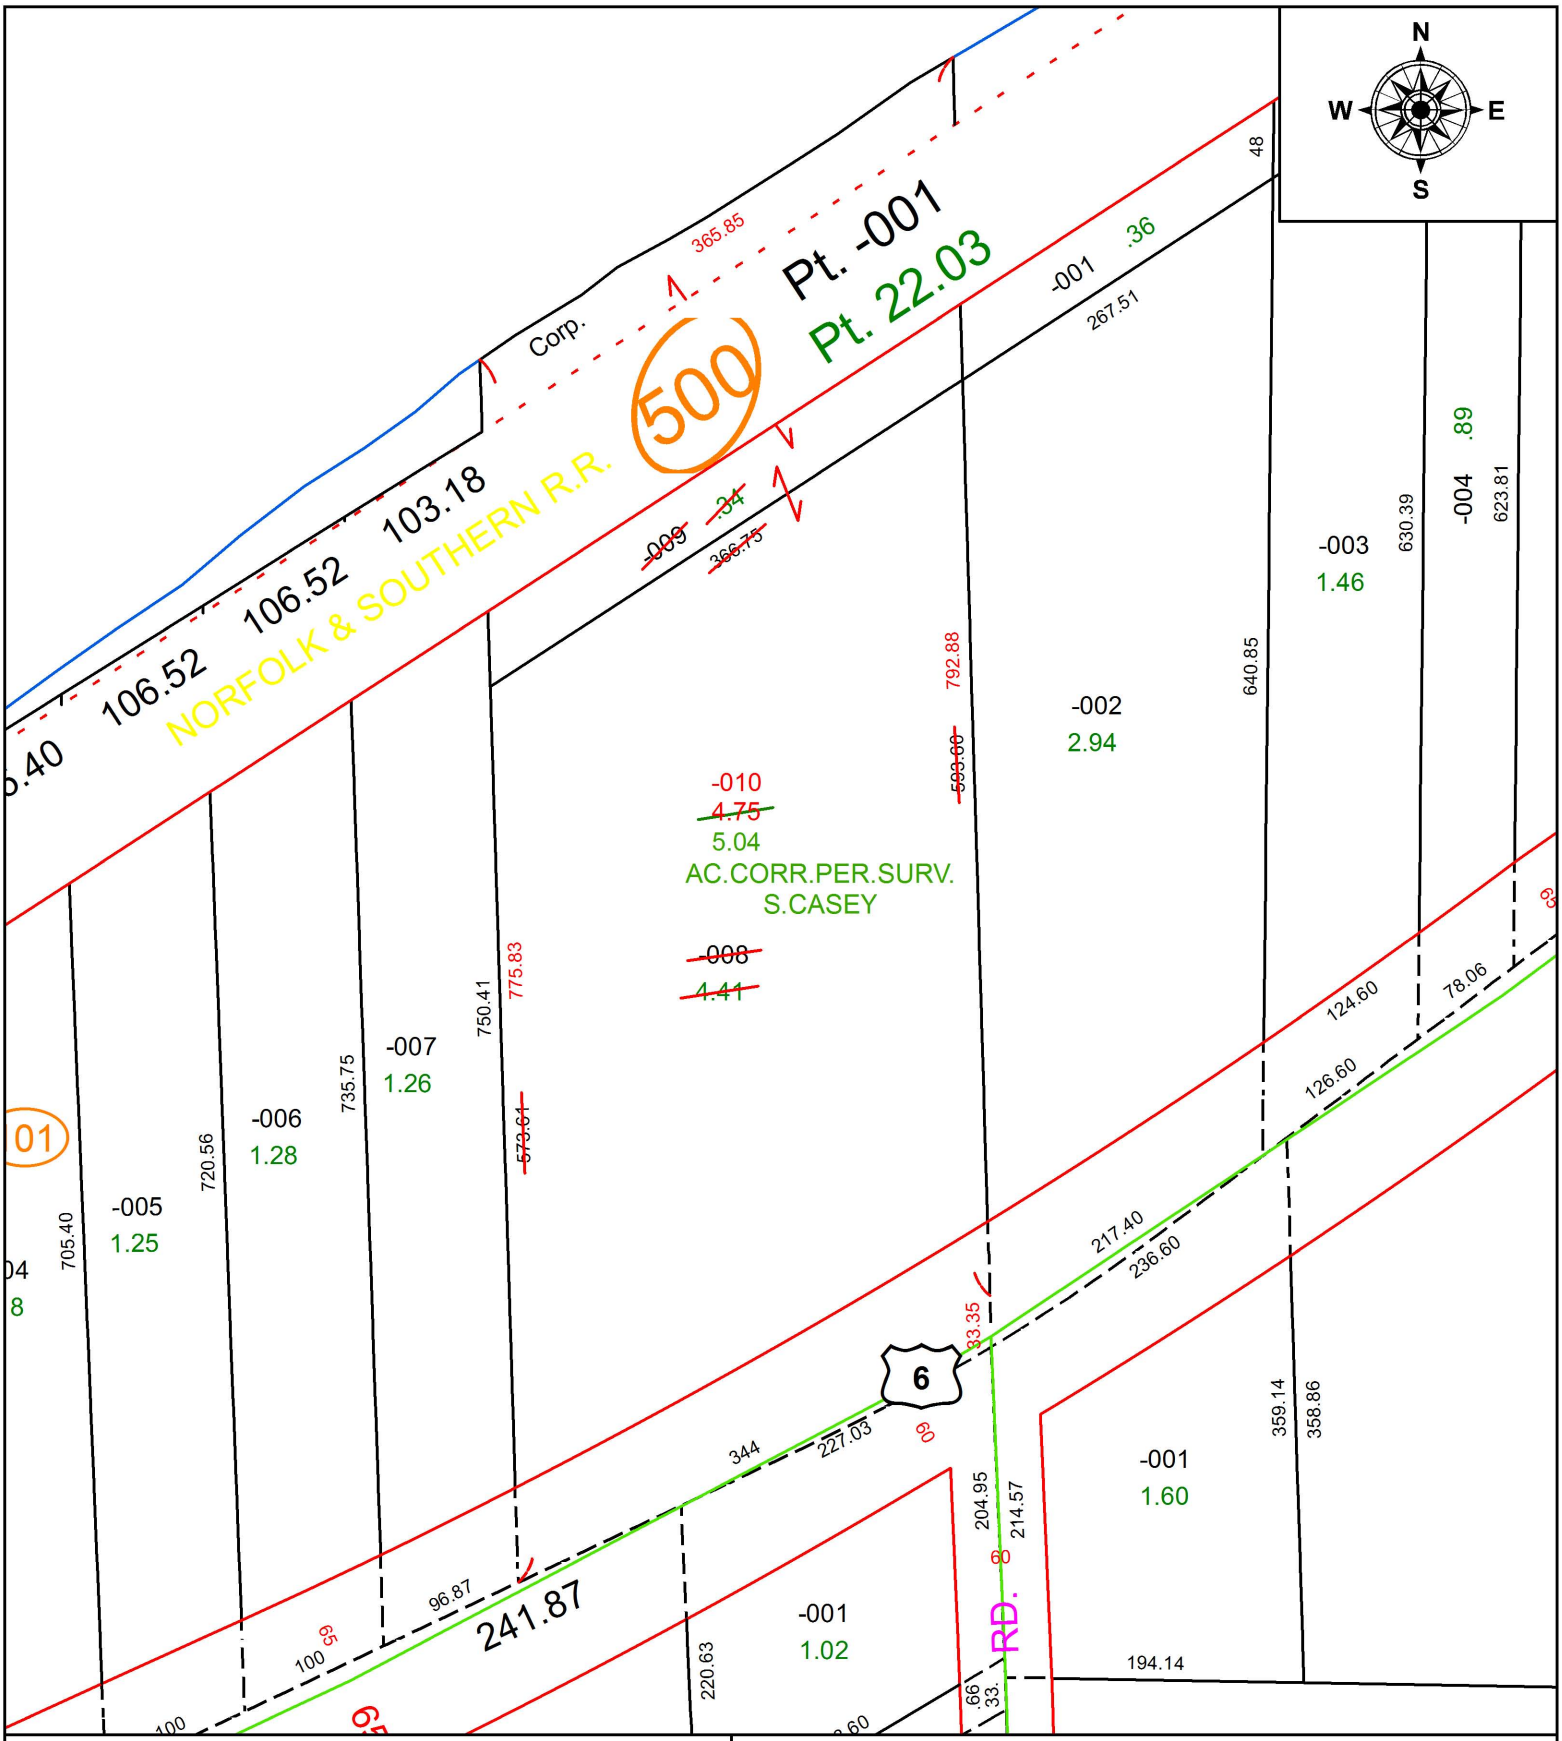

SPLITS/DEEDS PROCESSED

LORAIN COUNTY TAX MAP DEPARTMENT
226 MIDDLE AVE. ELYRIA, OH

SURVEYED BY: SCOTT J. CASEY

CLOSURE: 1: 683,673

MAP PAGE(S): 2-03-001

APPOVED BY: RRM **DATE:** 4-27-18

SCALE: 1" = 125 **PRIOR INSTRUMENT:** 20100354155