PARENT PARCEL: 06-23-001-101-019

CHILD PARCEL: 06-23-001-101-025, -026

STARTING POINT: SOUTHEAST CORNER OF AMHERST TOWNSHIP O.L.82

18-03882

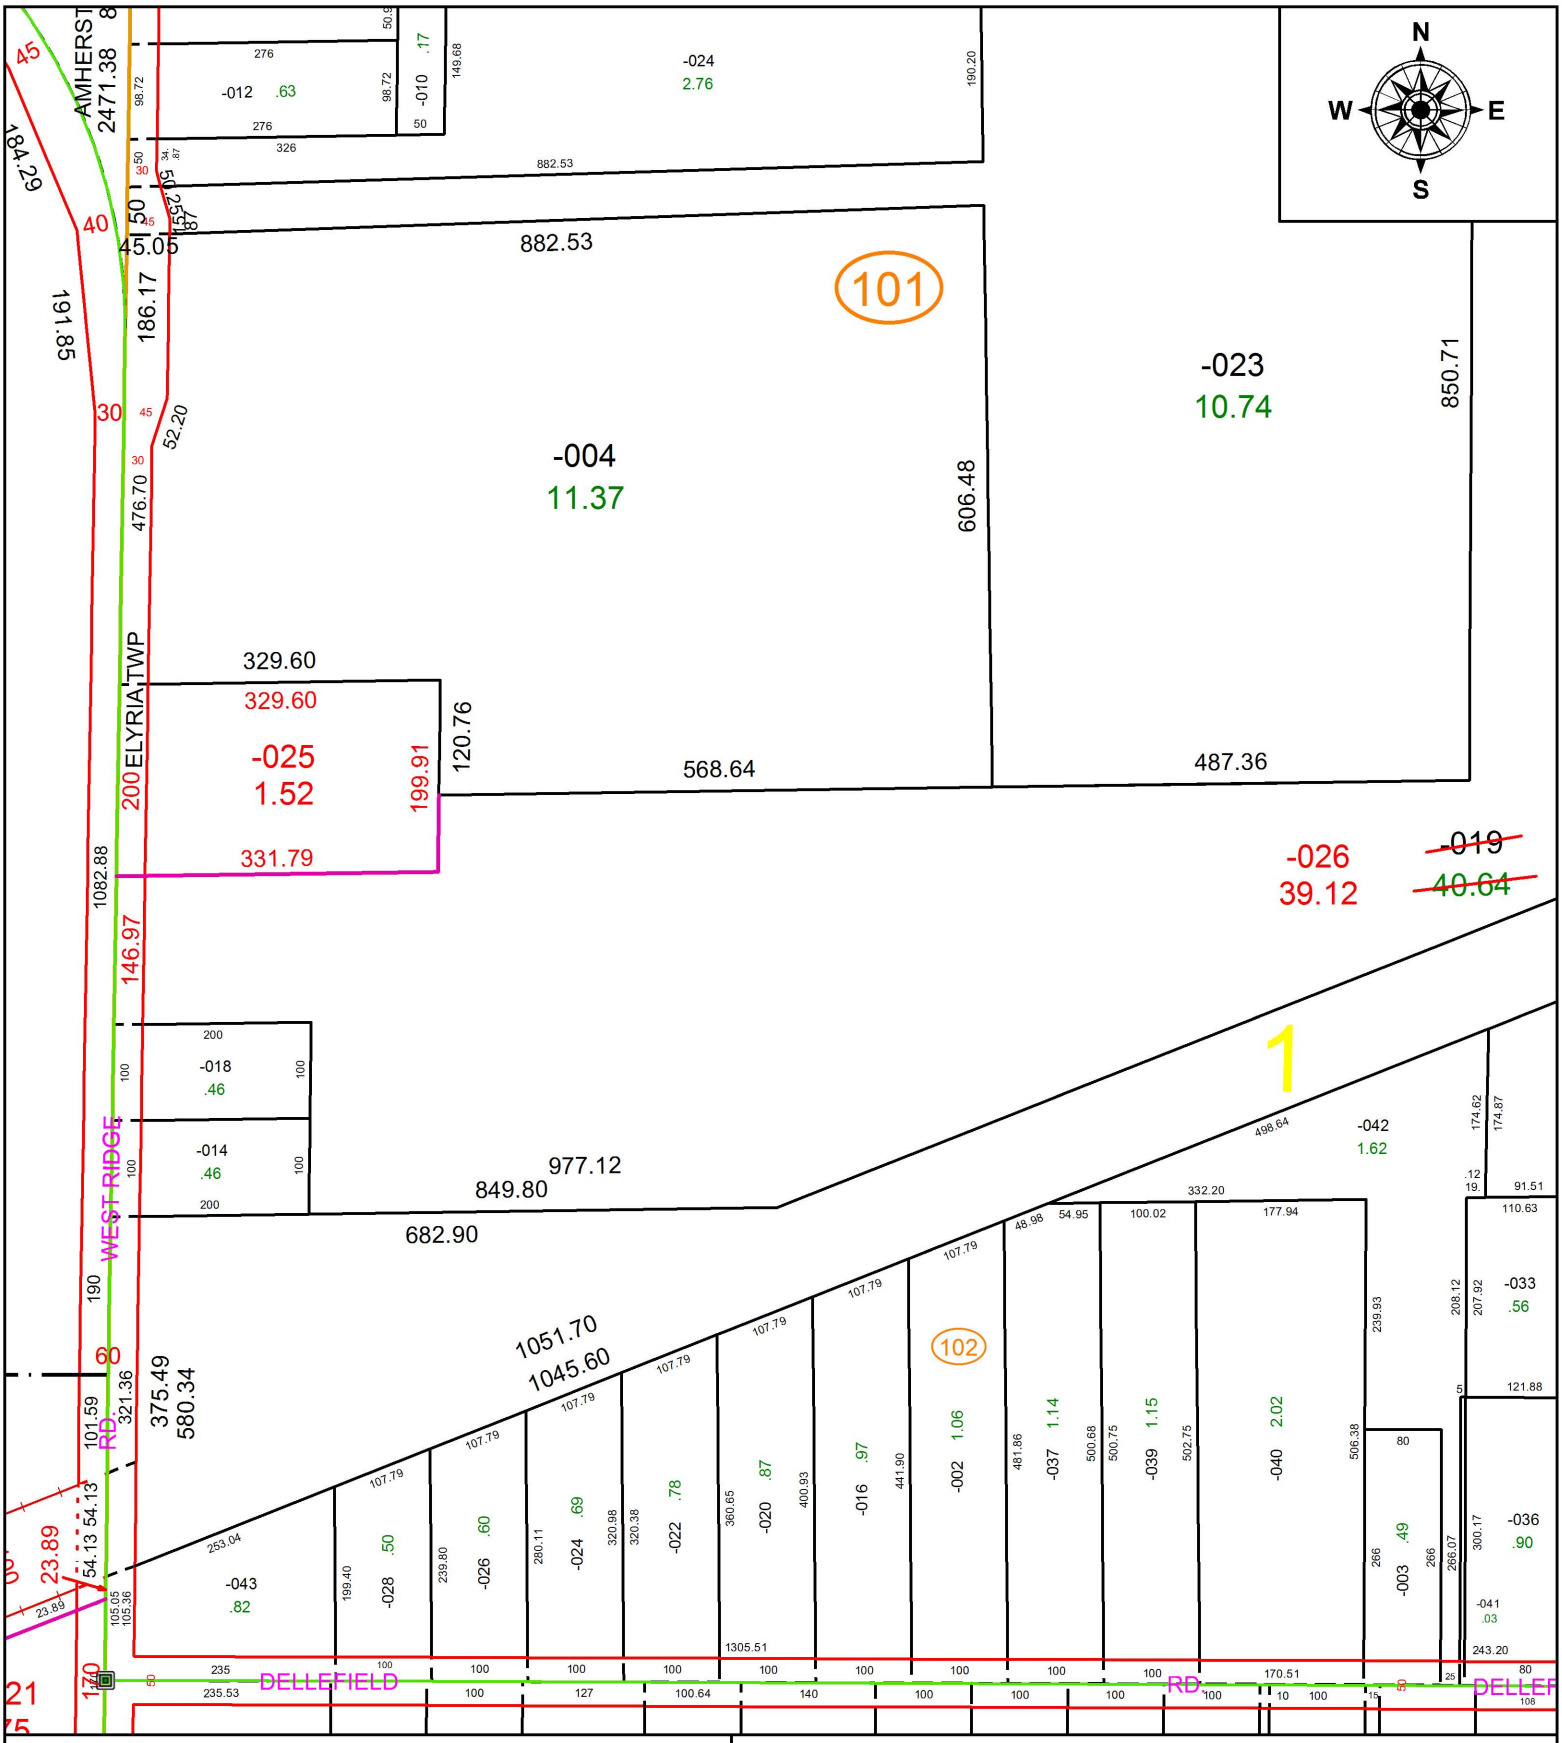

SPLITS/DEEDS PROCESSED

LORAIN COUNTY TAX MAP DEPARTMENT
226 MIDDLE AVE. ELYRIA, OH

SURVEYED BY: THOMAS A. SIMON
CLOSURE: 1: 364,053
MAP PAGE(S): 6-19
APPOVED BY: RRM **DATE:** 10-2-18
SCALE: 1" = 200 **PRIOR INSTRUMENT:** 19980527183