PARENT PARCEL: 09-00-086-102-095
CHILD PARCEL: XX-XX-XXX-XXX-XXX
STARTING POINT: INTERSECTION OF NORTH LINE OF E. VINE ST. AND EAST LINE OF S. MAIN ST.

18-03883-D

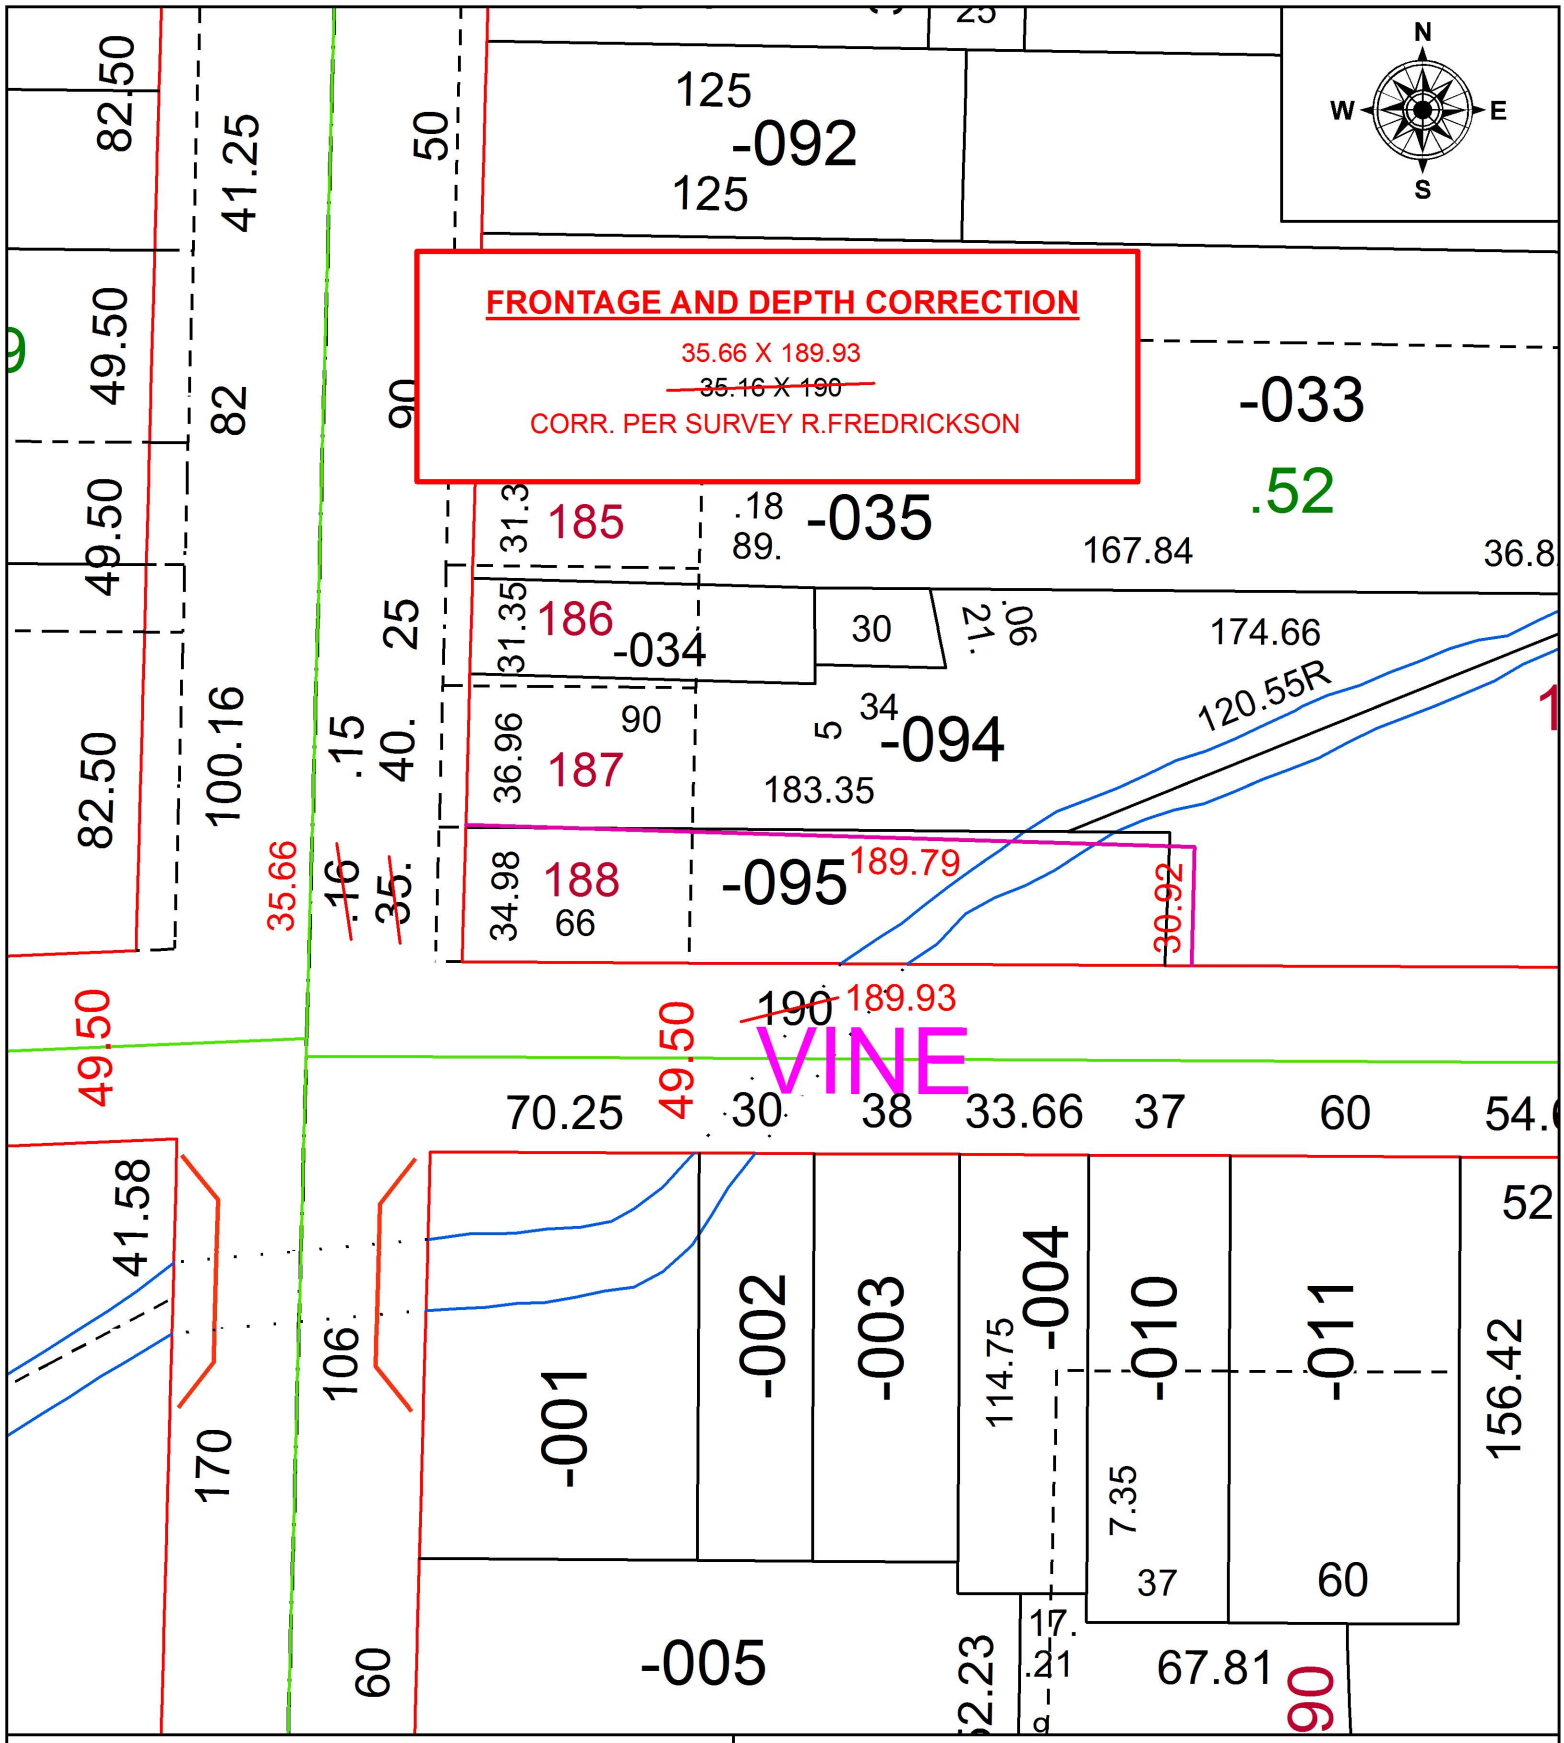

SPLITS/DEEDS PROCESSED
LORAIN COUNTY TAX MAP DEPARTMENT
226 MIDDLE AVE. ELYRIA, OH

SURVEYED BY: RICHARD A. FREDRICKSON
CLOSURE: 1: 75,592
MAP PAGE(S): 9-00-086
APPOVED BY: RRM DATE: 4-30-18
SCALE: 1" = 50 PRIOR INSTRUMENT: 19970509722