PARENT PARCEL: 06-24-105-000-004, -005
CHILD PARCEL: 06-24-105-000-009
STARTING POINT: INTERSECTION OF NORTH LINE OF FILBERT ST. AND WEST LINE OF GATEWAY BLVD.

18-03885

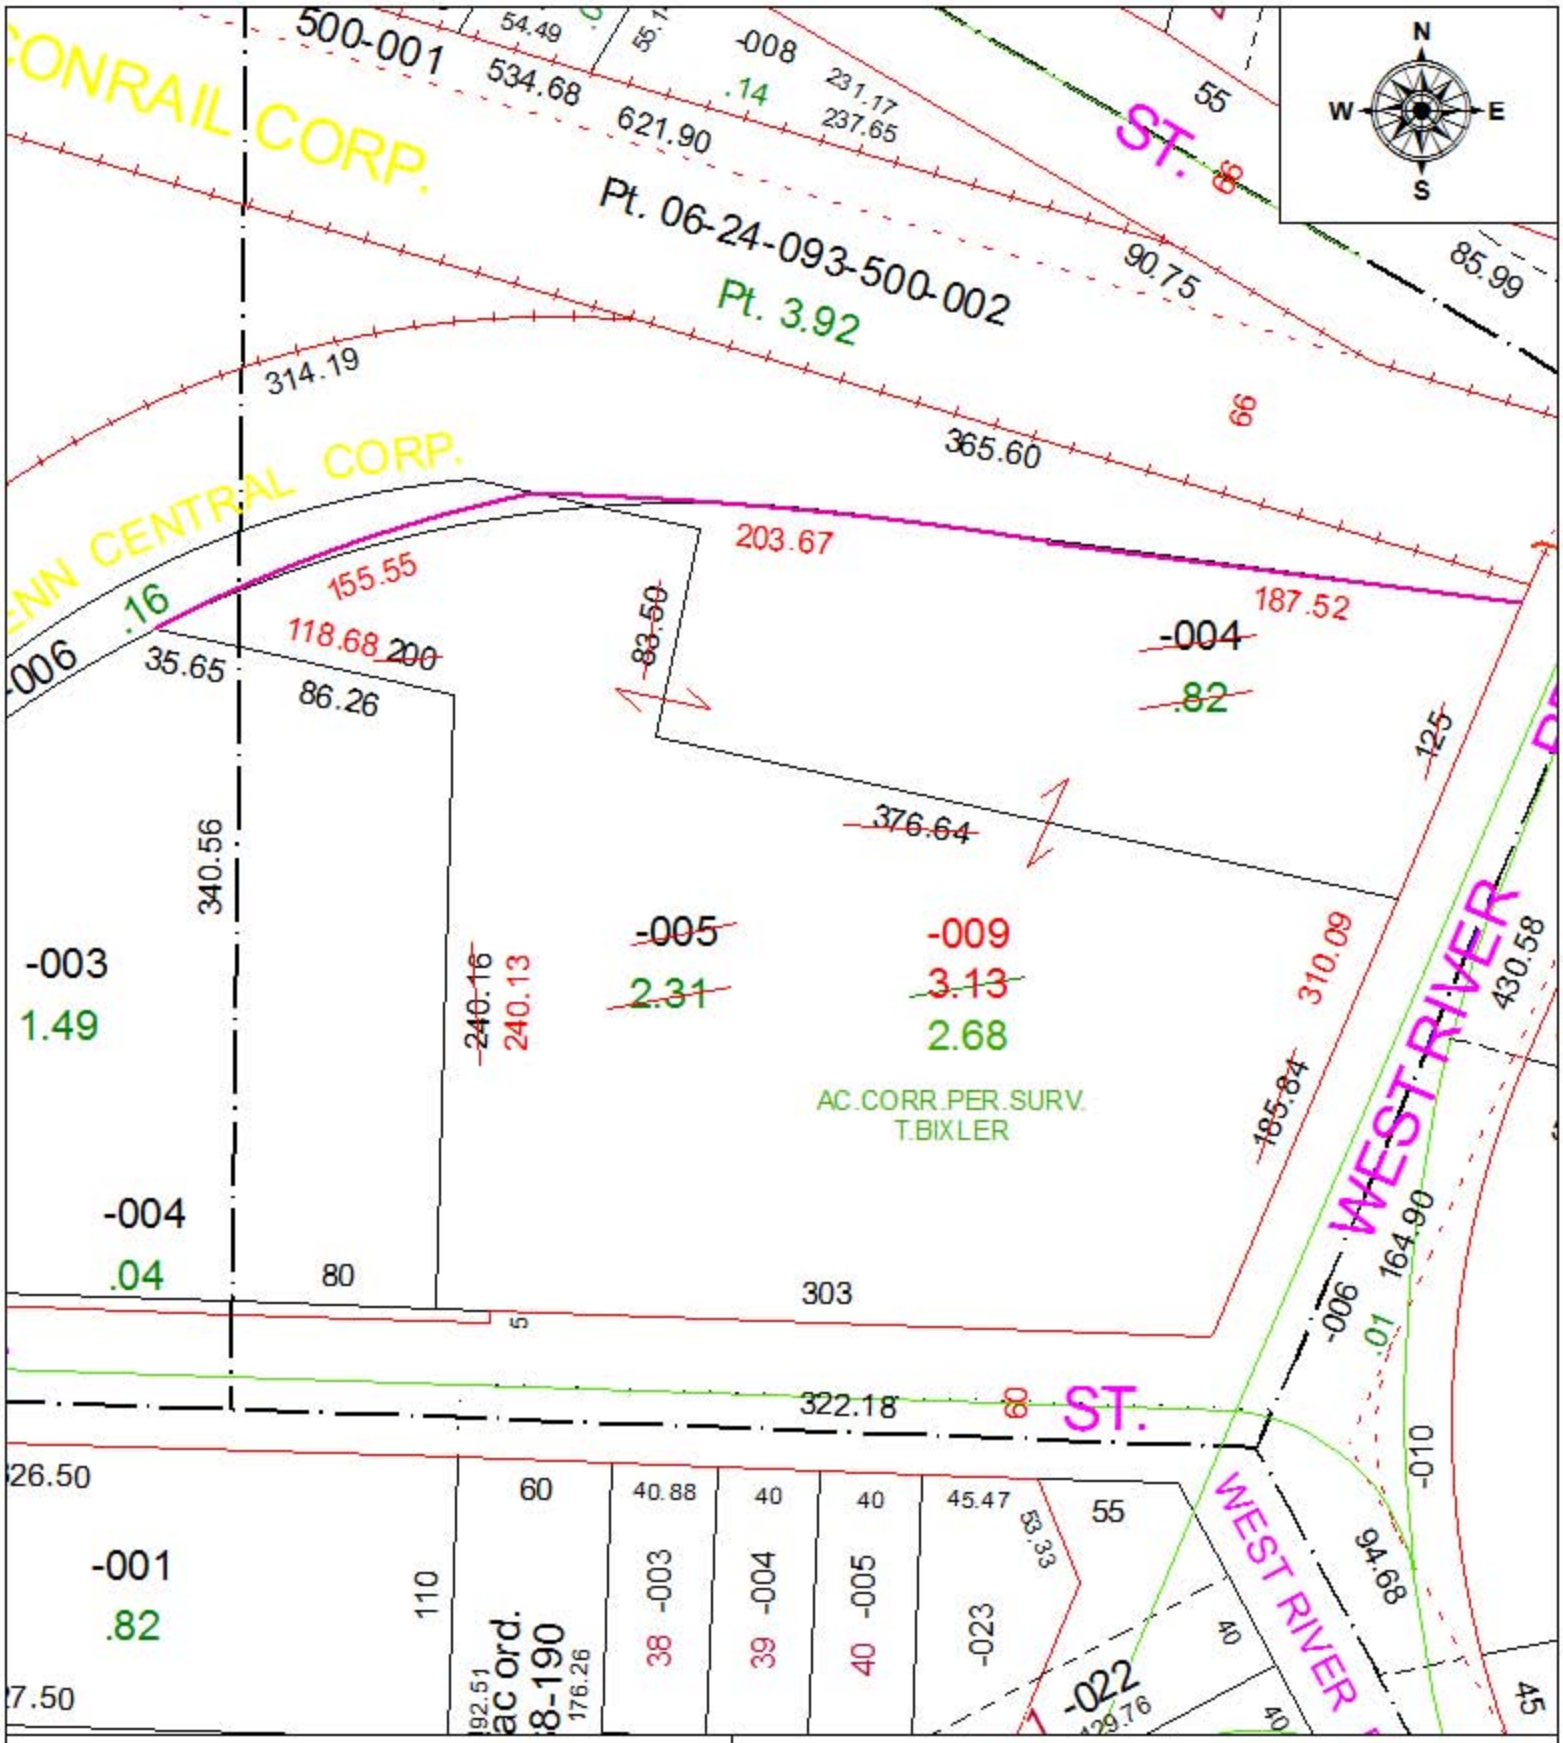

SPLITS/DEEDS PROCESSED

LORAIN COUNTY TAX MAP DEPARTMENT
226 MIDDLE AVE. ELYRIA, OH

SURVEYED BY: TREVOR A. BIXLER
CLOSURE: 1: 281,117
MAP PAGE(S): 6-24-105
APPOVED BY: RRM DATE: 10-9-18
SCALE: 1" = 75 PRIOR INSTRUMENT: 20040987153