PARENT PARCEL: 02-03-005-101-001
CHILD PARCEL: XX-XX-XXX-XXX-XXX
STARTING POINT: INTERSECTION OF C/L OF KOLBE RD. AND NORTH LINE OF O.L.5

18-03888-D

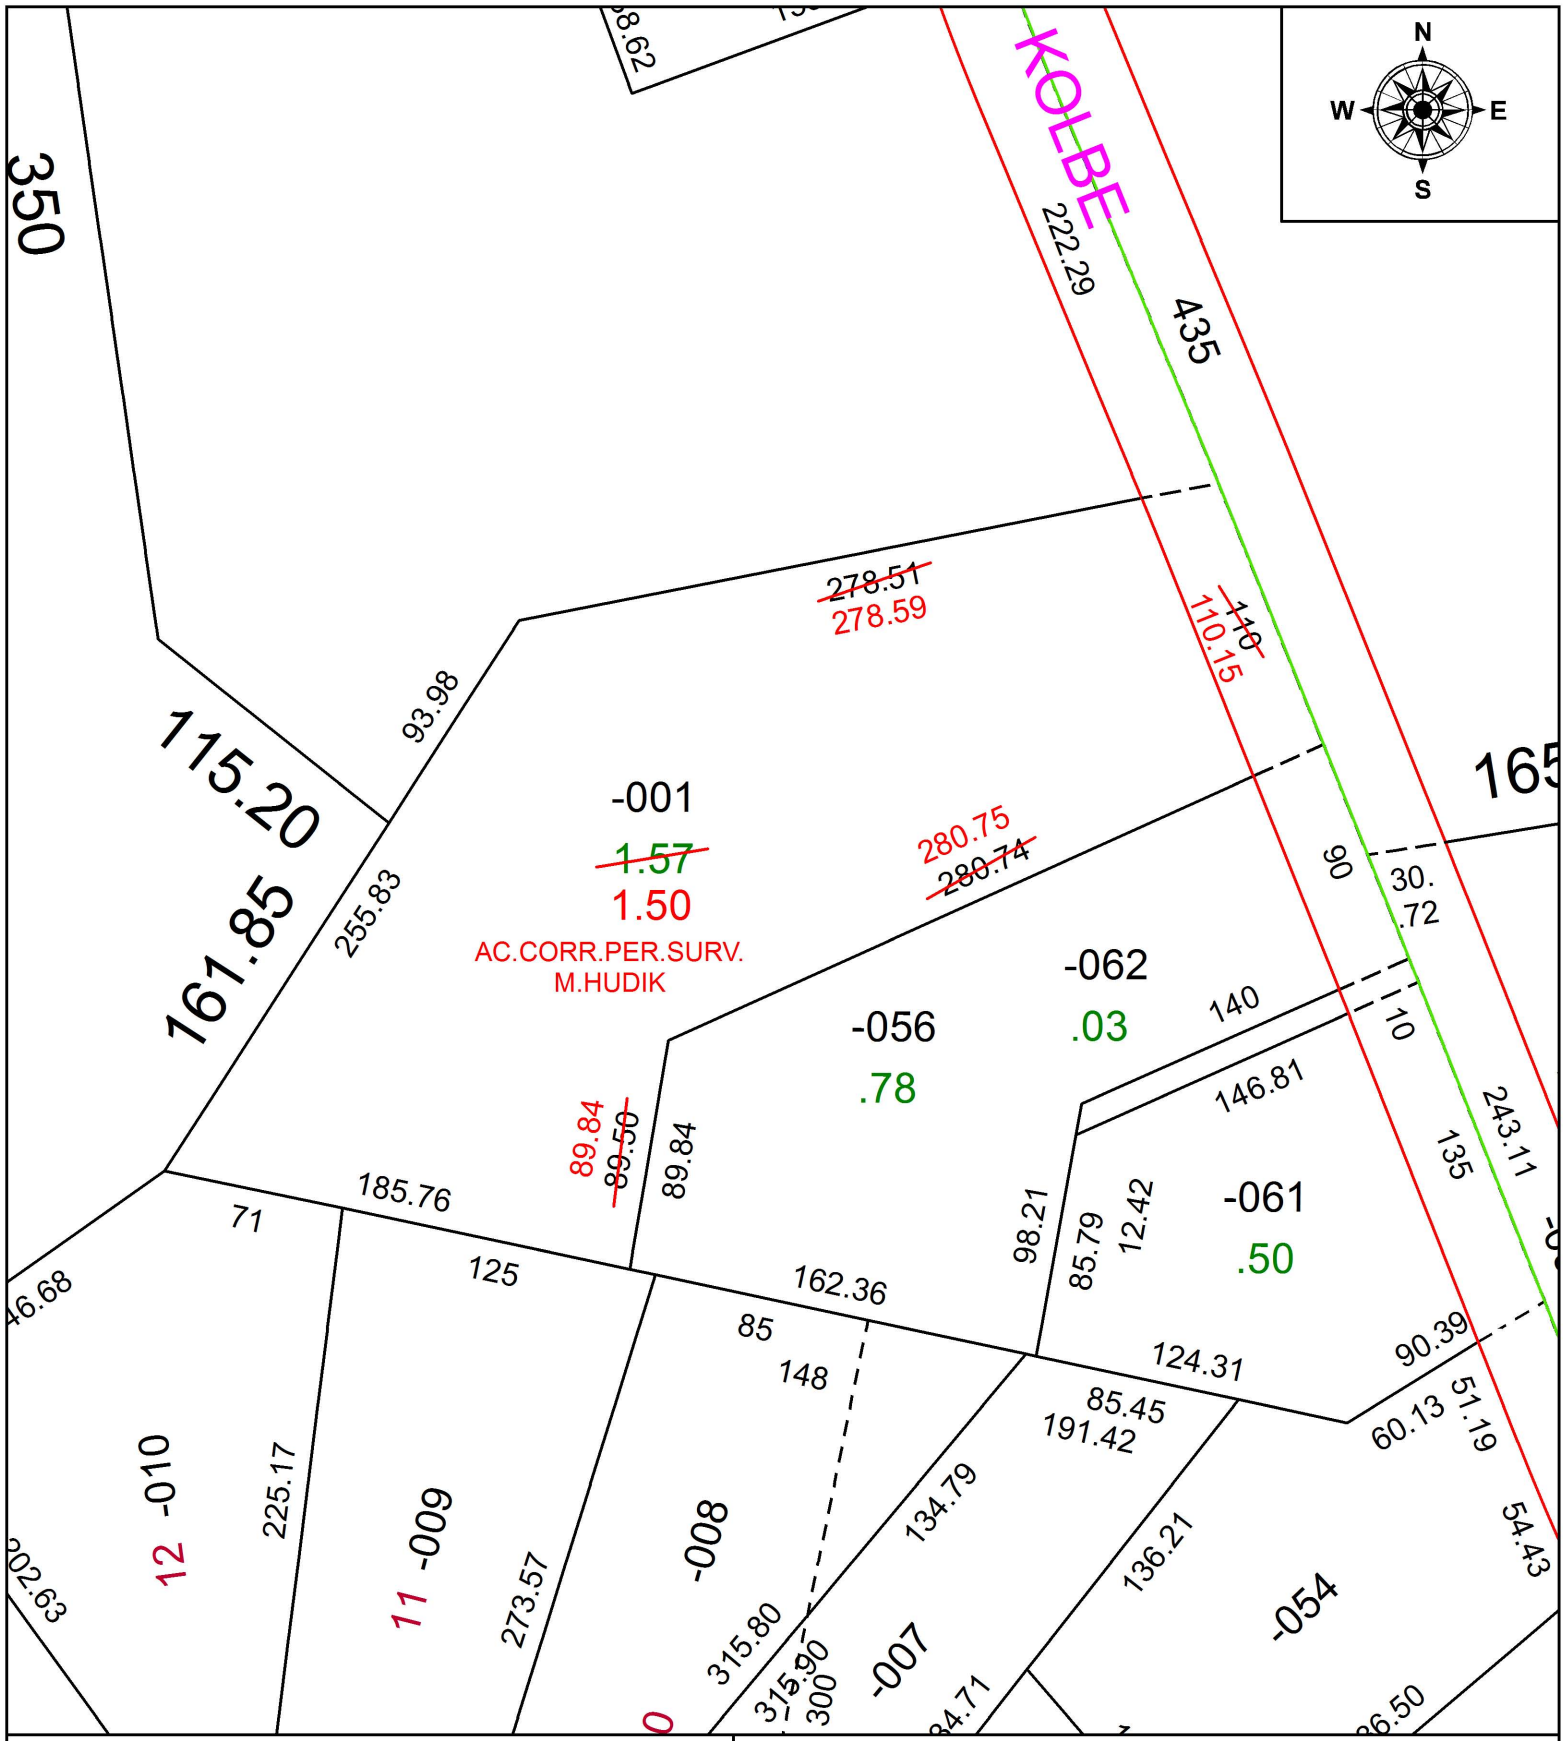

SPLITS/DEEDS PROCESSED
LORAIN COUNTY TAX MAP DEPARTMENT
226 MIDDLE AVE. ELYRIA, OH

SURVEYED BY: MICHAEL J. HUDIK
CLOSURE: 1: 224,702
MAP PAGE(S): 2-03-005
APPOVED BY: RRM **DATE:** 5-9-18
SCALE: 1" = 75 **PRIOR INSTRUMENT:** 20150564760