PARENT PARCEL: 15-00-079-000-016
CHILD PARCEL: 15-00-079-000-019, -020
STARTING POINT: INTERSECTION OF C/L OF NICKLE PLATE DIAGONAL RD. AND C/L OF WHITNEY RD.

18-03888

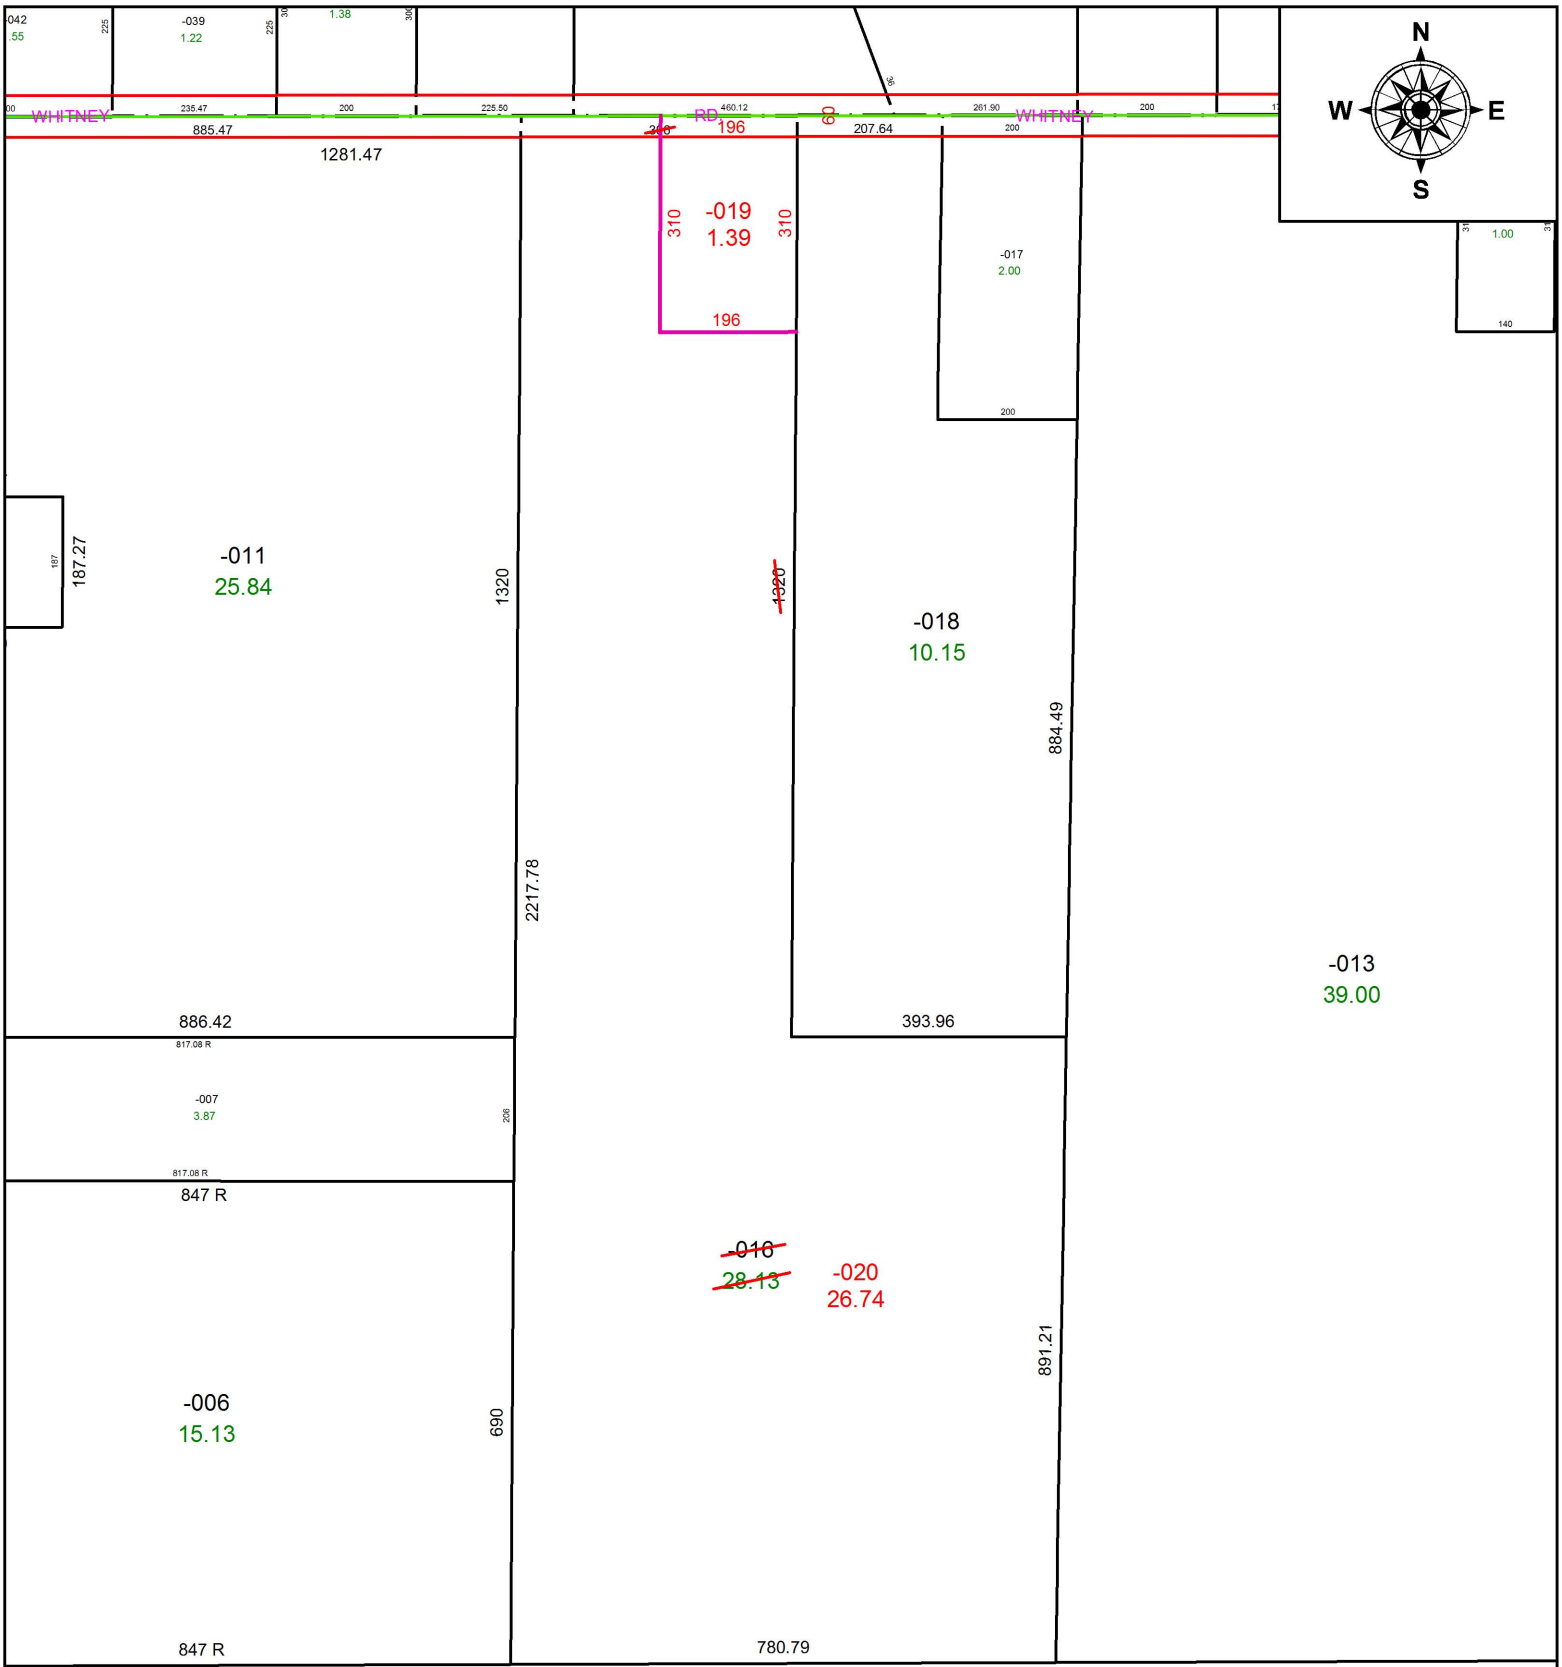

SPLITS/DEEDS PROCESSED

LORAIN COUNTY TAX MAP DEPARTMENT
226 MIDDLE AVE. ELYRIA, OH

SURVEYED BY: TIMOHTY D. HOZALSKI
CLOSURE: 1: 2147483648
MAP PAGE(S): 15-00-079
APPOVED BY: RRM **DATE:** 10-16-18
SCALE: 1" = 275 **PRIOR INSTRUMENT:** 20180689236