PARENT PARCEL: 08-00-100-000-009, -010, 08-00-101-000-022

CHILD PARCEL: 08-00-100-000-024, 08-00-101-000-022

STARTING POINT: SOUTHEAST CORNER OF LAND CONVEYED TO RALPH W. & MILDRED HASENPFLUG (DV 858/174)

18-03889-C

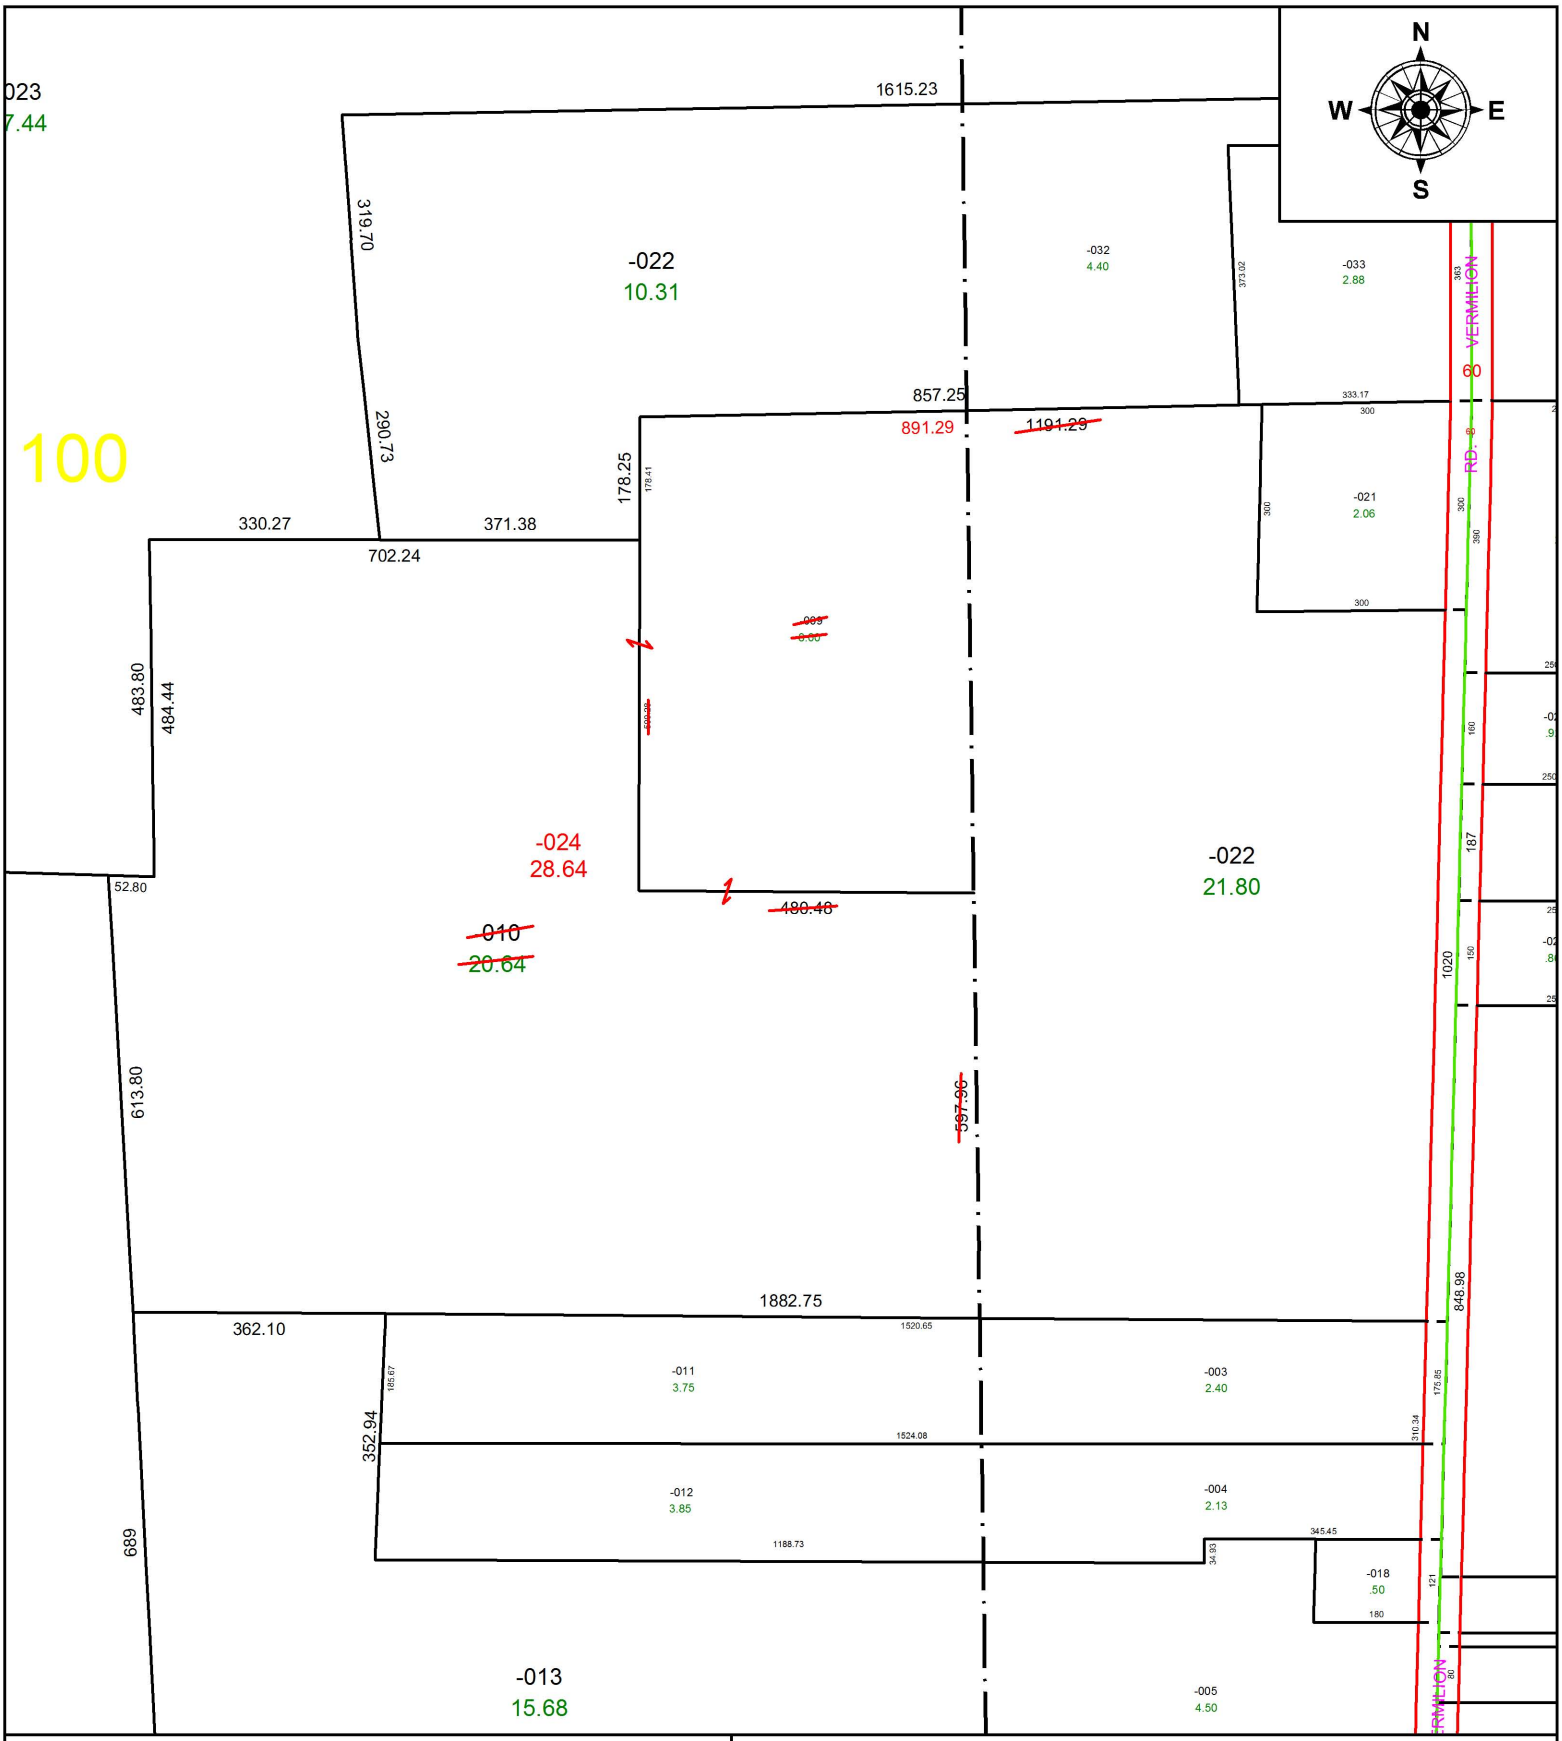

SPLITS/DEEDS PROCESSED

LORAIN COUNTY TAX MAP DEPARTMENT
226 MIDDLE AVE. ELYRIA, OH

SURVEYED BY: N/A
CLOSURE: N/A
MAP PAGE(S): 8-B
APPOVED BY: RRM **DATE:** 5-17-18
SCALE: 1" = 275 **PRIOR INSTRUMENT:** 20110389851