PARENT PARCEL: 18-00-021-111-009, -021, -022
CHILD PARCEL: XX-XX-XXX-XXX-XXX
STARTING POINT: INTERSECTION OF C/L OF DEWOLF ST. AND C/L OF HALE ST.

18-03891-D

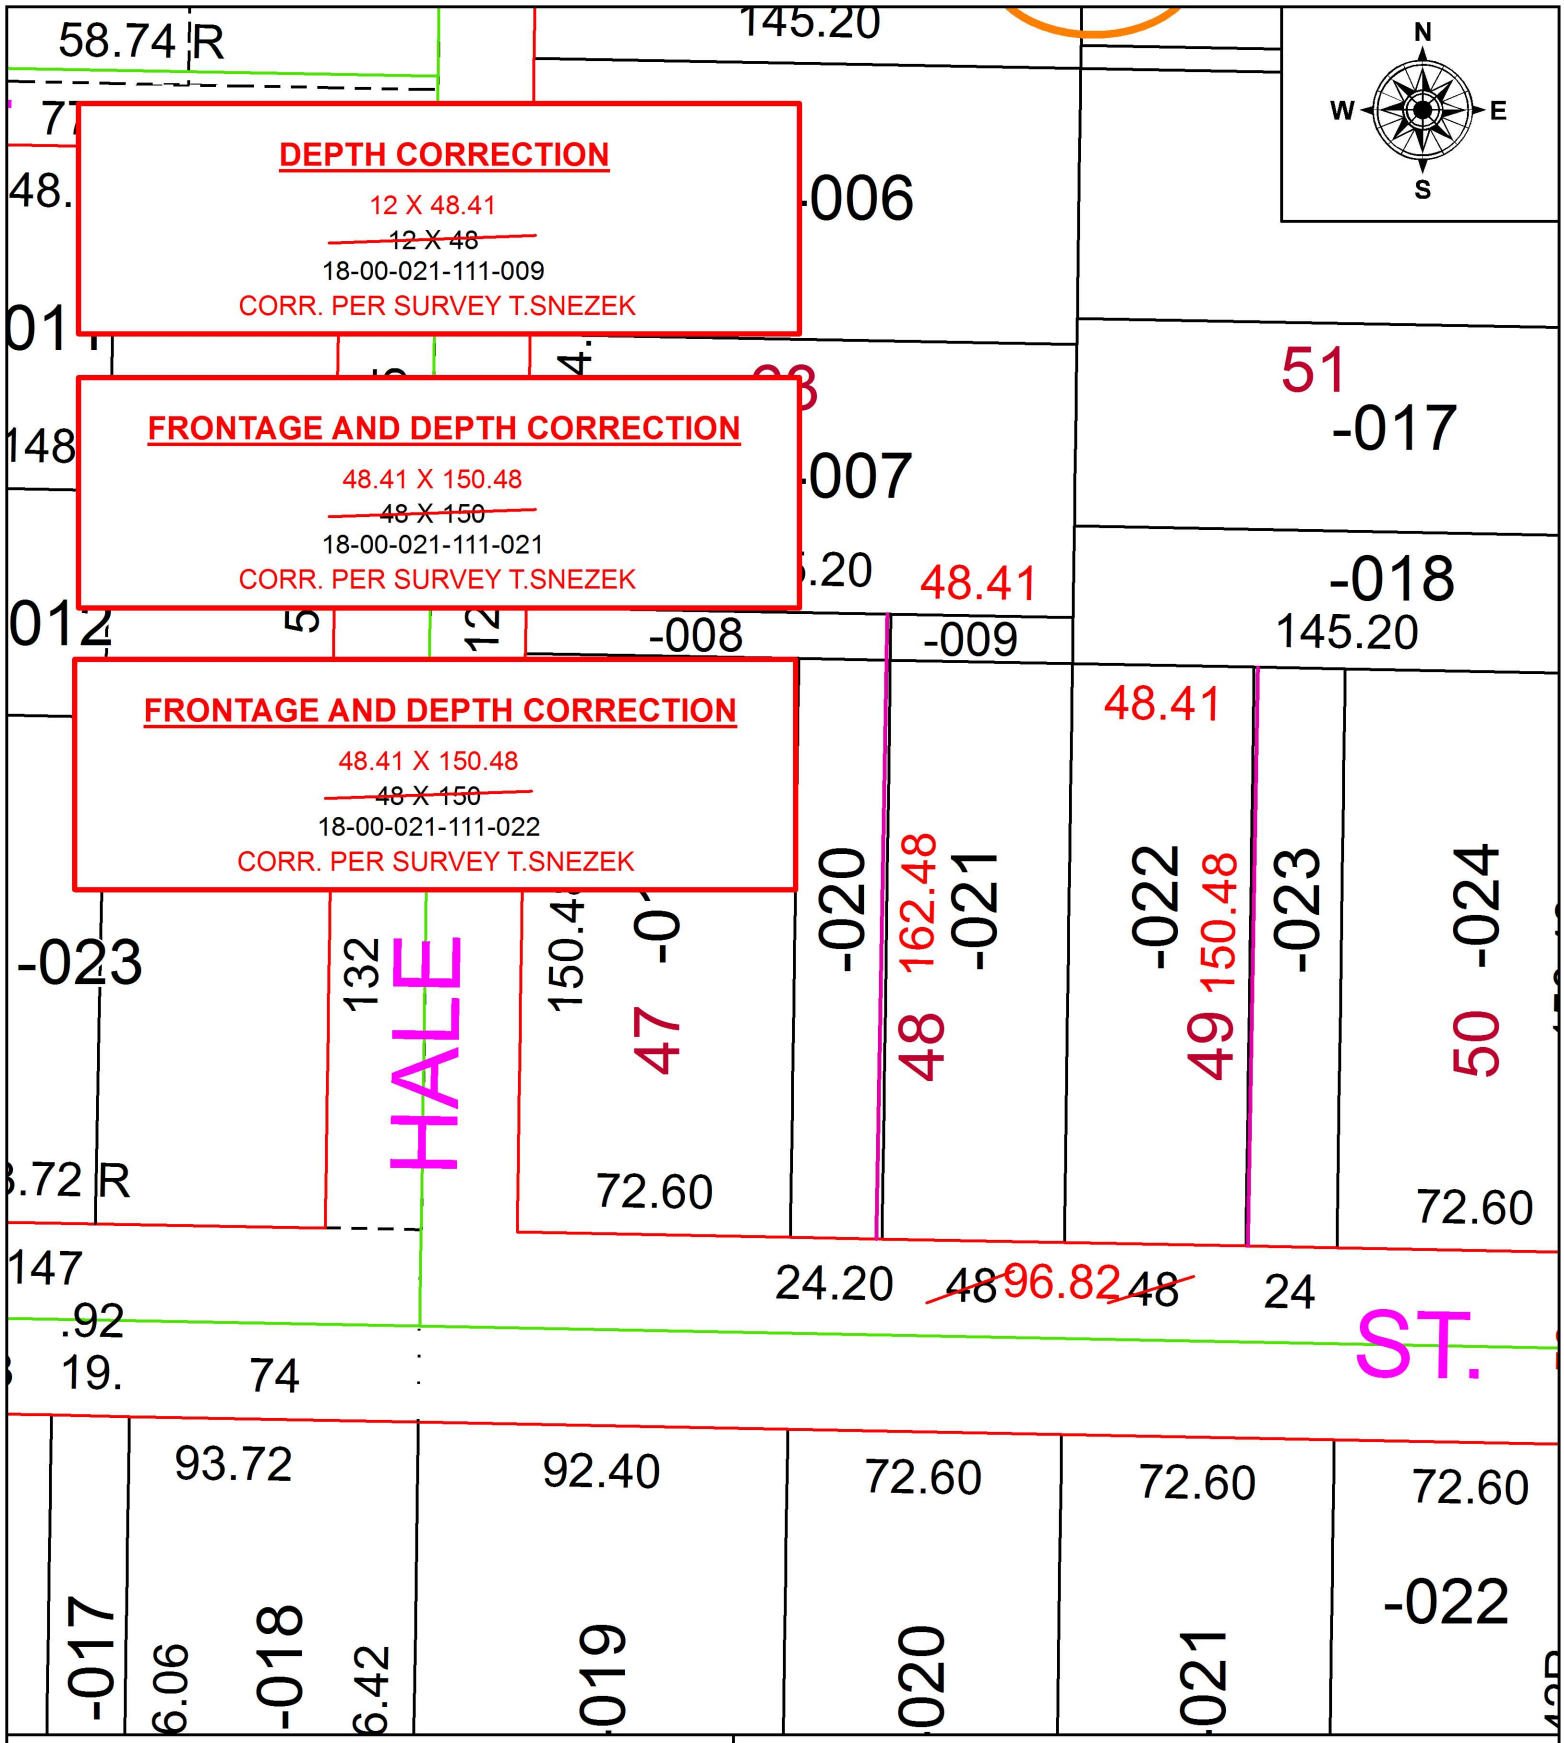

SPLITS/DEEDS PROCESSED
LORAIN COUNTY TAX MAP DEPARTMENT
226 MIDDLE AVE. ELYRIA, OH

SURVEYED BY: THOMAS M. SNEZEK
CLOSURE: 1: 2147483648
MAP PAGE(S): 18-00-021
APPOVED BY: RRM **DATE:** 5-17-18
SCALE: 1" = 50 **PRIOR INSTRUMENT:** 20170653669