PARENT PARCEL: 01-00-006-102-037, -052, -053

CHILD PARCEL: 01-00-006-102-057 THRU -060

STARTING POINT: INTERSECTION OF C/L OF LIBERTY AVE. AND C/L OF NICHOLSON AVE.

18-03892

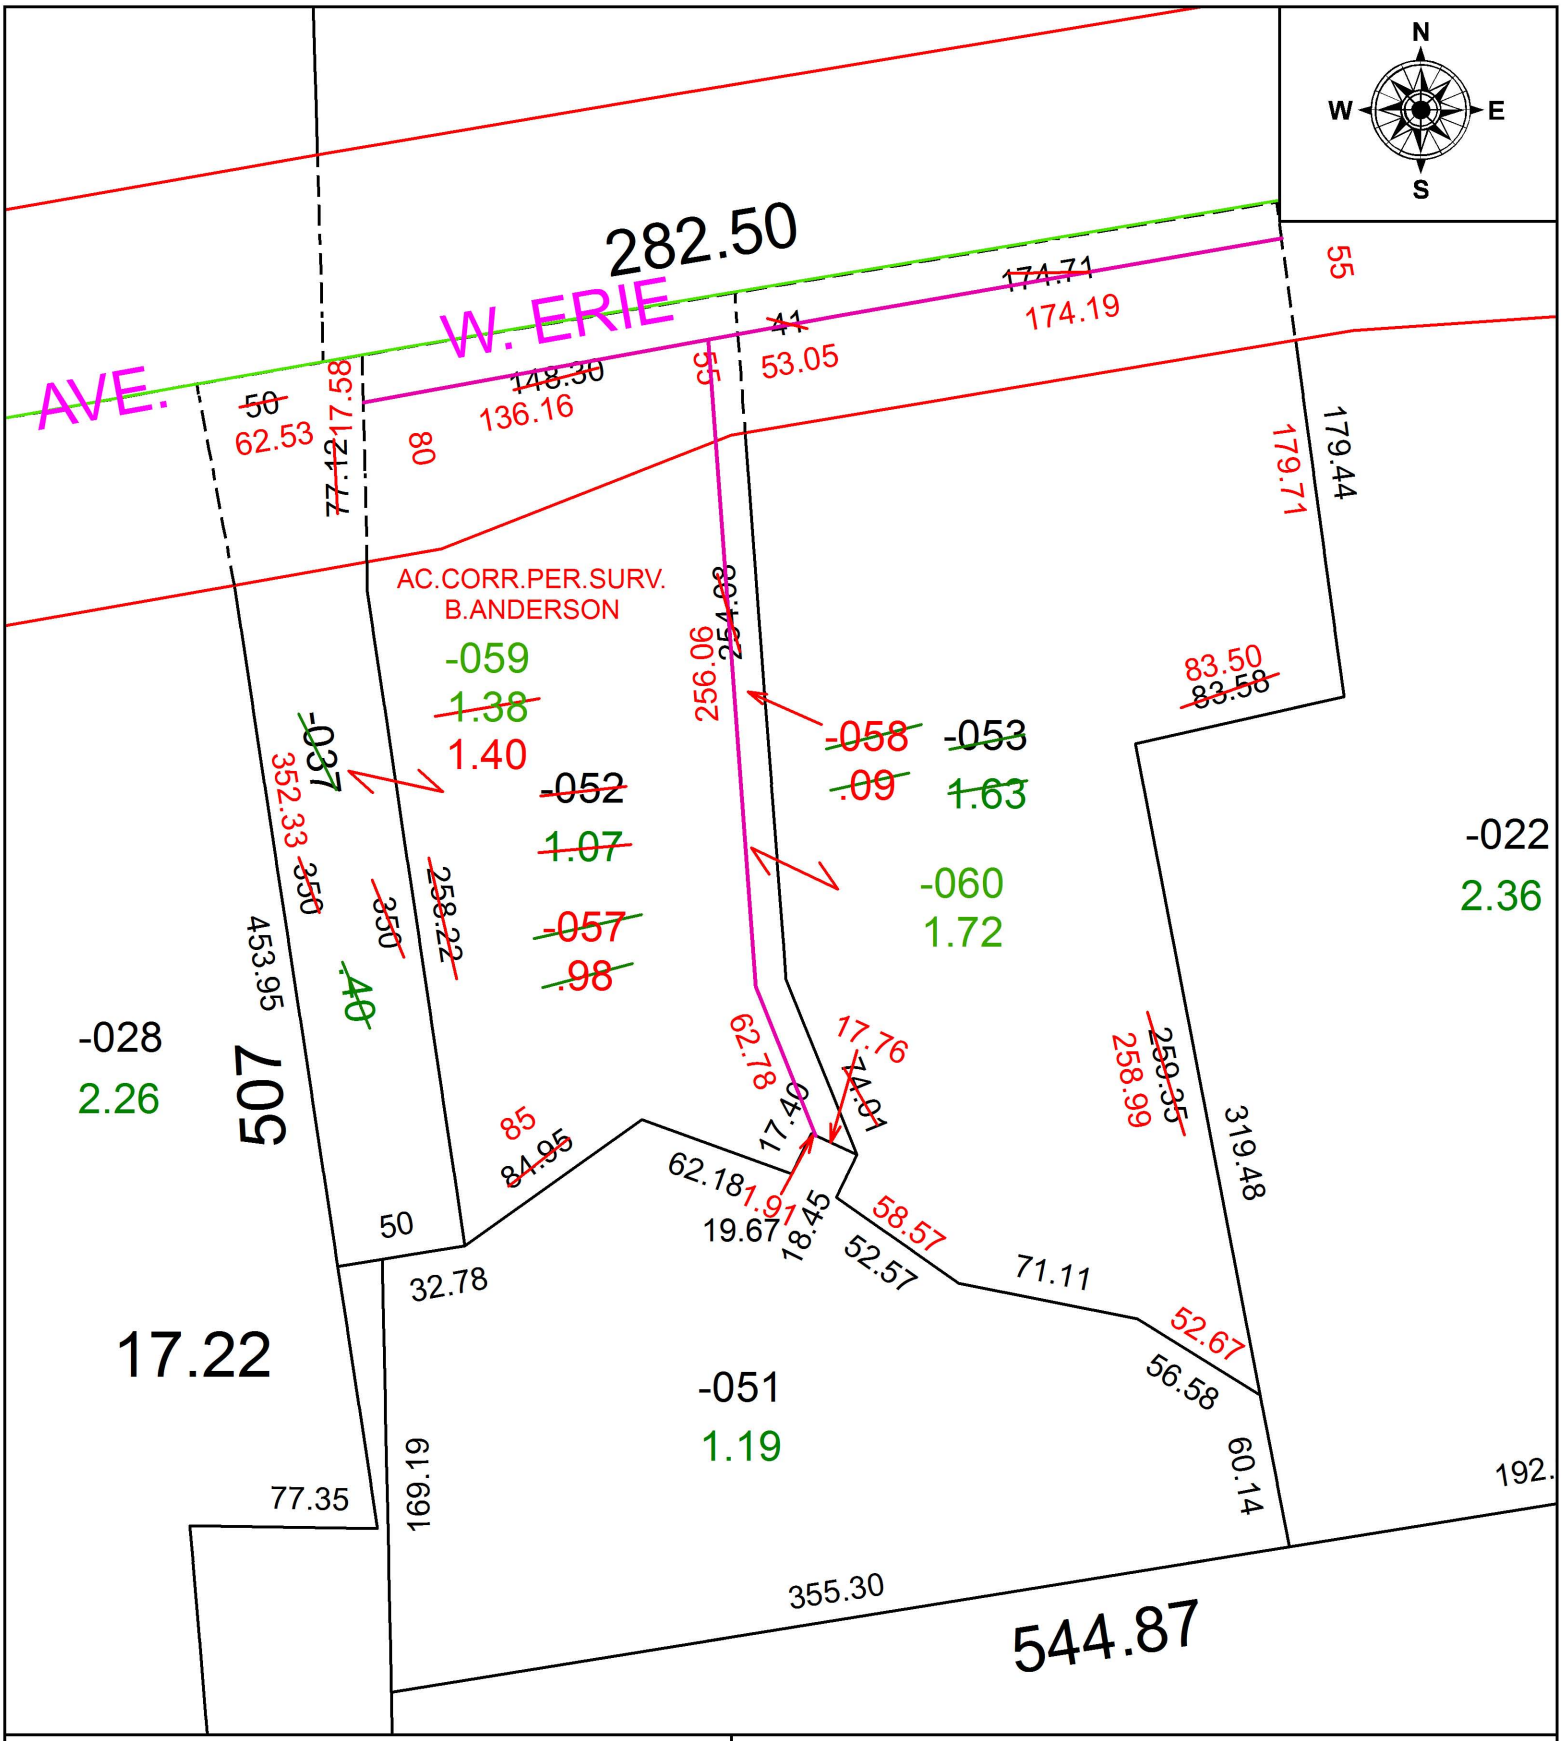

SPLITS/DEEDS PROCESSED

LORAIN COUNTY TAX MAP DEPARTMENT
226 MIDDLE AVE. ELYRIA, OH

SURVEYED BY: BRENT D. ANDERSON
CLOSURE: 1: 73,382
MAP PAGE(S): 1-00-006
APPOVED BY: RRM **DATE:** 10-22-18
SCALE: 1" = 75 **PRIOR INSTRUMENT:** 20170653712