PARENT PARCEL: 16-00-044-000-011, -035

CHILD PARCEL: 16-00-044-000-042 THRU -044

STARTING POINT: IMTERSECTION OF C/L OF MENNELL RD. AND C/L OF S.R.303

18-03894

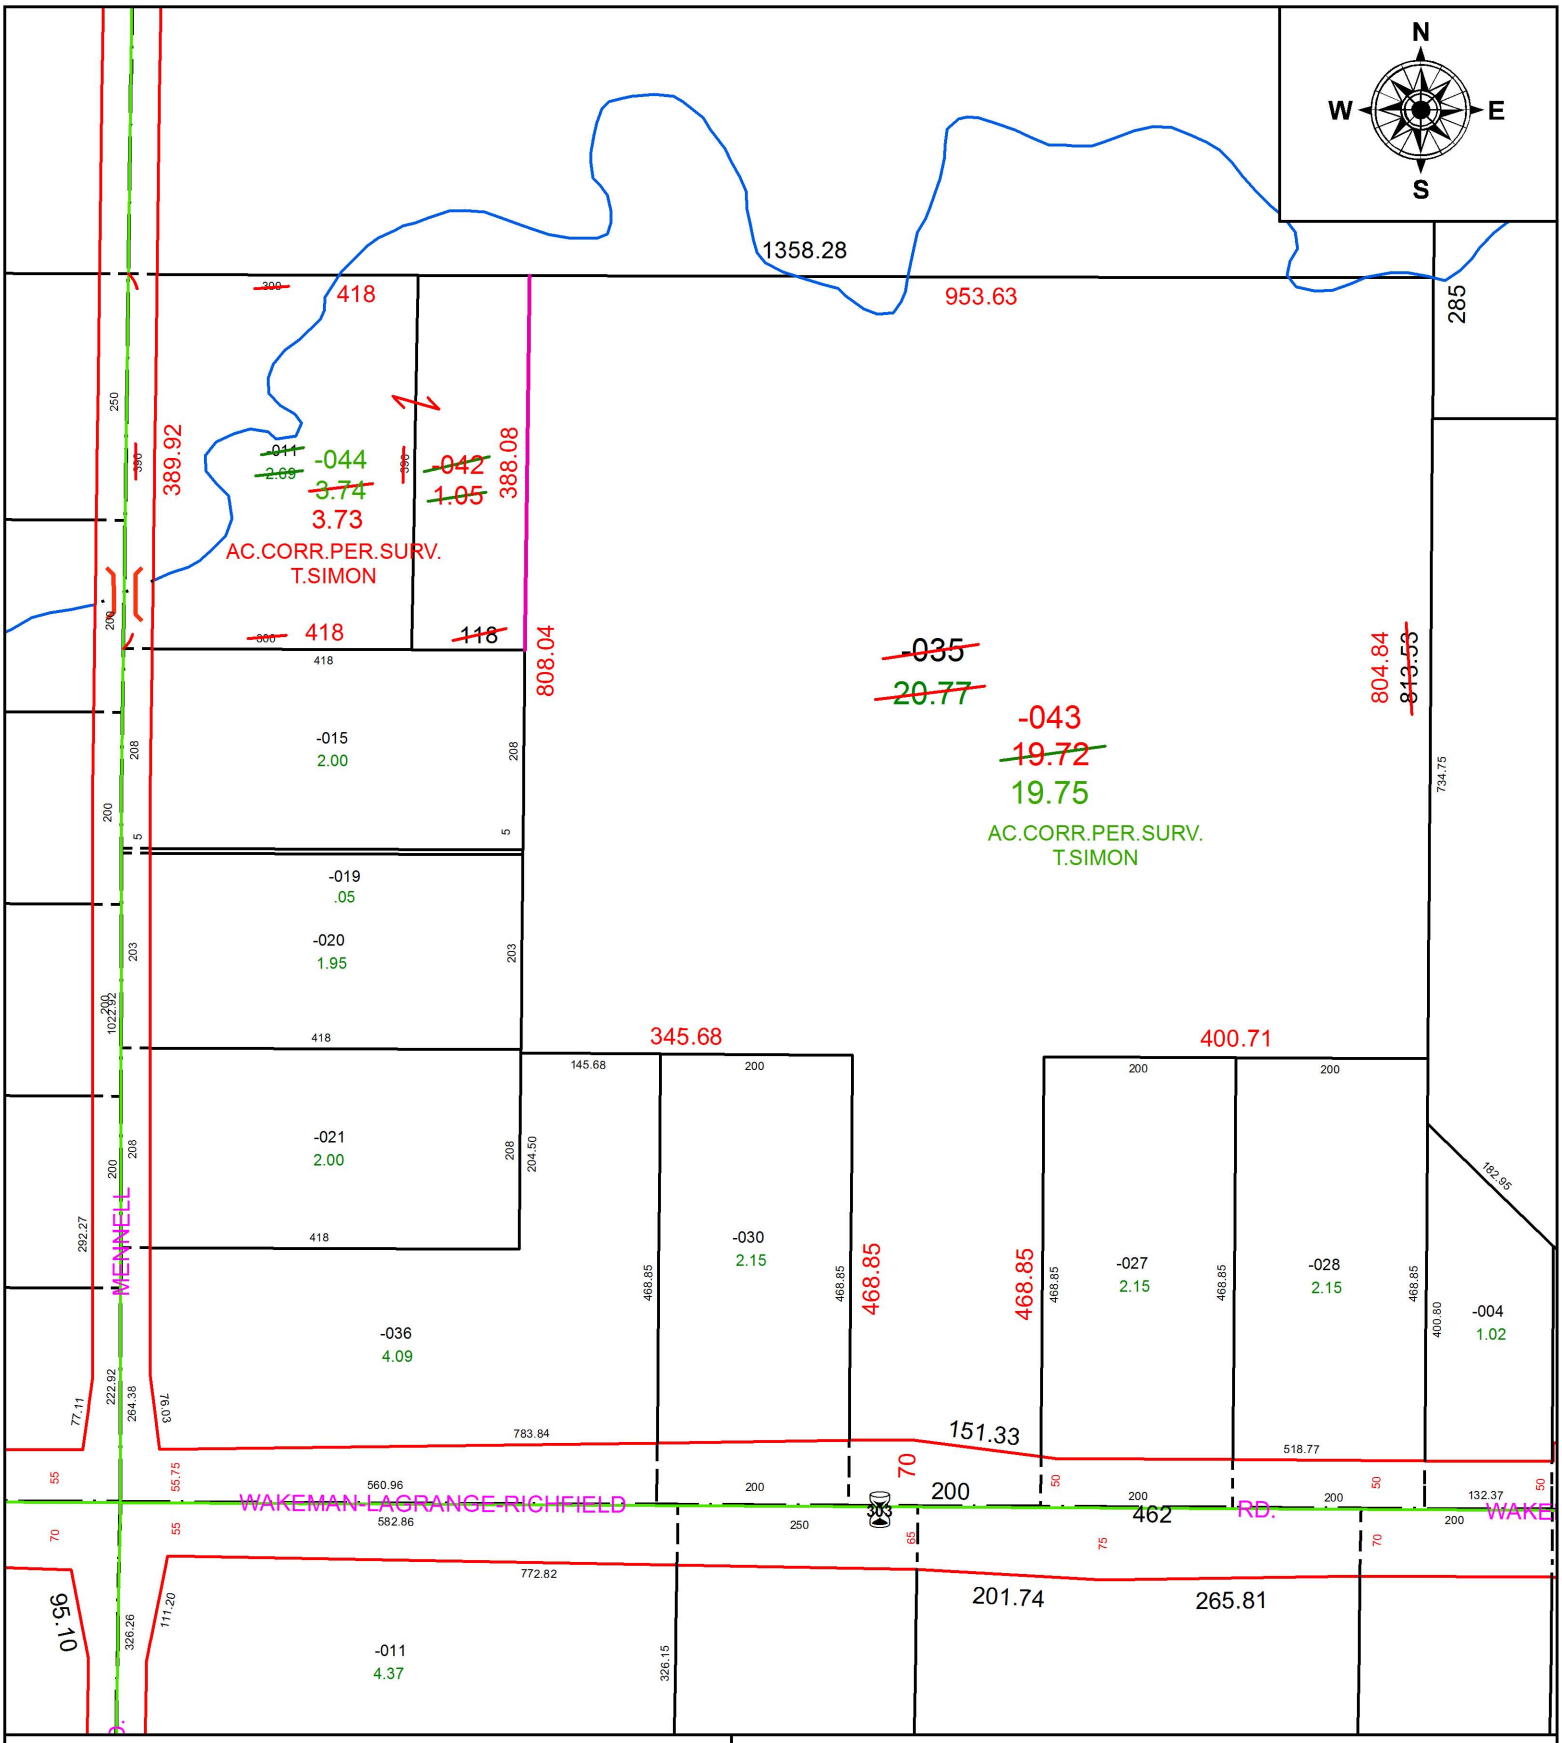

SPLITS/DEEDS PROCESSED

LORAIN COUNTY TAX MAP DEPARTMENT
226 MIDDLE AVE. ELYRIA, OH

SURVEYED BY: THOMAS A. SIMON
CLOSURE: 1: 1,778,475
MAP PAGE(S): 16-00-044
APPOVED BY: RRM **DATE:** 10-25-18
SCALE: 1" = 200 **PRIOR INSTRUMENT:** DV 1330/935