PARENT PARCEL: 16-00-018-102-032, -036
CHILD PARCEL: 16-00-018-102-039 THRU -041
STARTING POINT: INTERSECTION OF C/L OF MENNELL RD. AND C/L OF GRAFTON RD.

18-03896

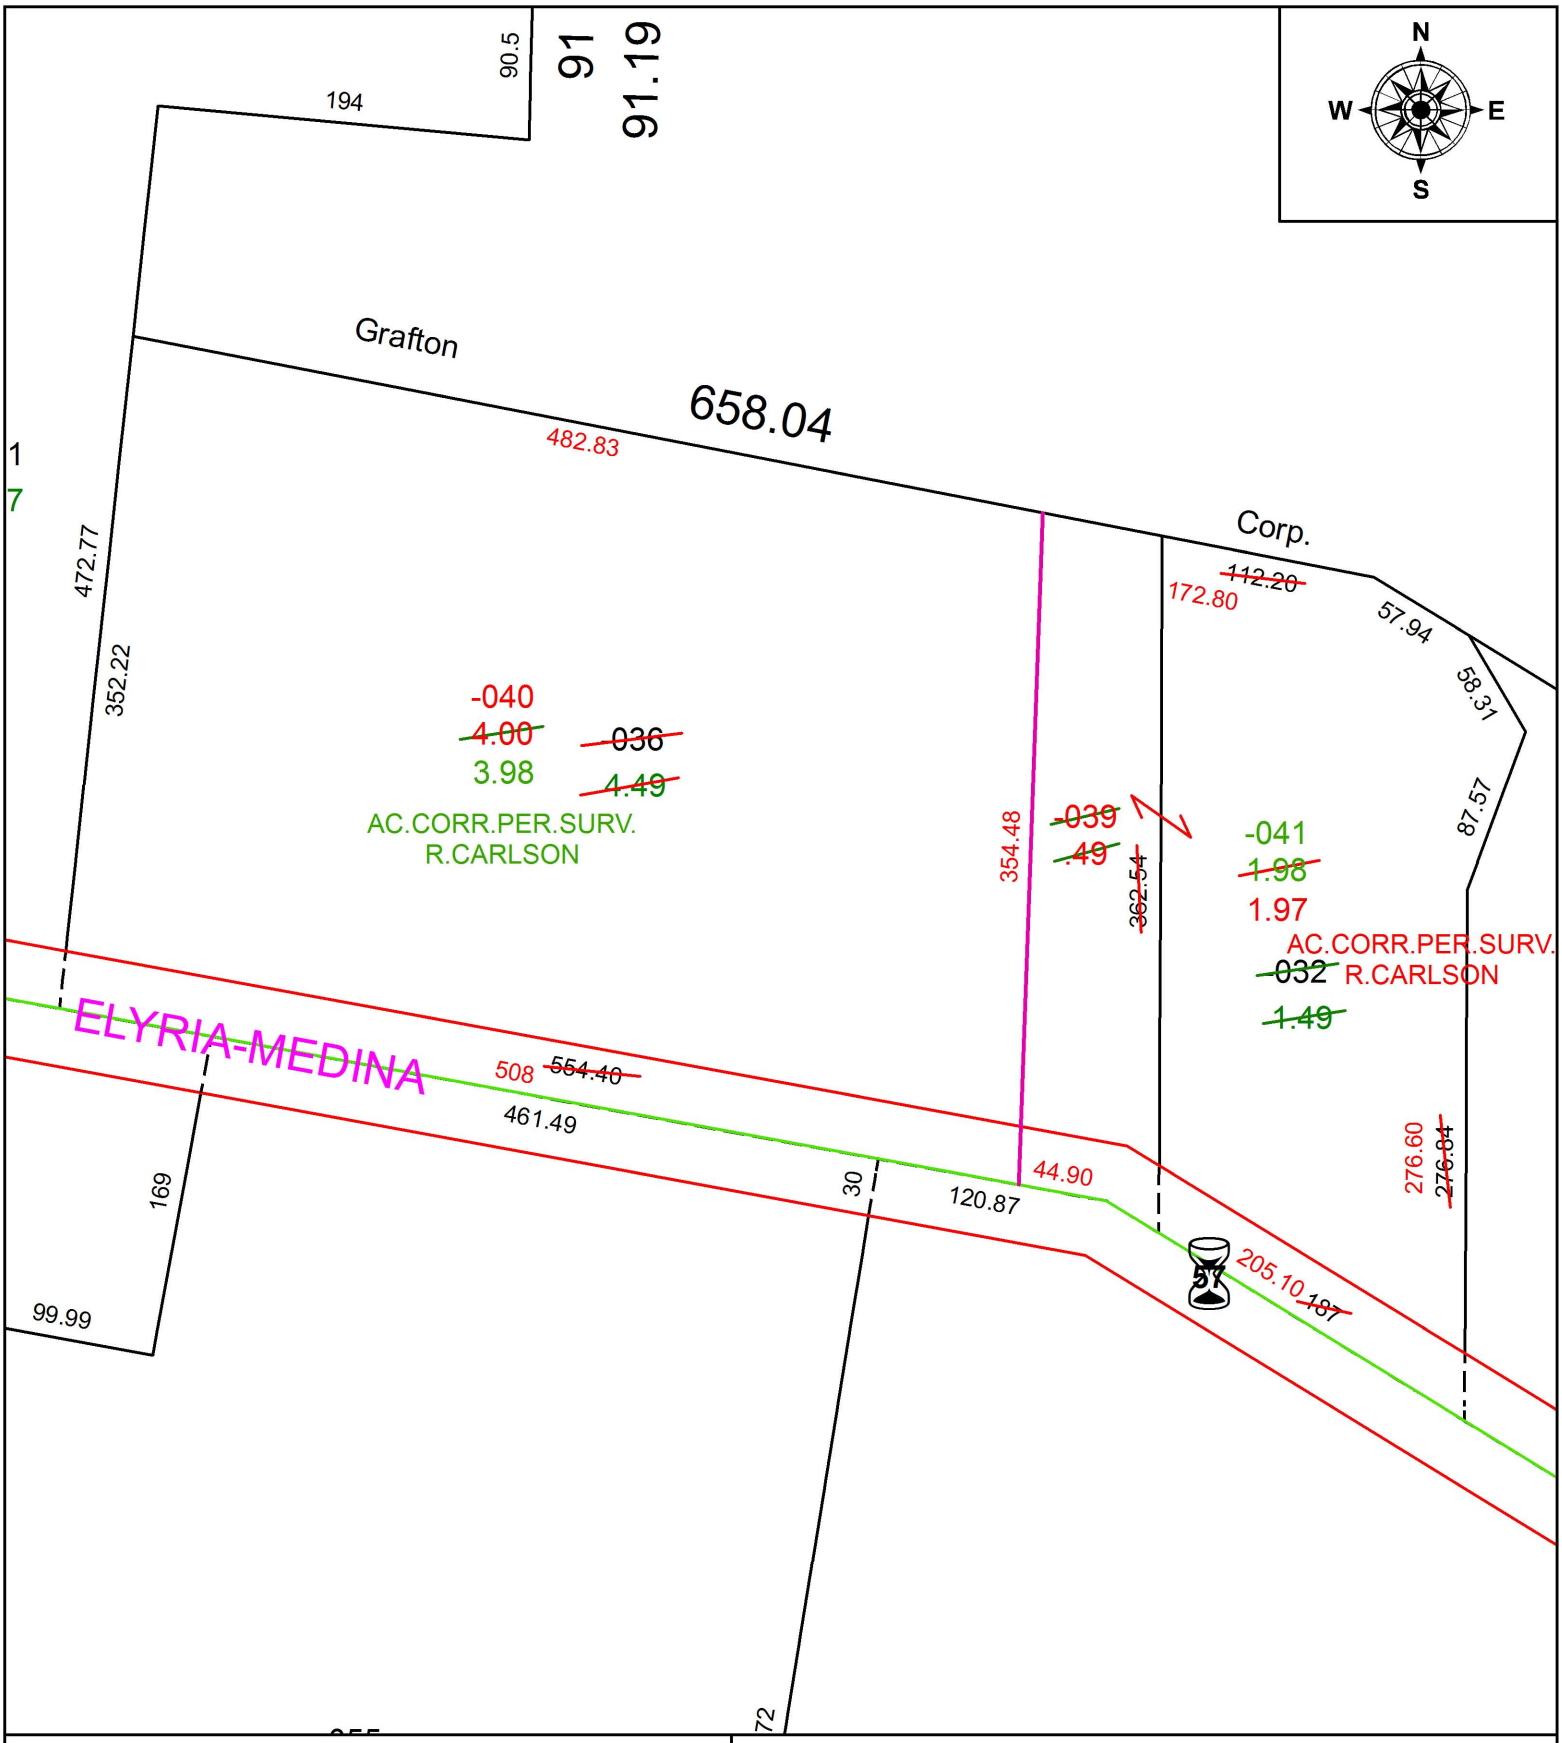

SPLITS/DEEDS PROCESSED
LORAIN COUNTY TAX MAP DEPARTMENT
226 MIDDLE AVE. ELYRIA, OH

SURVEYED BY: RICHARD D. CARLSON
CLOSURE: 1: 100,256
MAP PAGE(S): 16-00-018
APPOVED BY: RRM **DATE:** 10-26-18
SCALE: 1" = 100 **PRIOR INSTRUMENT:** 20150540195