PARENT PARCEL: 16-00-012-000-046
CHILD PARCEL: 16-00-012-000-049, -050
STARTING POINT: INTERSECTION OF C/L OF COWLEY RD. AND C/L OF GRAFTON-EASTERN RD,

18-03897

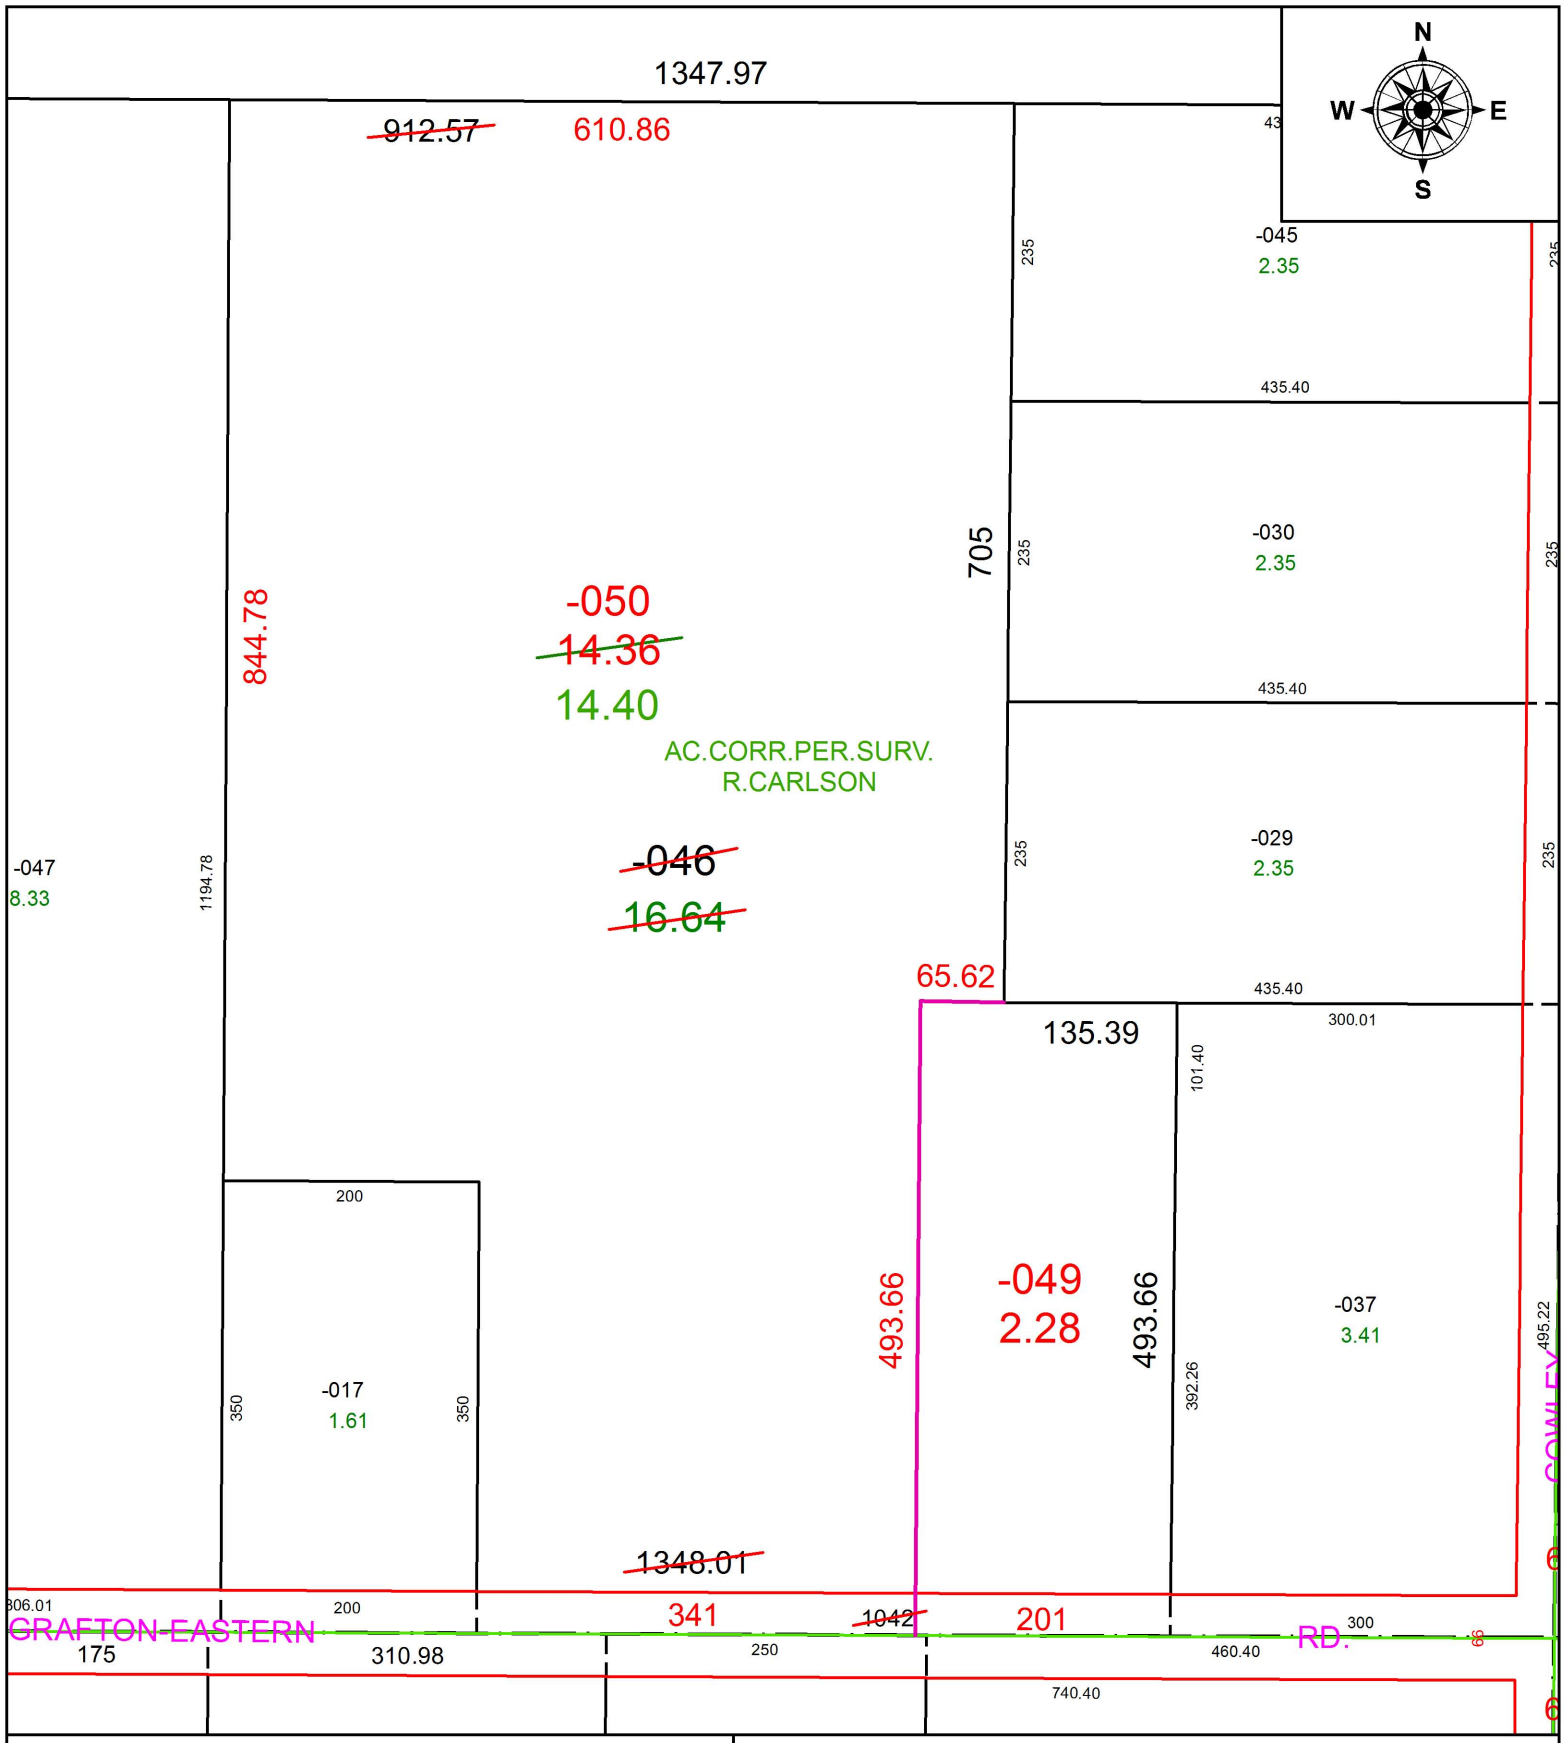

SPLITS/DEEDS PROCESSED
LORAIN COUNTY TAX MAP DEPARTMENT
226 MIDDLE AVE. ELYRIA, OH

SURVEYED BY: RICHARD D. CARLSON
CLOSURE: 1: 315,108
MAP PAGE(S): 16-00-012
APPOVED BY: RRM **DATE:** 10-30-18
SCALE: 1" = 150 **PRIOR INSTRUMENT:** 20170645095