PARENT PARCEL: ADD TO DUP.
CHILD PARCEL: 04-00-030-104-026
STARTING POINT: N/A

18-03899-C

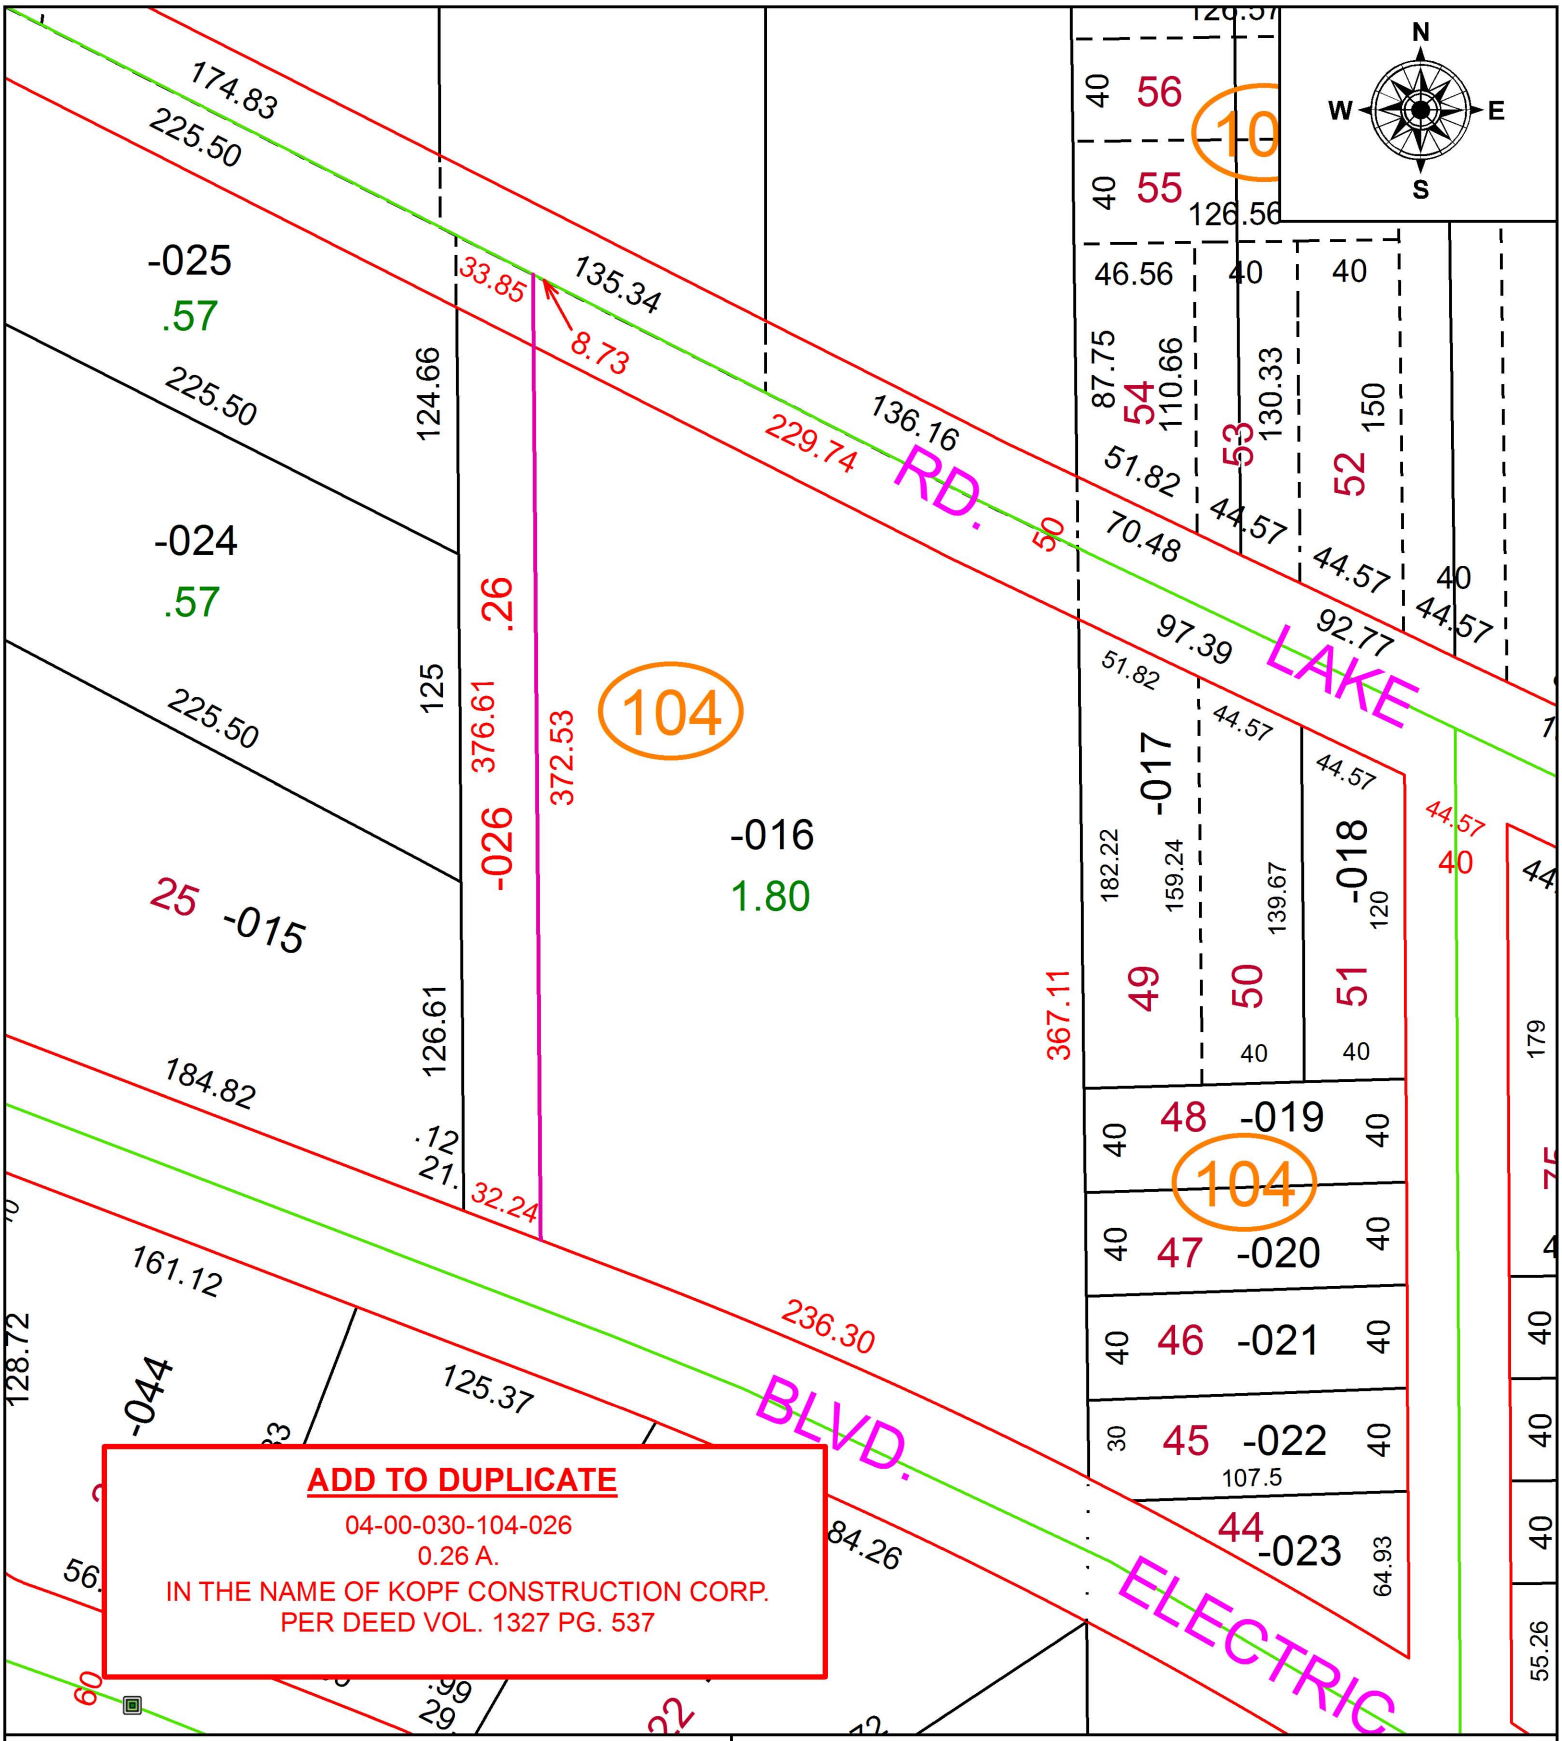

ADD TO DUPLICATE
04-00-030-104-026
0.26 A.
IN THE NAME OF KOPF CONSTRUCTION CORP.
PER DEED VOL. 1327 PG. 537

SPLITS/DEEDS PROCESSED
LORAIN COUNTY TAX MAP DEPARTMENT
226 MIDDLE AVE. ELYRIA, OH

SURVEYED BY: N/A
CLOSURE: N/A
MAP PAGE(S): 4-00-030
APPOVED BY: RRM **DATE:** 5-31-18
SCALE: 1" = 75 **PRIOR INSTRUMENT:** DV 1327/537