PARENT PARCEL: 07-00-003-102-057, -058

CHILD PARCEL: 07-00-003-102-095 THRU -097

STARTING POINT: NORTHEAST CORNER OF O.L.3

18-03899

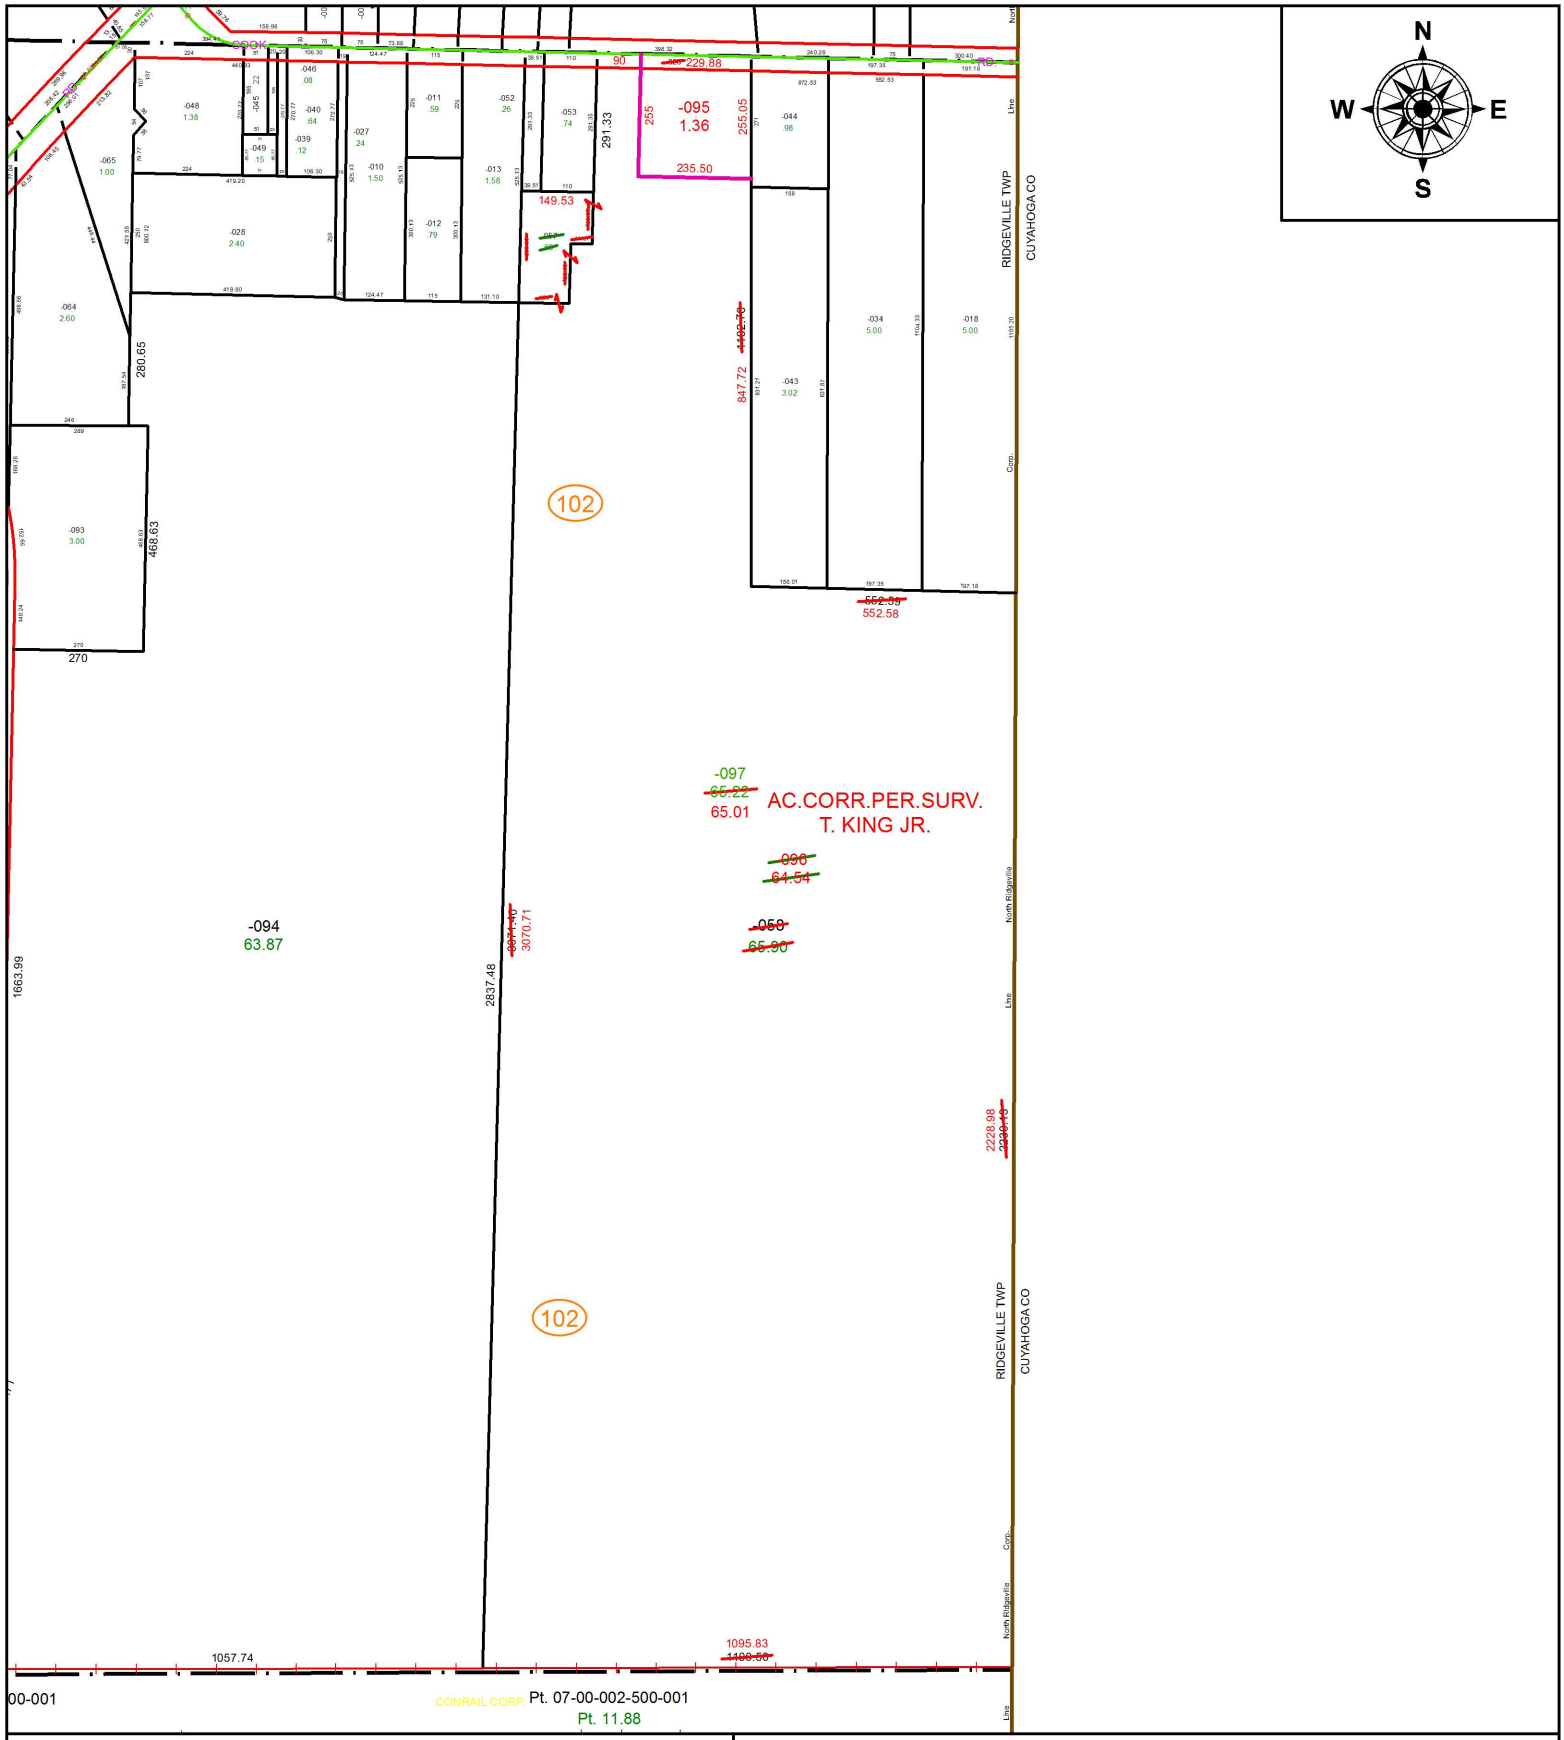

SPLITS/DEEDS PROCESSED

LORAIN COUNTY TAX MAP DEPARTMENT
226 MIDDLE AVE. ELYRIA, OH

SURVEYED BY: THOMAS JAMES KING JR.
CLOSURE: 1: 132,954
MAP PAGE(S): 7-00-003
APPOVED BY: RRM **DATE:** 11-5-18
SCALE: 1" = 400 **PRIOR INSTRUMENT:** 20130469559