PARENT PARCEL: 05-00-040-106-072
CHILD PARCEL: XX-XX-XXX-XXX-XXX
STARTING POINT: SOUTHEAST CORNER OF S/L 43 IN SHARONDALE ACES SUB. NO.2

18-03900-D

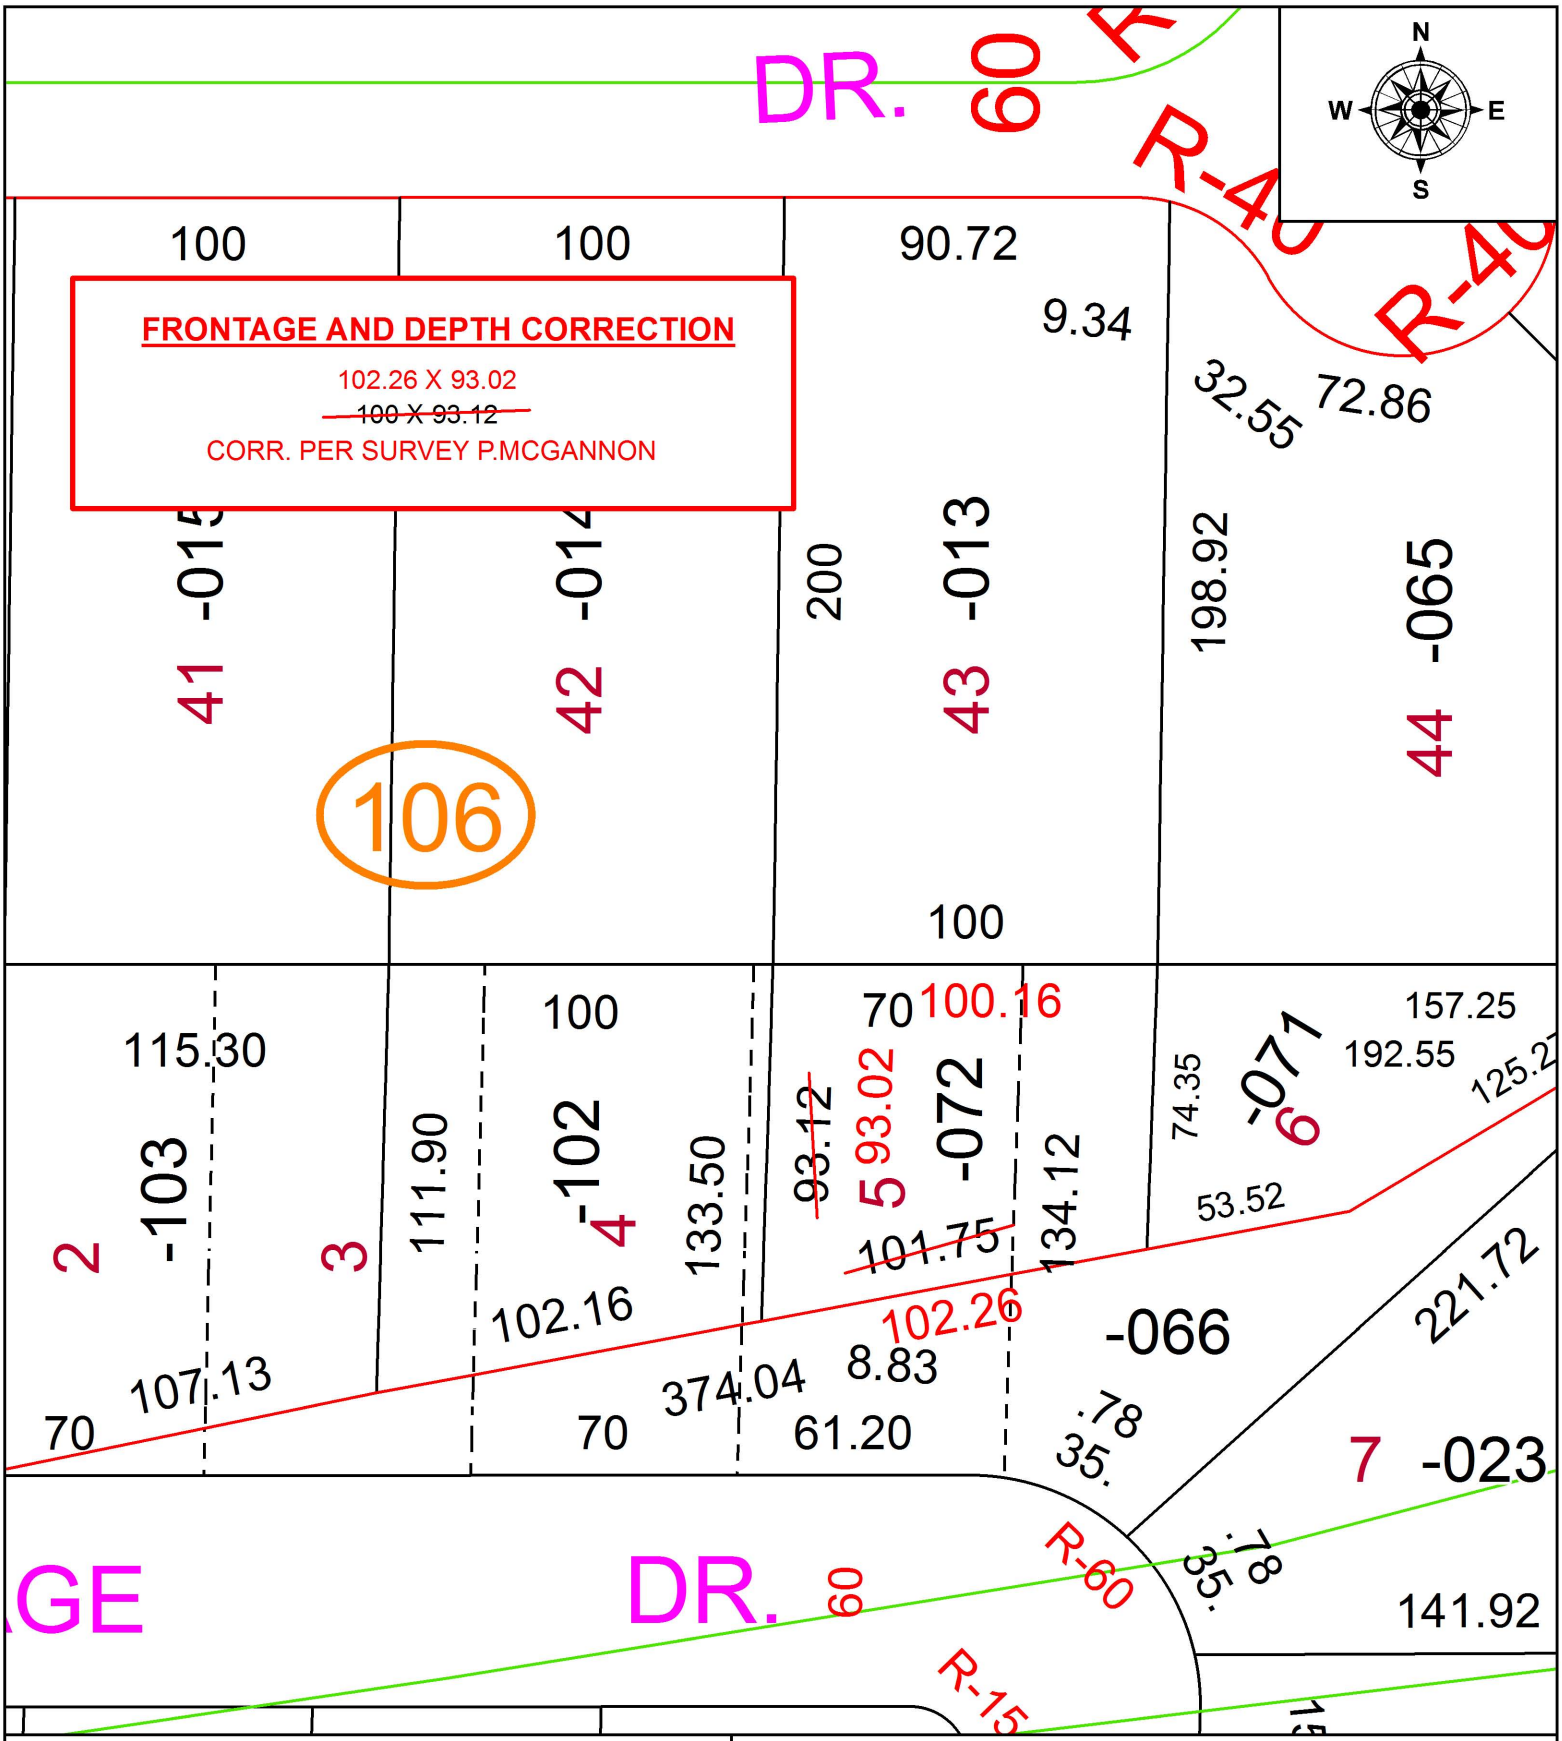

SPLITS/DEEDS PROCESSED
LORAIN COUNTY TAX MAP DEPARTMENT
226 MIDDLE AVE. ELYRIA, OH

SURVEYED BY: PATRICK A. MCGANNON
CLOSURE: 1: 52,941
MAP PAGE(S): 5-00-040
APPOVED BY: RRM **DATE:** 6-5-18
SCALE: 1" = 50 **PRIOR INSTRUMENT:** 20170616730