PARENT PARCEL: 11-00-012-000-007

CHILD PARCEL: 11-00-012-000-018, -019

STARTING POINT: INTERSECTION OF C/L OF REED RD. AND C/L OF DYE RD.

18-03903

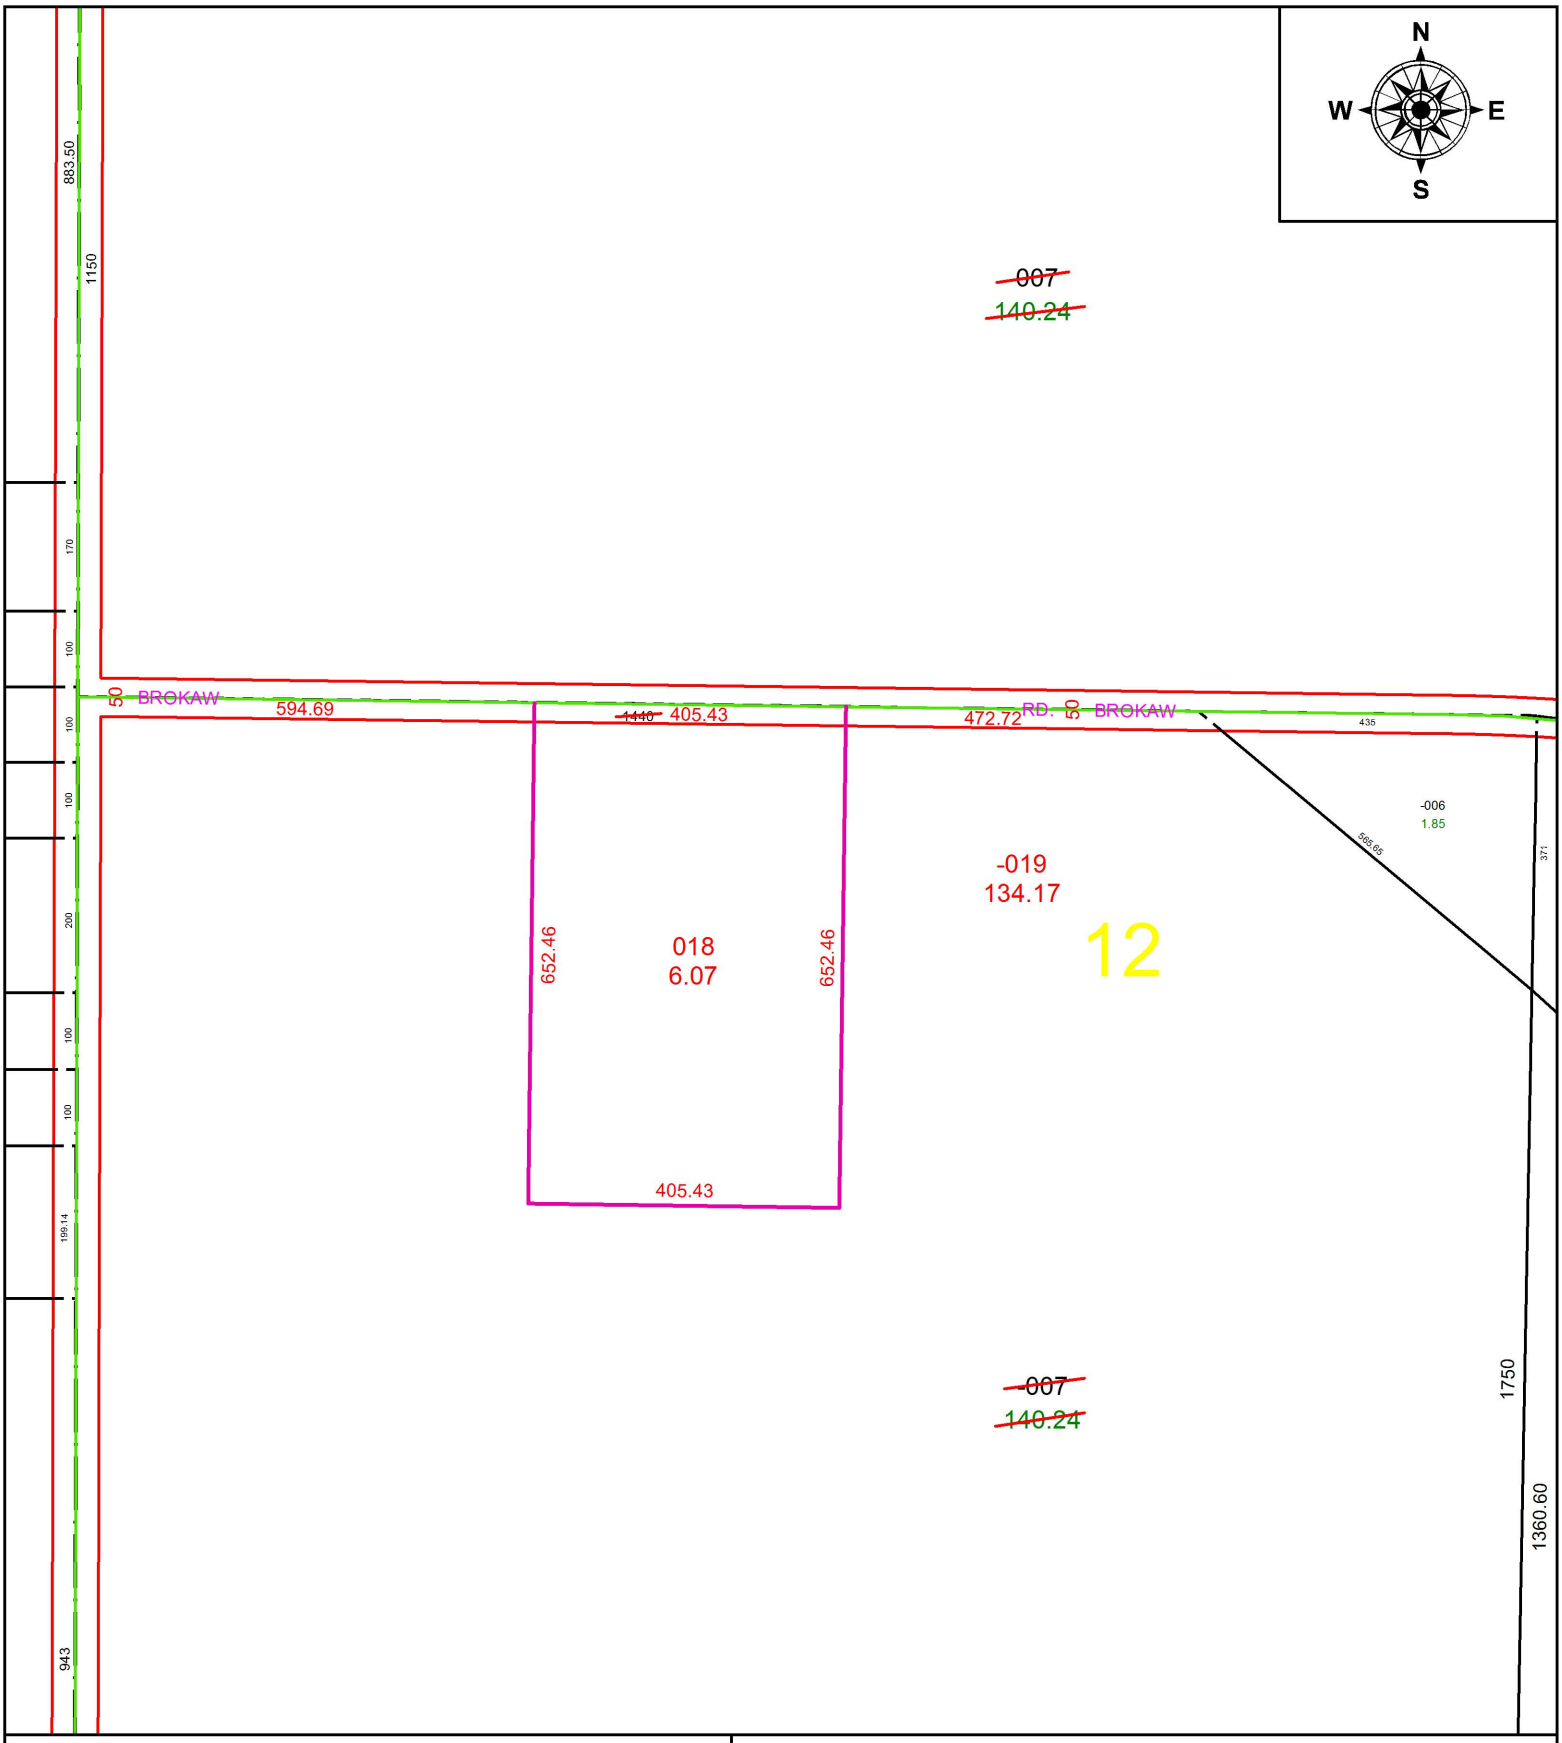

SPLITS/DEEDS PROCESSED

LORAIN COUNTY TAX MAP DEPARTMENT
226 MIDDLE AVE. ELYRIA, OH

SURVEYED BY: JOSHUA S, RIEDY

CLOSURE: 1: 2147483648

MAP PAGE(S): 11-00-012

APPOVED BY: RRM **DATE:** 11-8-18

SCALE: 1" = 250 **PRIOR INSTRUMENT:** OR 905/954