PARENT PARCEL: 05-00-006-000-144, -255

CHILD PARCEL: 05-00-006-000-256 THRU -258

STARTING POINT: INTERSECTION OF SOUTH LINE OF MIDDLE RIDGE RD. AND WEST LINE OF TOWER LN.

18-03908

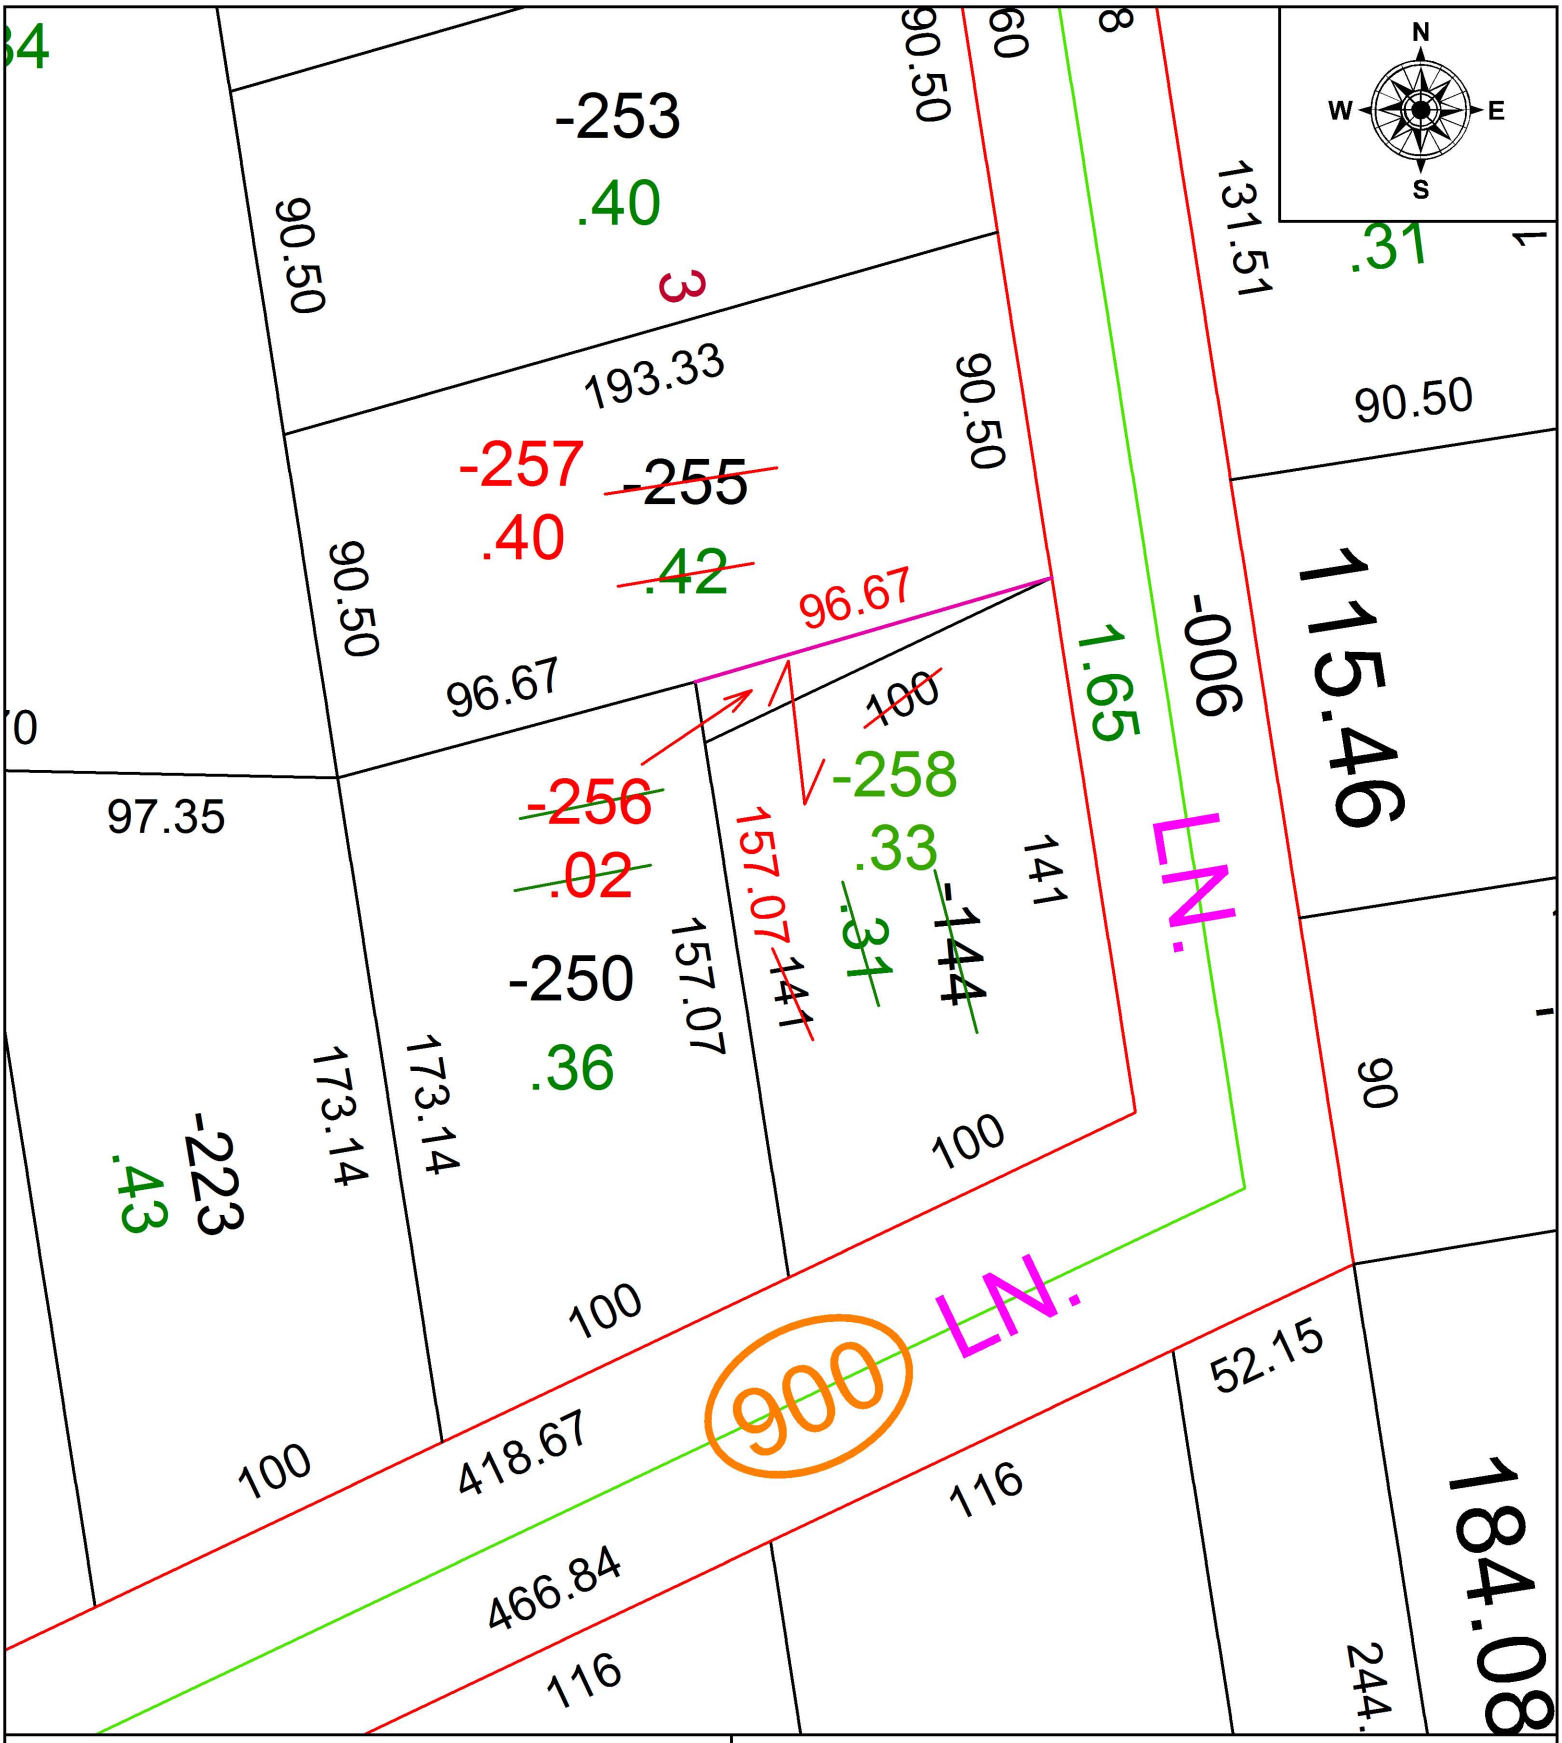

SPLITS/DEEDS PROCESSED

LORAIN COUNTY TAX MAP DEPARTMENT
226 MIDDLE AVE. ELYRIA, OH

SURVEYED BY: TIMOTHY D. HOZALSKI
CLOSURE: 1: 91,316
MAP PAGE(S): 5-00-006
APPOVED BY: RRM **DATE:** 12-3-18
SCALE: 1" = 50 **PRIOR INSTRUMENT:** 20160611423