**PARENT PARCEL:** 11-00-010-000-013, -026, -027

**CHILD PARCEL:** 11-00-010-000-058

**STARTING POINT:** INTERSECTION OF C/L OF ROOT RD. AND NORTH LINE OF O.L.10

# 18-03910

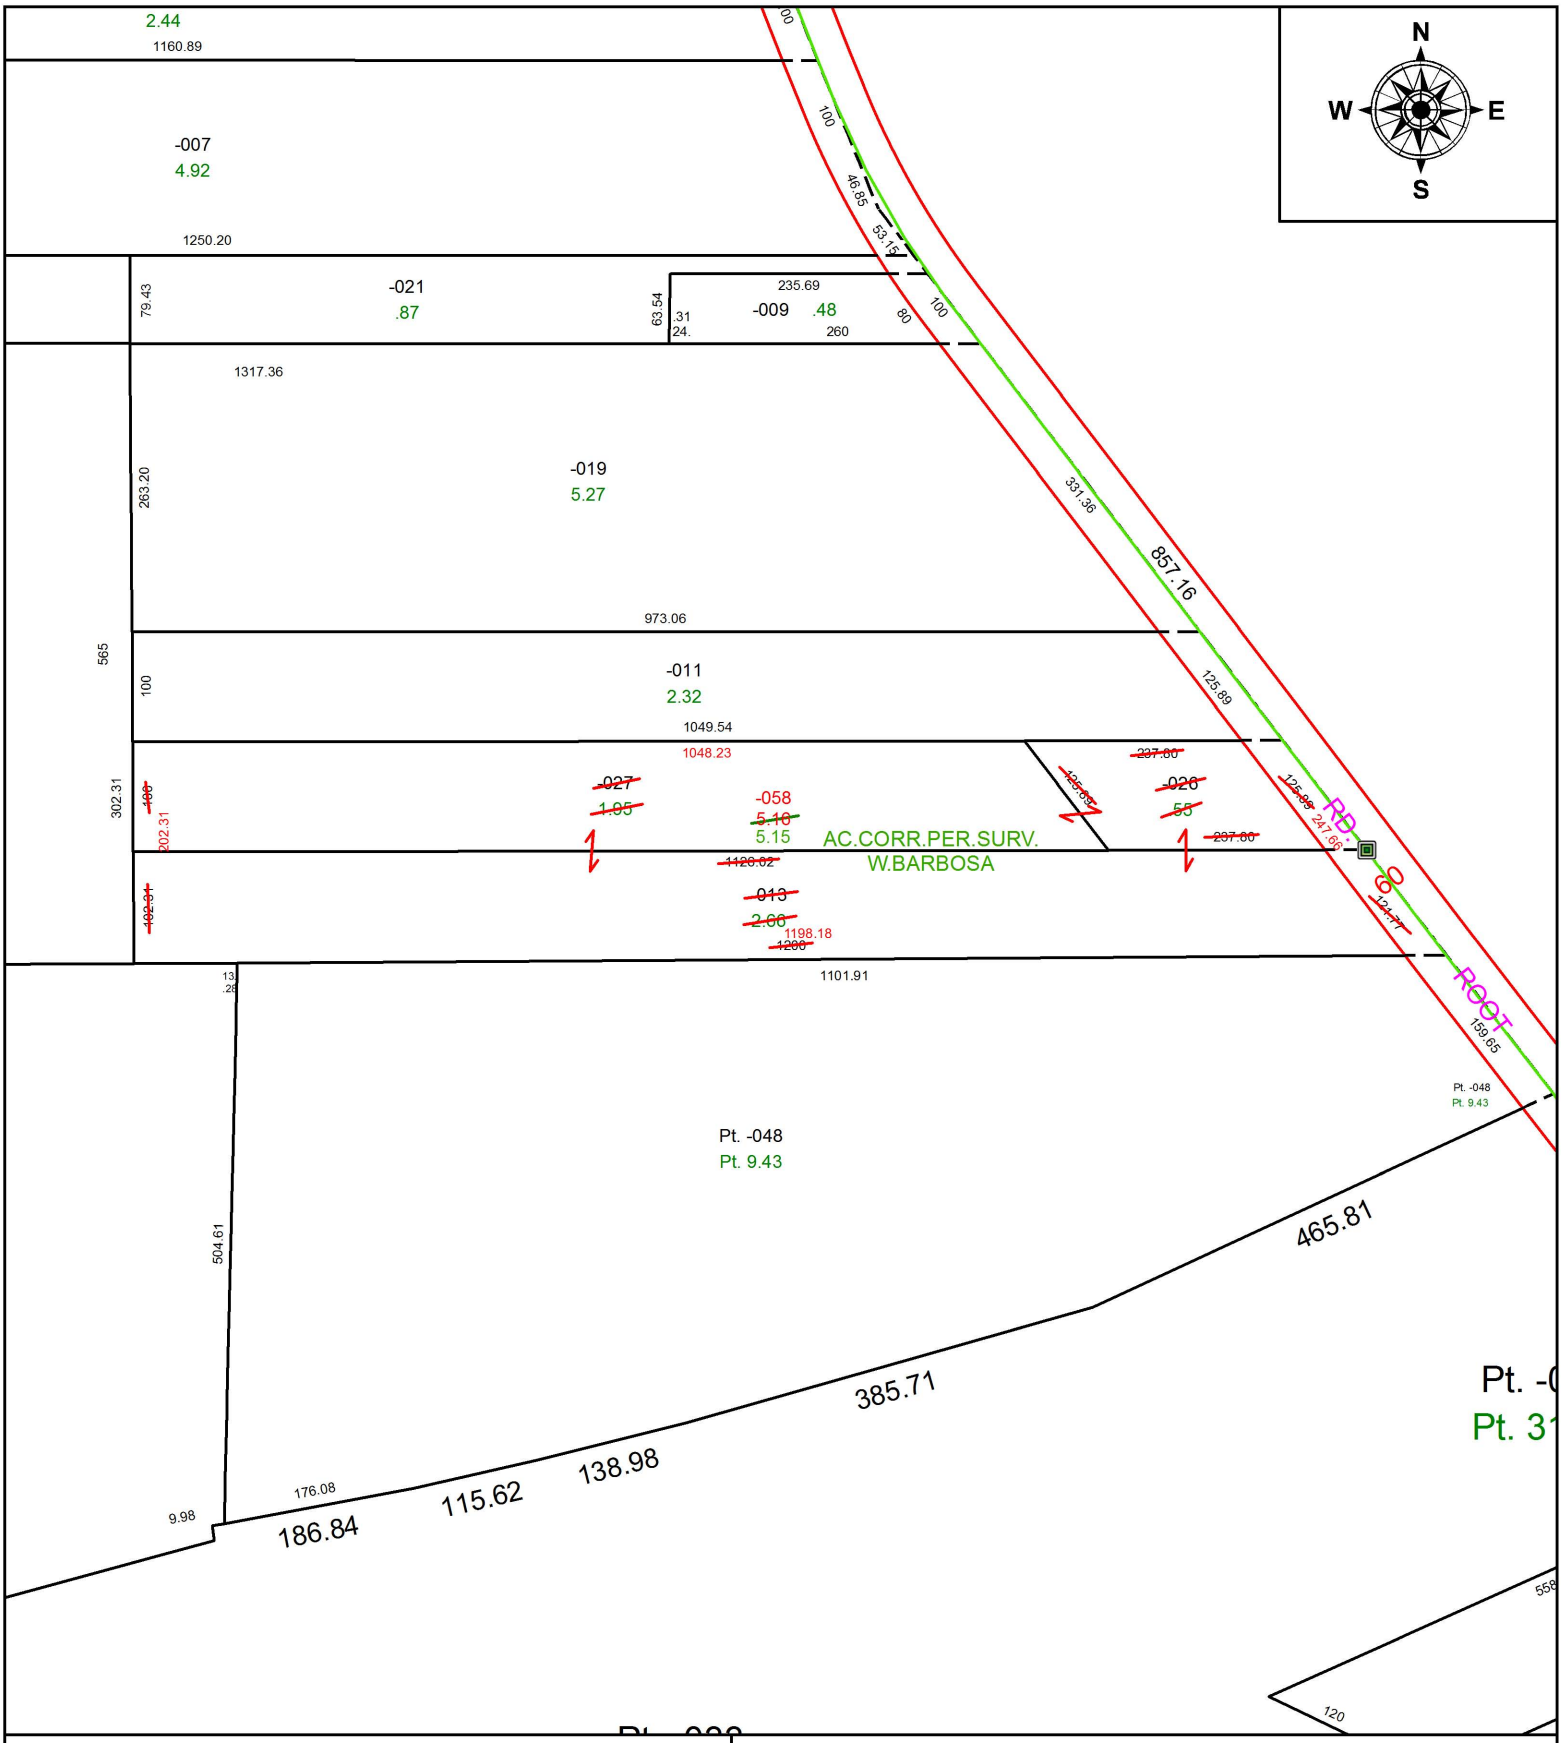


**SPLITS/DEEDS PROCESSED**

LORAIN COUNTY TAX MAP DEPARTMENT
226 MIDDLE AVE. ELYRIA, OH

**SURVEYED BY:** WILFREDO BARBOSA
**CLOSURE:** 1: 850,743
**MAP PAGE(S):** 11-00-010
**APPOVED BY:** RRM **DATE:** 12-4-18
**SCALE:** 1" = 175 **PRIOR INSTRUMENT:** 20170620133