PARENT PARCEL: 19-06-117-000-005, -028

CHILD PARCEL: 19-06-117-000-033

STARTING POINT: INTERSECTION OF C/L OF PECK WADSWORTH RD, AND C/L OF NICKLE PLATE DIAGONAL RD.

18-03912-C

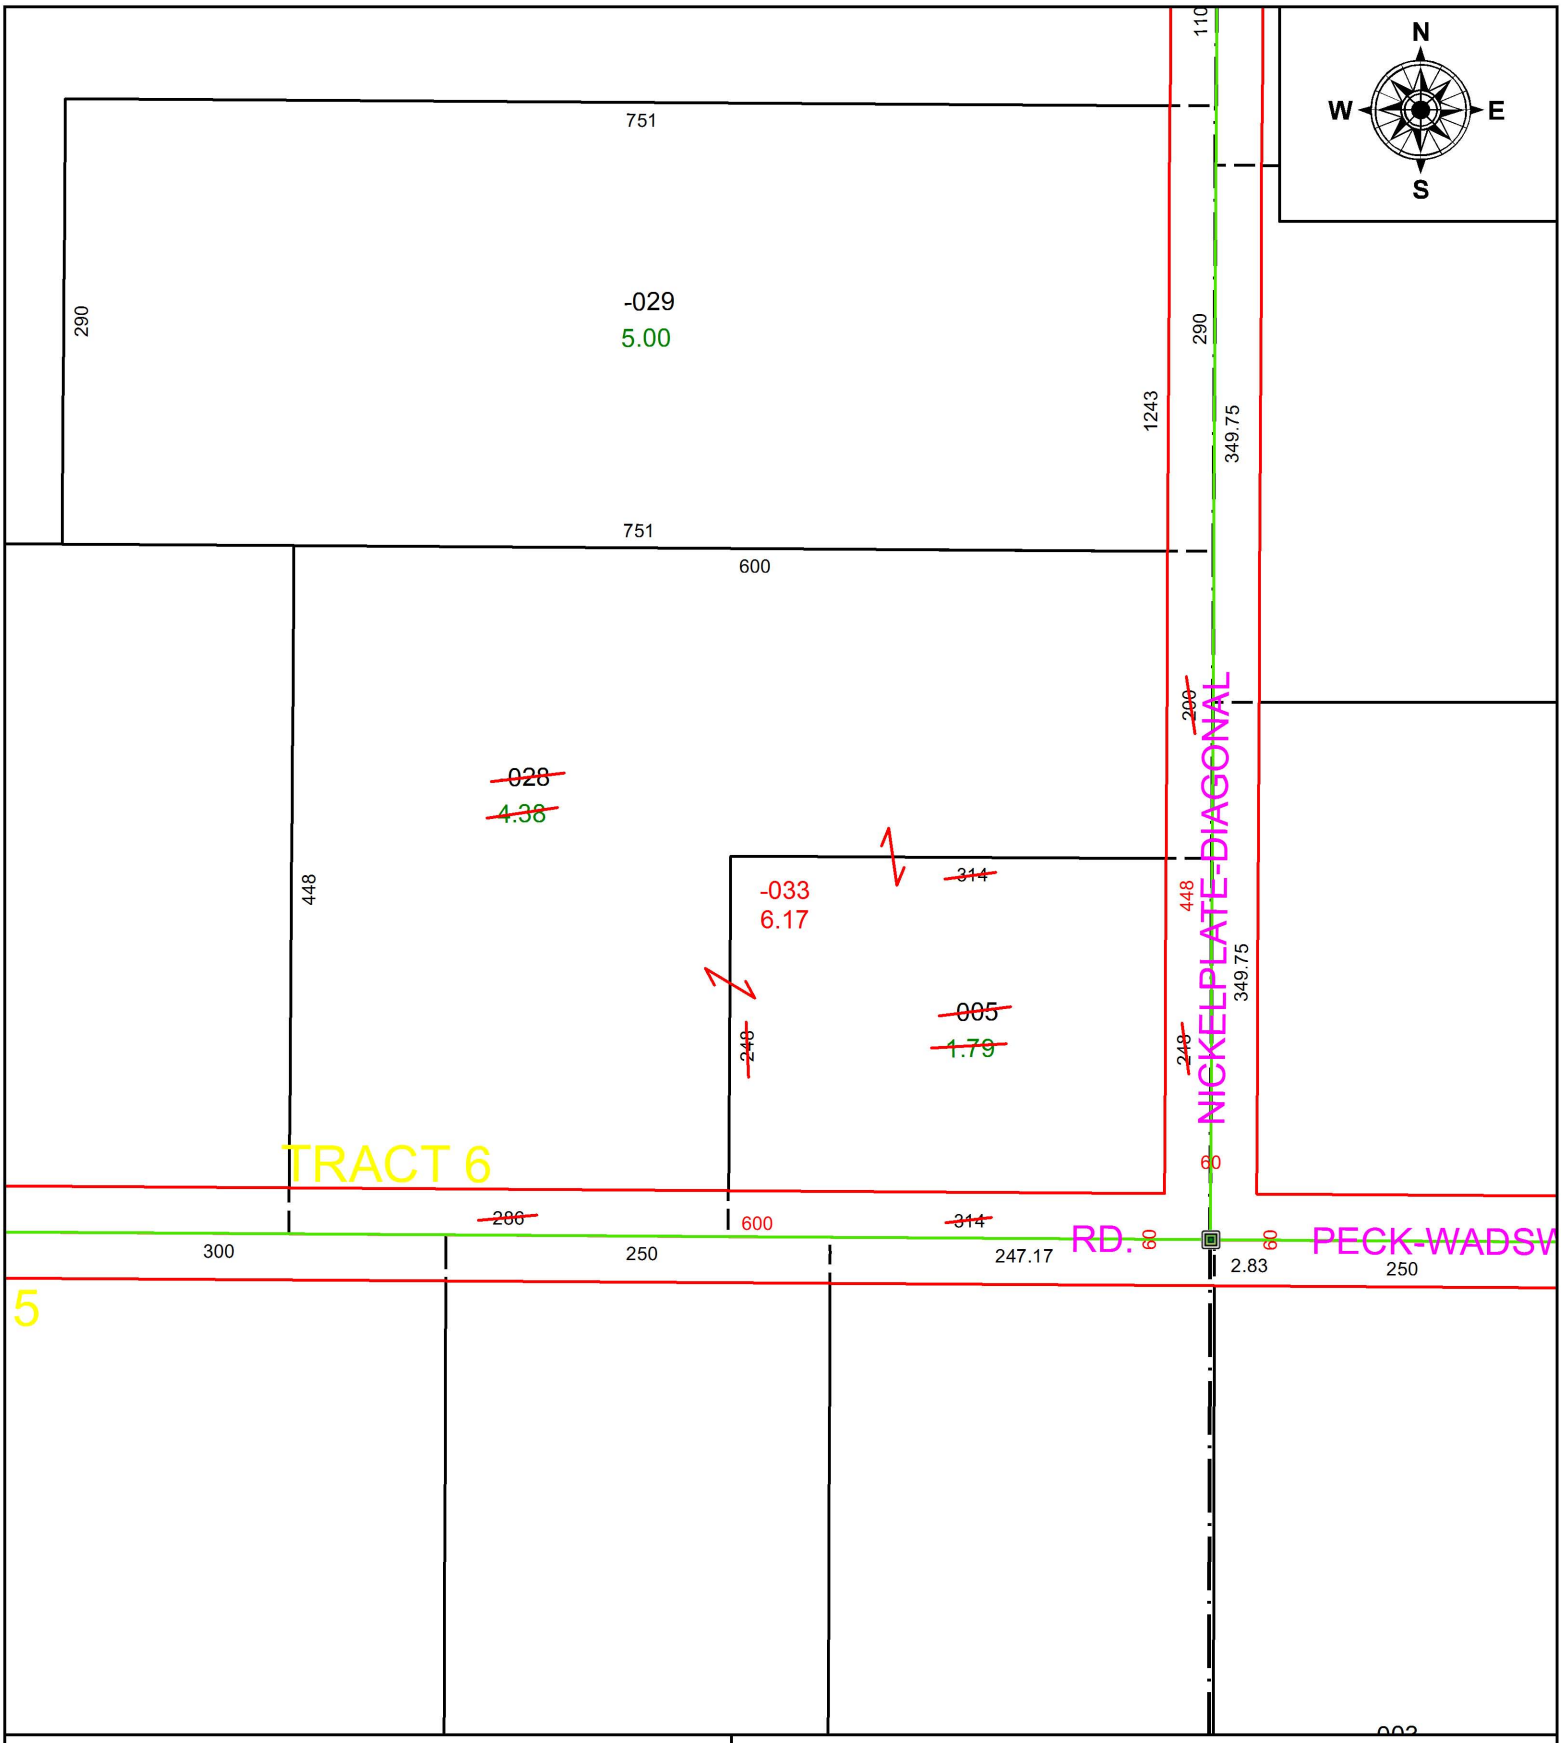

SPLITS/DEEDS PROCESSED

LORAIN COUNTY TAX MAP DEPARTMENT
226 MIDDLE AVE. ELYRIA, OH

SURVEYED BY: THOMAS A. SIMON
CLOSURE: 1: 2147483648
MAP PAGE(S): 19-A
APPOVED BY: RRM **DATE:** 6-14-18
SCALE: 1" = 125 **PRIOR INSTRUMENT:** 20170641753