PARENT PARCEL: 02-03-007-000-014

CHILD PARCEL: 02-03-007-000-237, 02-03-008-000-008

STARTING POINT: SOUTHEAST CORNER OF O.L.8

18-03912

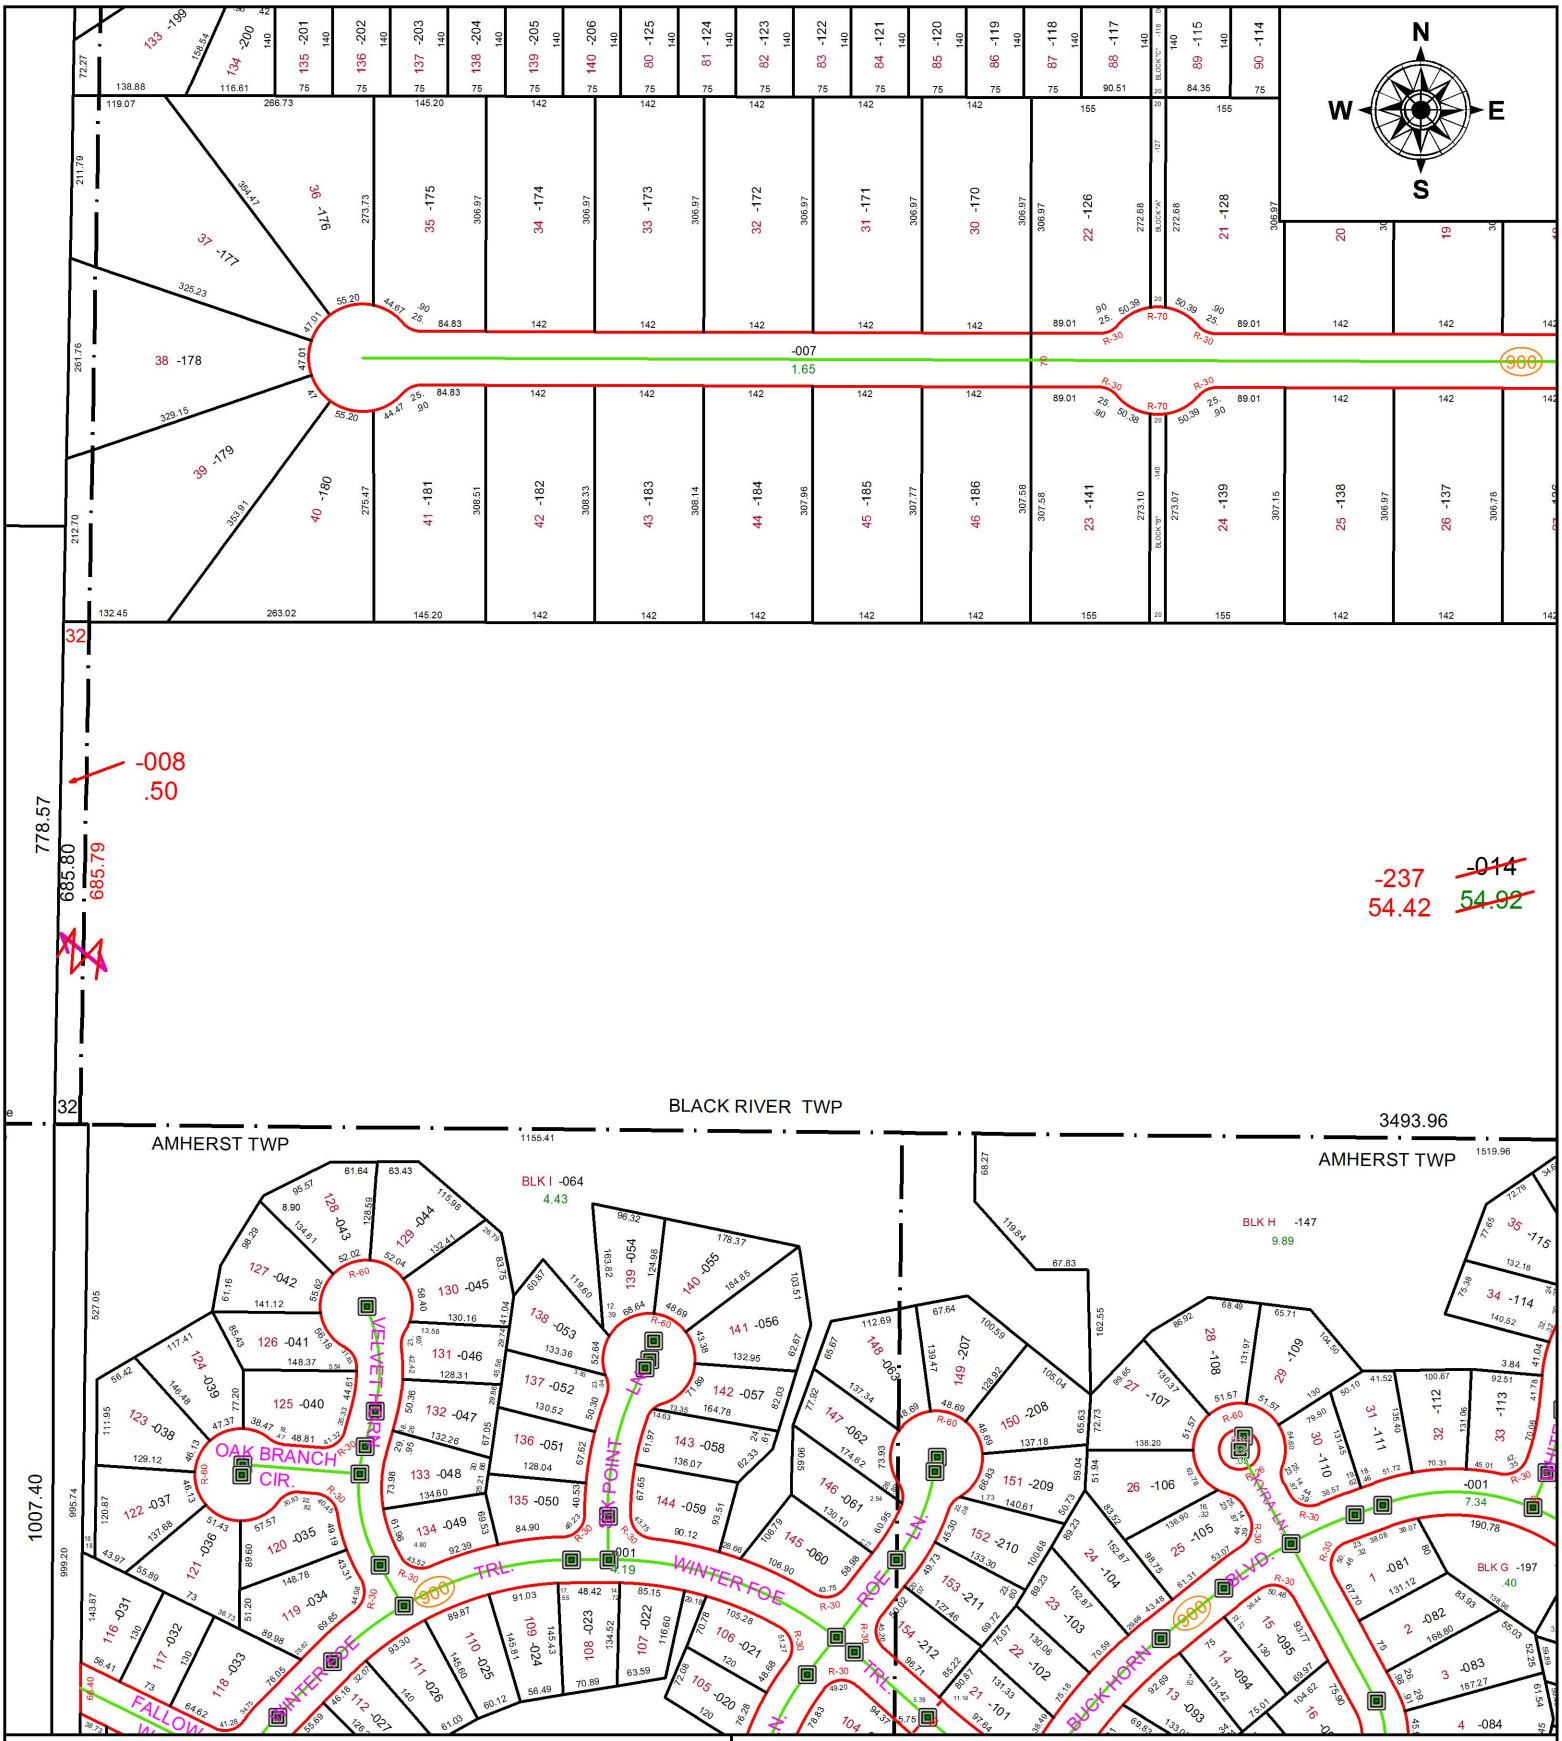

SPLITS/DEEDS PROCESSED

LORAIN COUNTY TAX MAP DEPARTMENT
226 MIDDLE AVE. ELYRIA, OH

SURVEYED BY: THOMAS M. SNEZEK
CLOSURE: 1:1,419,530
MAP PAGE(S): 02-03-007
APPOVED BY: RRM **DATE:** 12-7-18
SCALE: 1" = 250 **PRIOR INSTRUMENT:** 19990633735