PARENT PARCEL: 04-00-003-101-496, 04-00-004-102-192

CHILD PARCEL: 04-00-003-101-586, -587, 04-00-004-102-192

STARTING POINT: INTERSECTION OF C/L OF S.R.611 AND C/L OF RECREATION LN.

18-03913

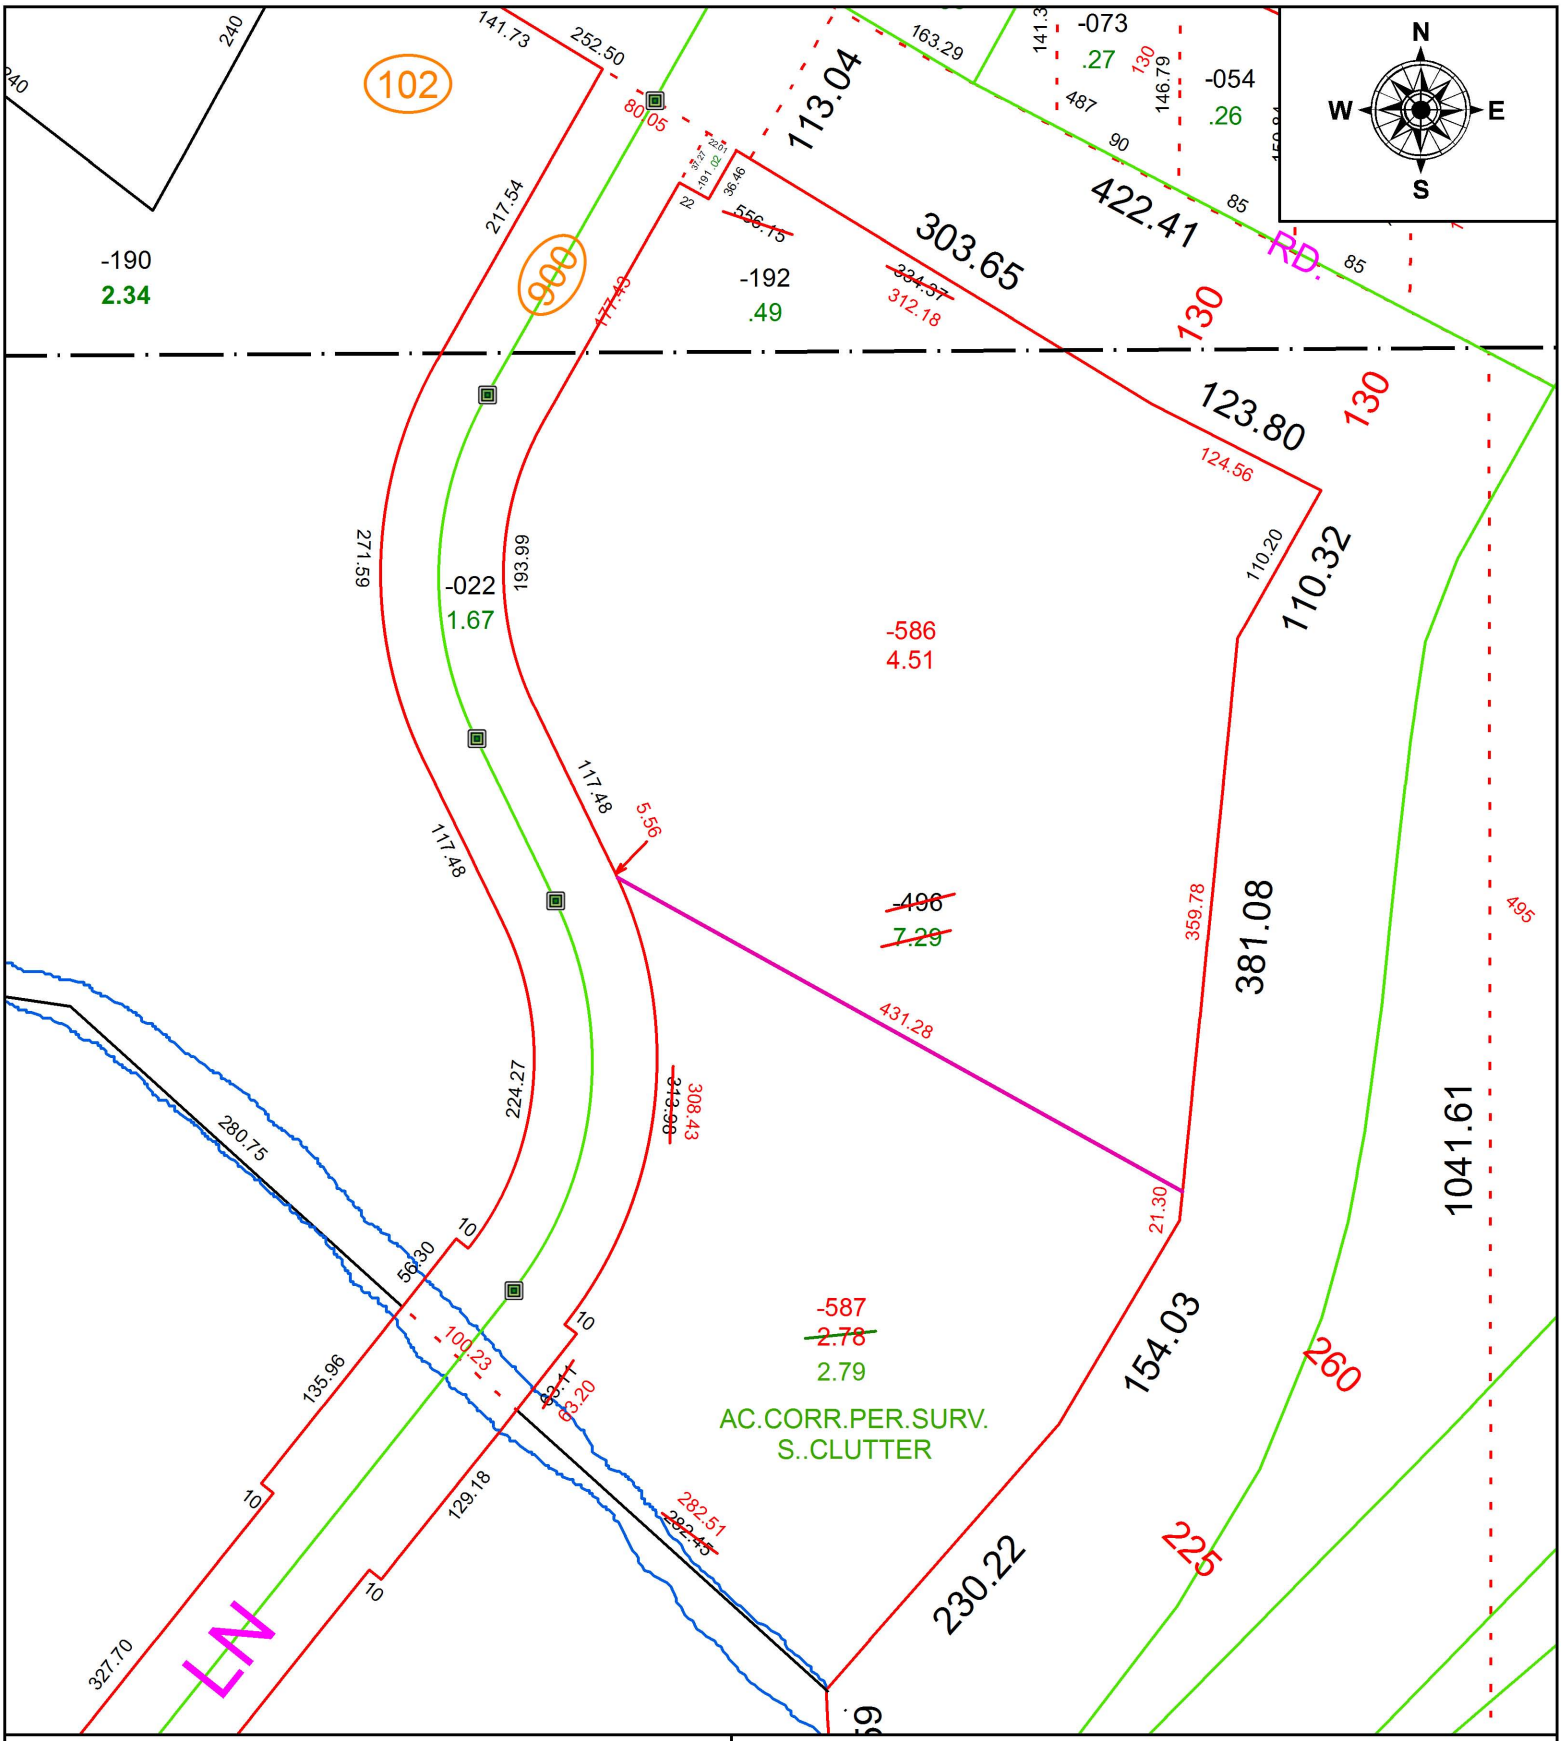

SPLITS/DEEDS PROCESSED

LORAIN COUNTY TAX MAP DEPARTMENT
226 MIDDLE AVE. ELYRIA, OH

SURVEYED BY: STEVEN W. CLUTTER
CLOSURE: 1: 237,830
MAP PAGE(S): 4-00-003
APPOVED BY: RRM **DATE:** 12-17-18
SCALE: 1" = 125 **PRIOR INSTRUMENT:** 20080266688