PARENT PARCEL: ADD TO DUP.
CHILD PARCEL: 11-00-051-900-003
STARTING POINT:

18-03915-C

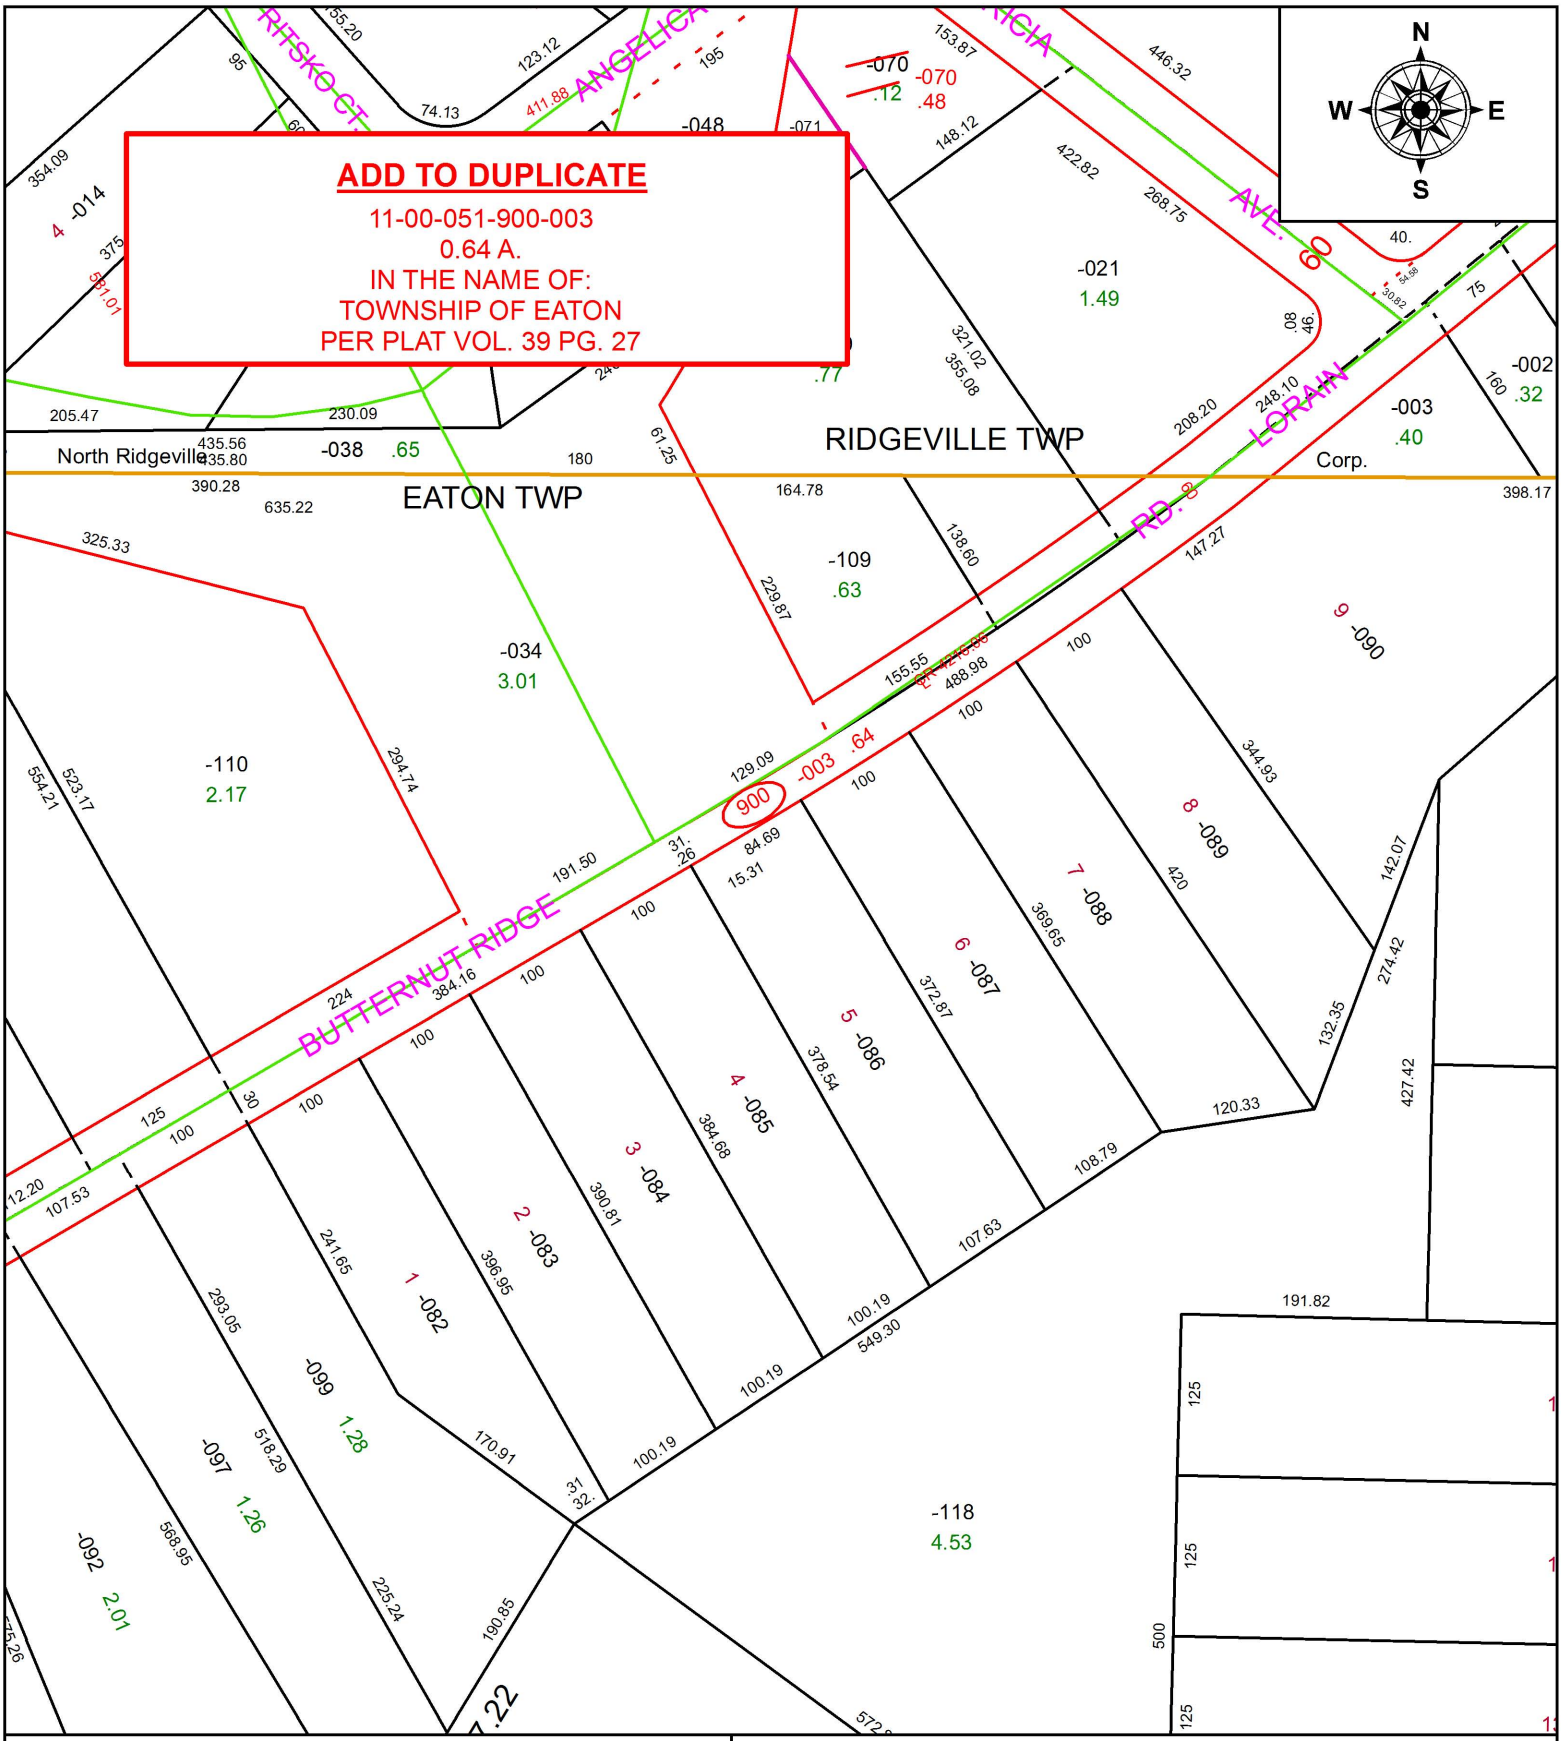

SPLITS/DEEDS PROCESSED
LORAIN COUNTY TAX MAP DEPARTMENT
226 MIDDLE AVE. ELYRIA, OH

SURVEYED BY: N/A
CLOSURE: N/A
MAP PAGE(S): 11-00-051
APPOVED BY: RRM **DATE:** 6-21-18
SCALE: 1" = 150 **PRIOR INSTRUMENT:** PLAT 39/27