PARENT PARCEL: 11-00-009-101-022
CHILD PARCEL: 11-00-009-101-031, -032
STARTING POINT: INTERSECTION OF C/L OF BROKAW RD. AND C/L OF HAWKE RD.

18-03916

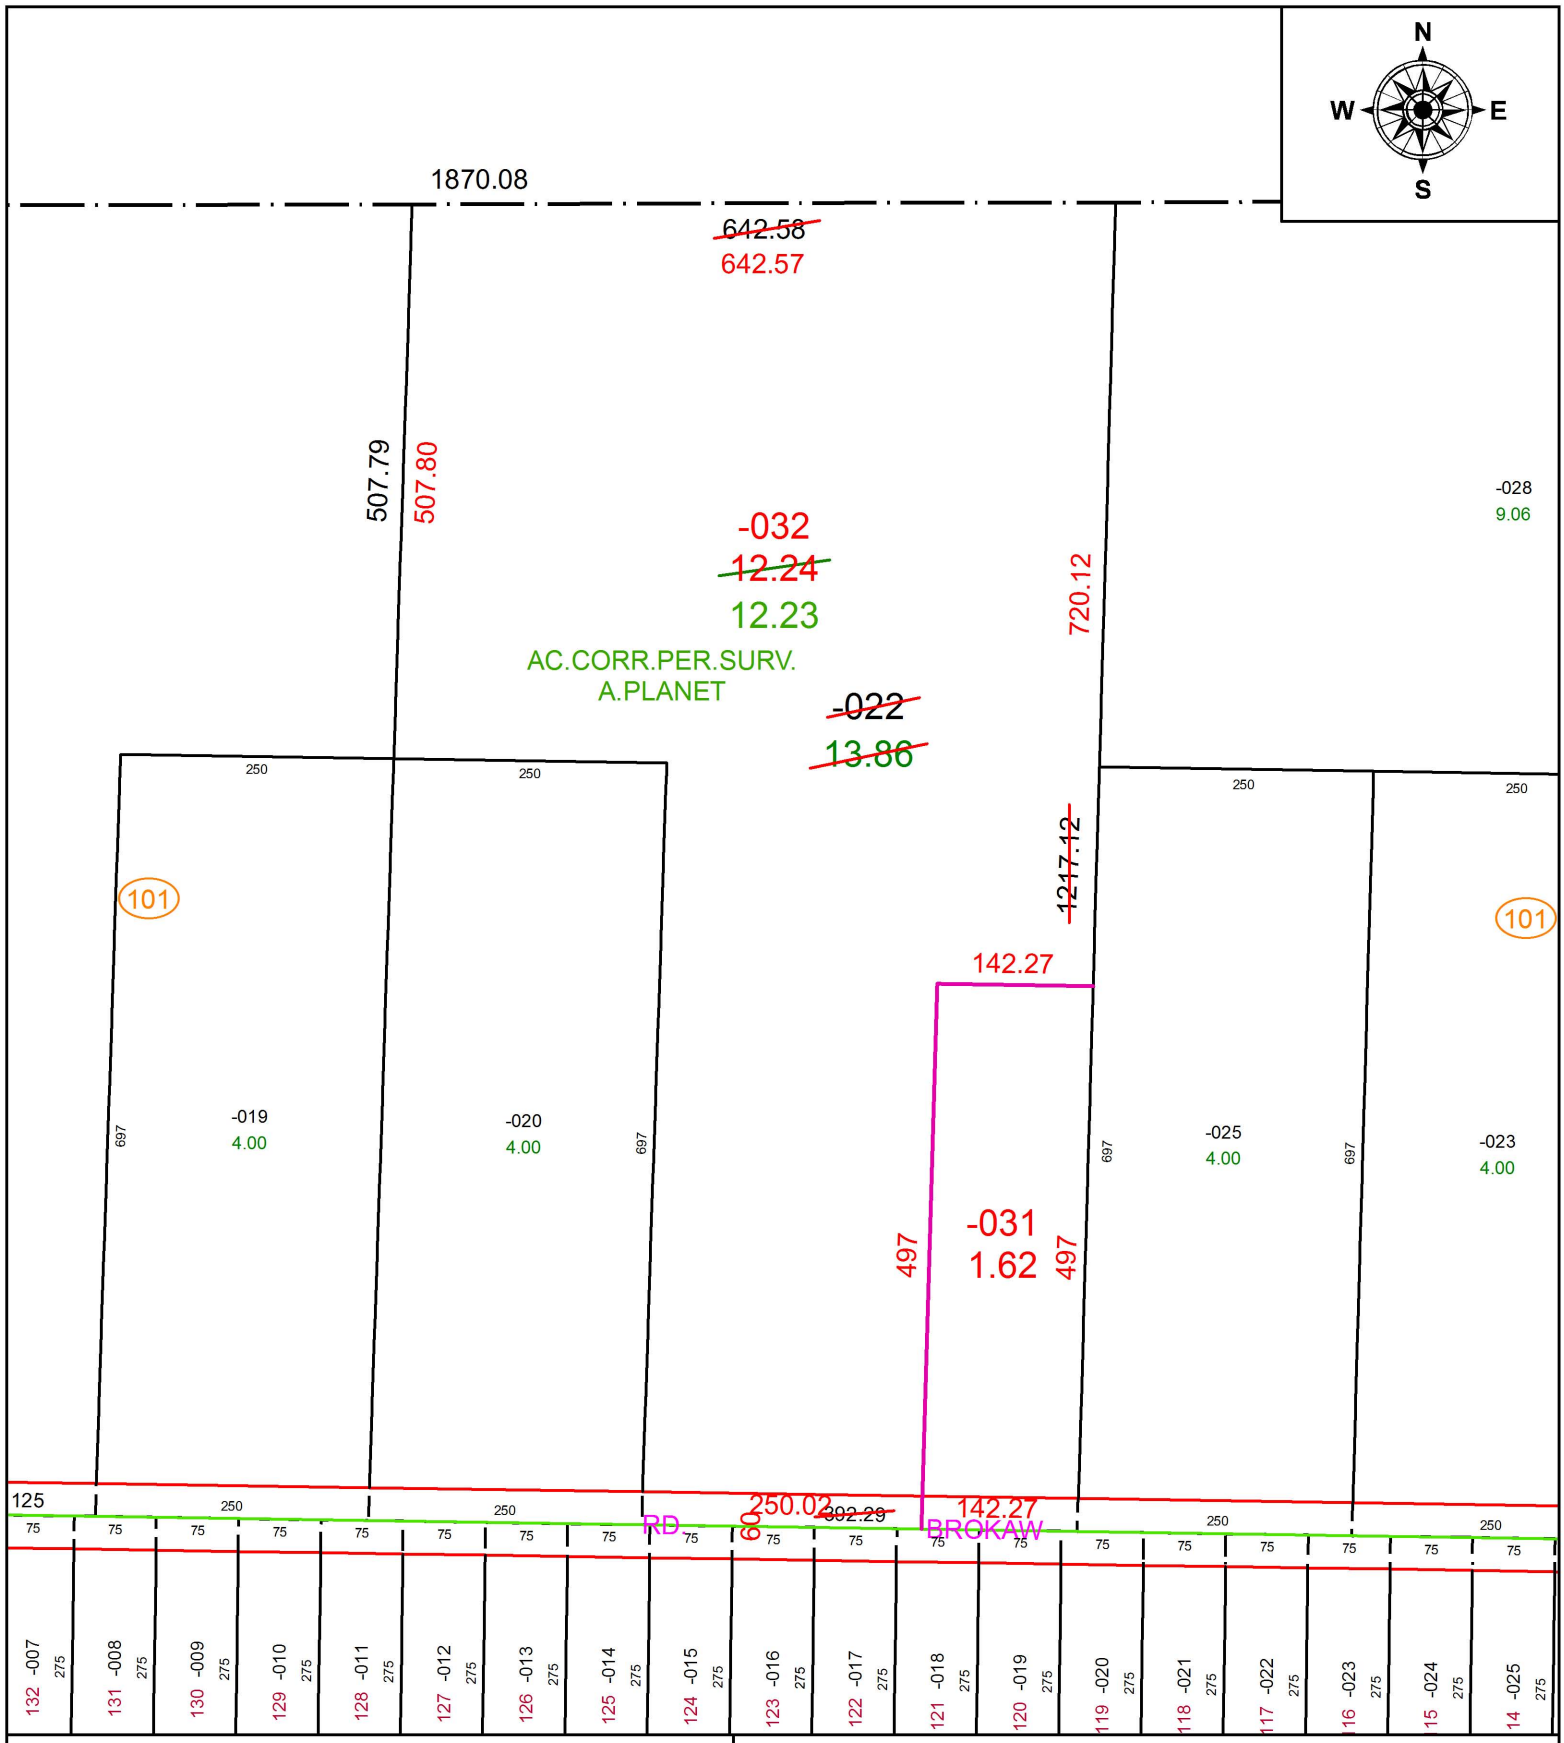

SPLITS/DEEDS PROCESSED

LORAIN COUNTY TAX MAP DEPARTMENT
226 MIDDLE AVE. ELYRIA, OH

SURVEYED BY: ANDREW G. PLANET
CLOSURE: 1:2147483648
MAP PAGE(S): 11-00-009
APPOVED BY: RRM **DATE:** 12-18-18
SCALE: 1" = 175 **PRIOR INSTRUMENT:** OR 551/112