PARENT PARCEL: 03-00-057-108-005
CHILD PARCEL: XX-XX-XXX-XXX-XXX
STARTING POINT: SOUTHEAST CORNER OF S/L 62

18-03917-D

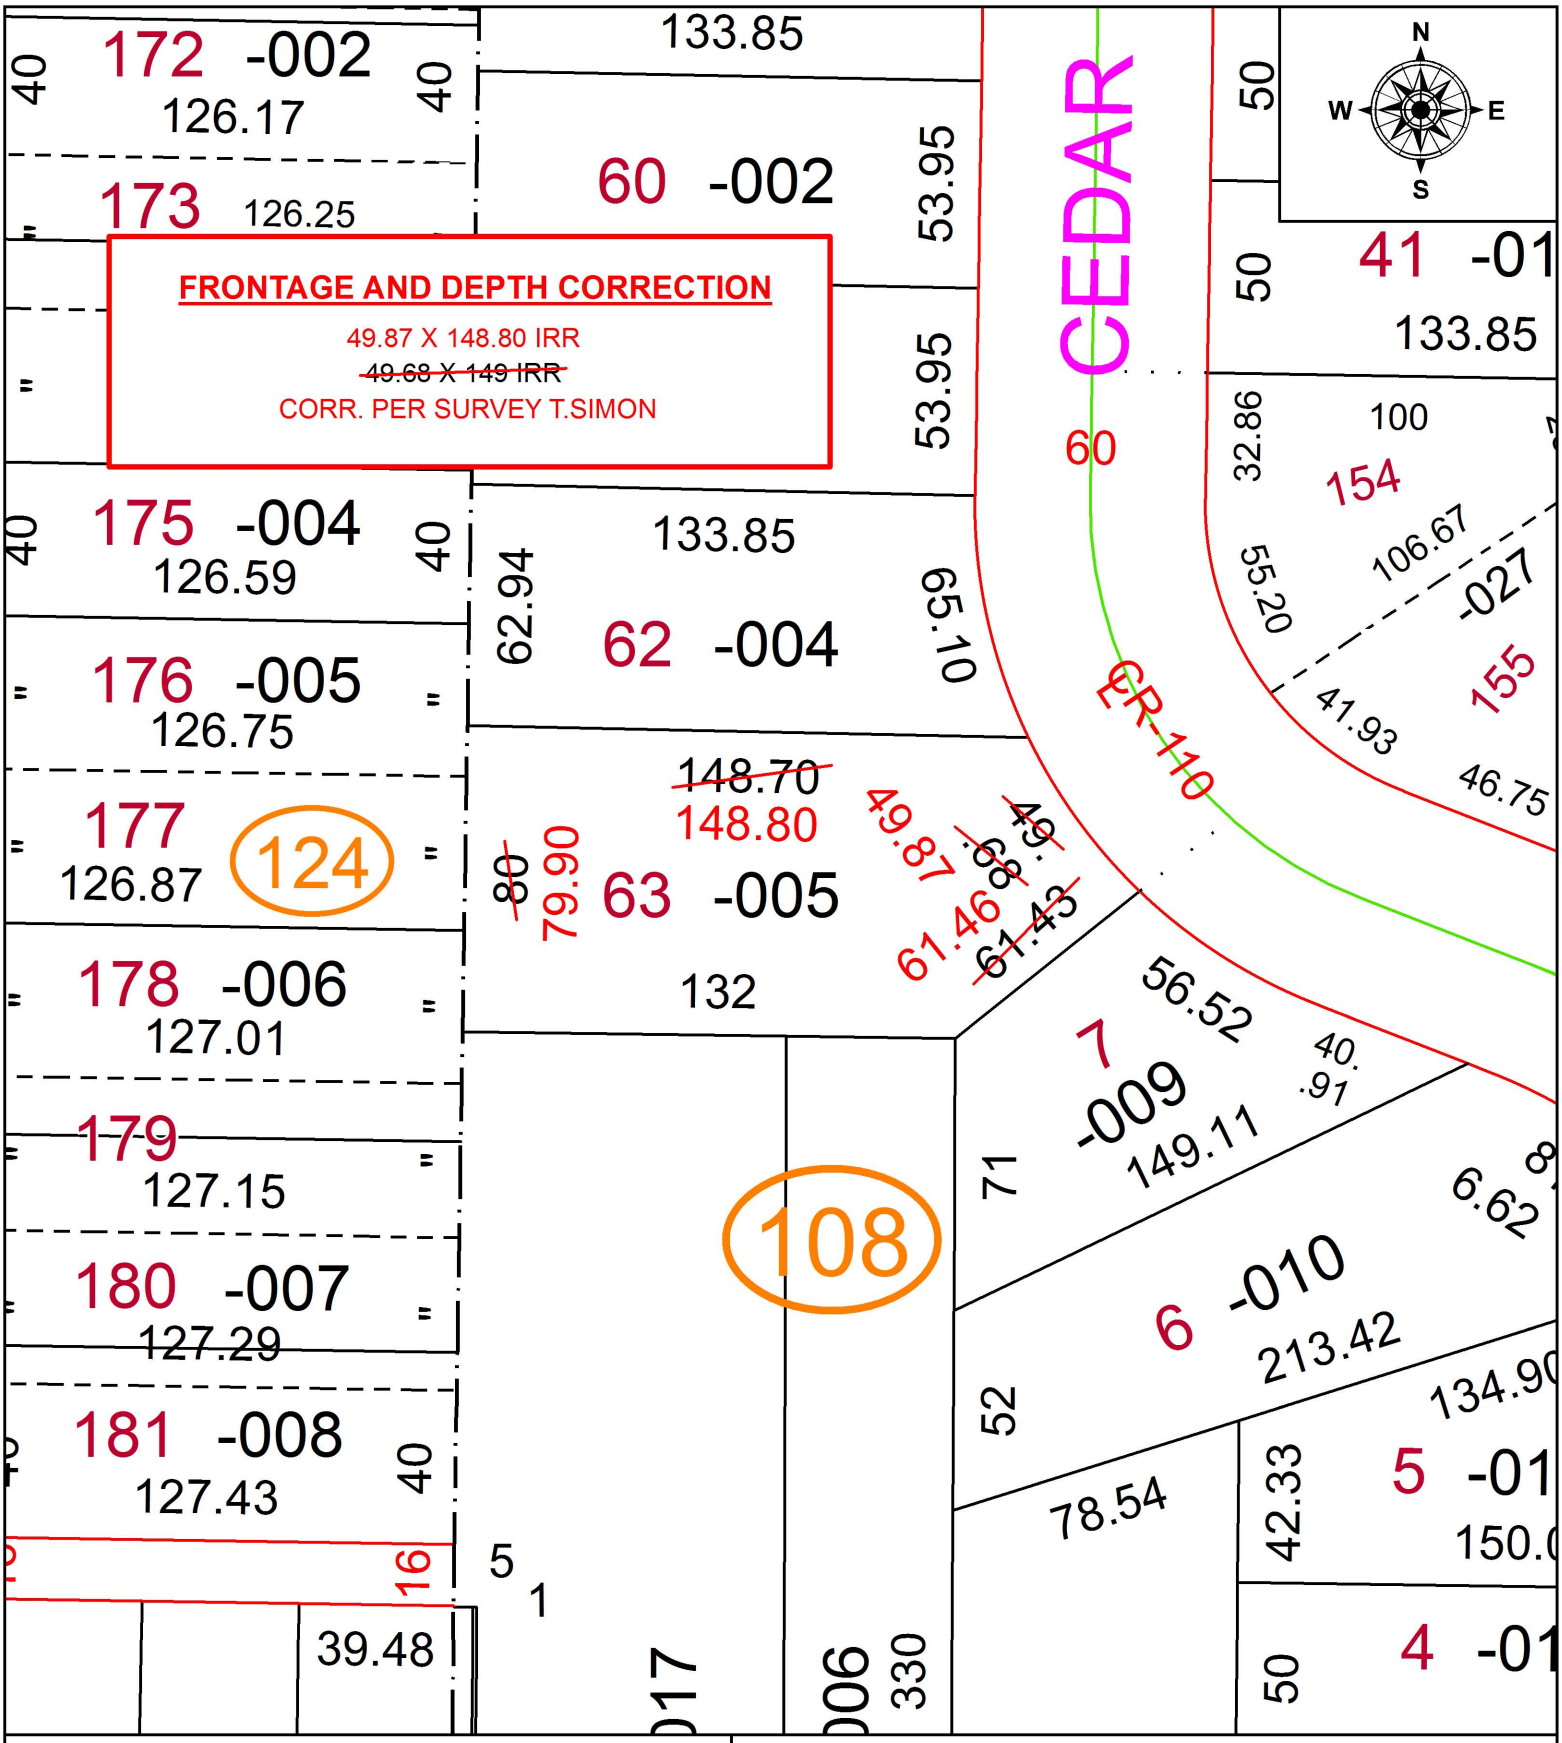

SPLITS/DEEDS PROCESSED
LORAIN COUNTY TAX MAP DEPARTMENT
226 MIDDLE AVE. ELYRIA, OH

SURVEYED BY: THOMAS A. SIMON
CLOSURE: 1: 107,416
MAP PAGE(S): 3-00-057
APPOVED BY: RRM **DATE:** 6-22-18
SCALE: 1" = 50 **PRIOR INSTRUMENT:** 20140525572