PARENT PARCEL: 01-00-005-104-067

CHILD PARCEL: 01-00-005-104-135, -136

STARTING POINT: INTERSECTION OF C/L OF LIBERTY AVE. AND C/L OF SUNNYSIDE RD.

18-03917

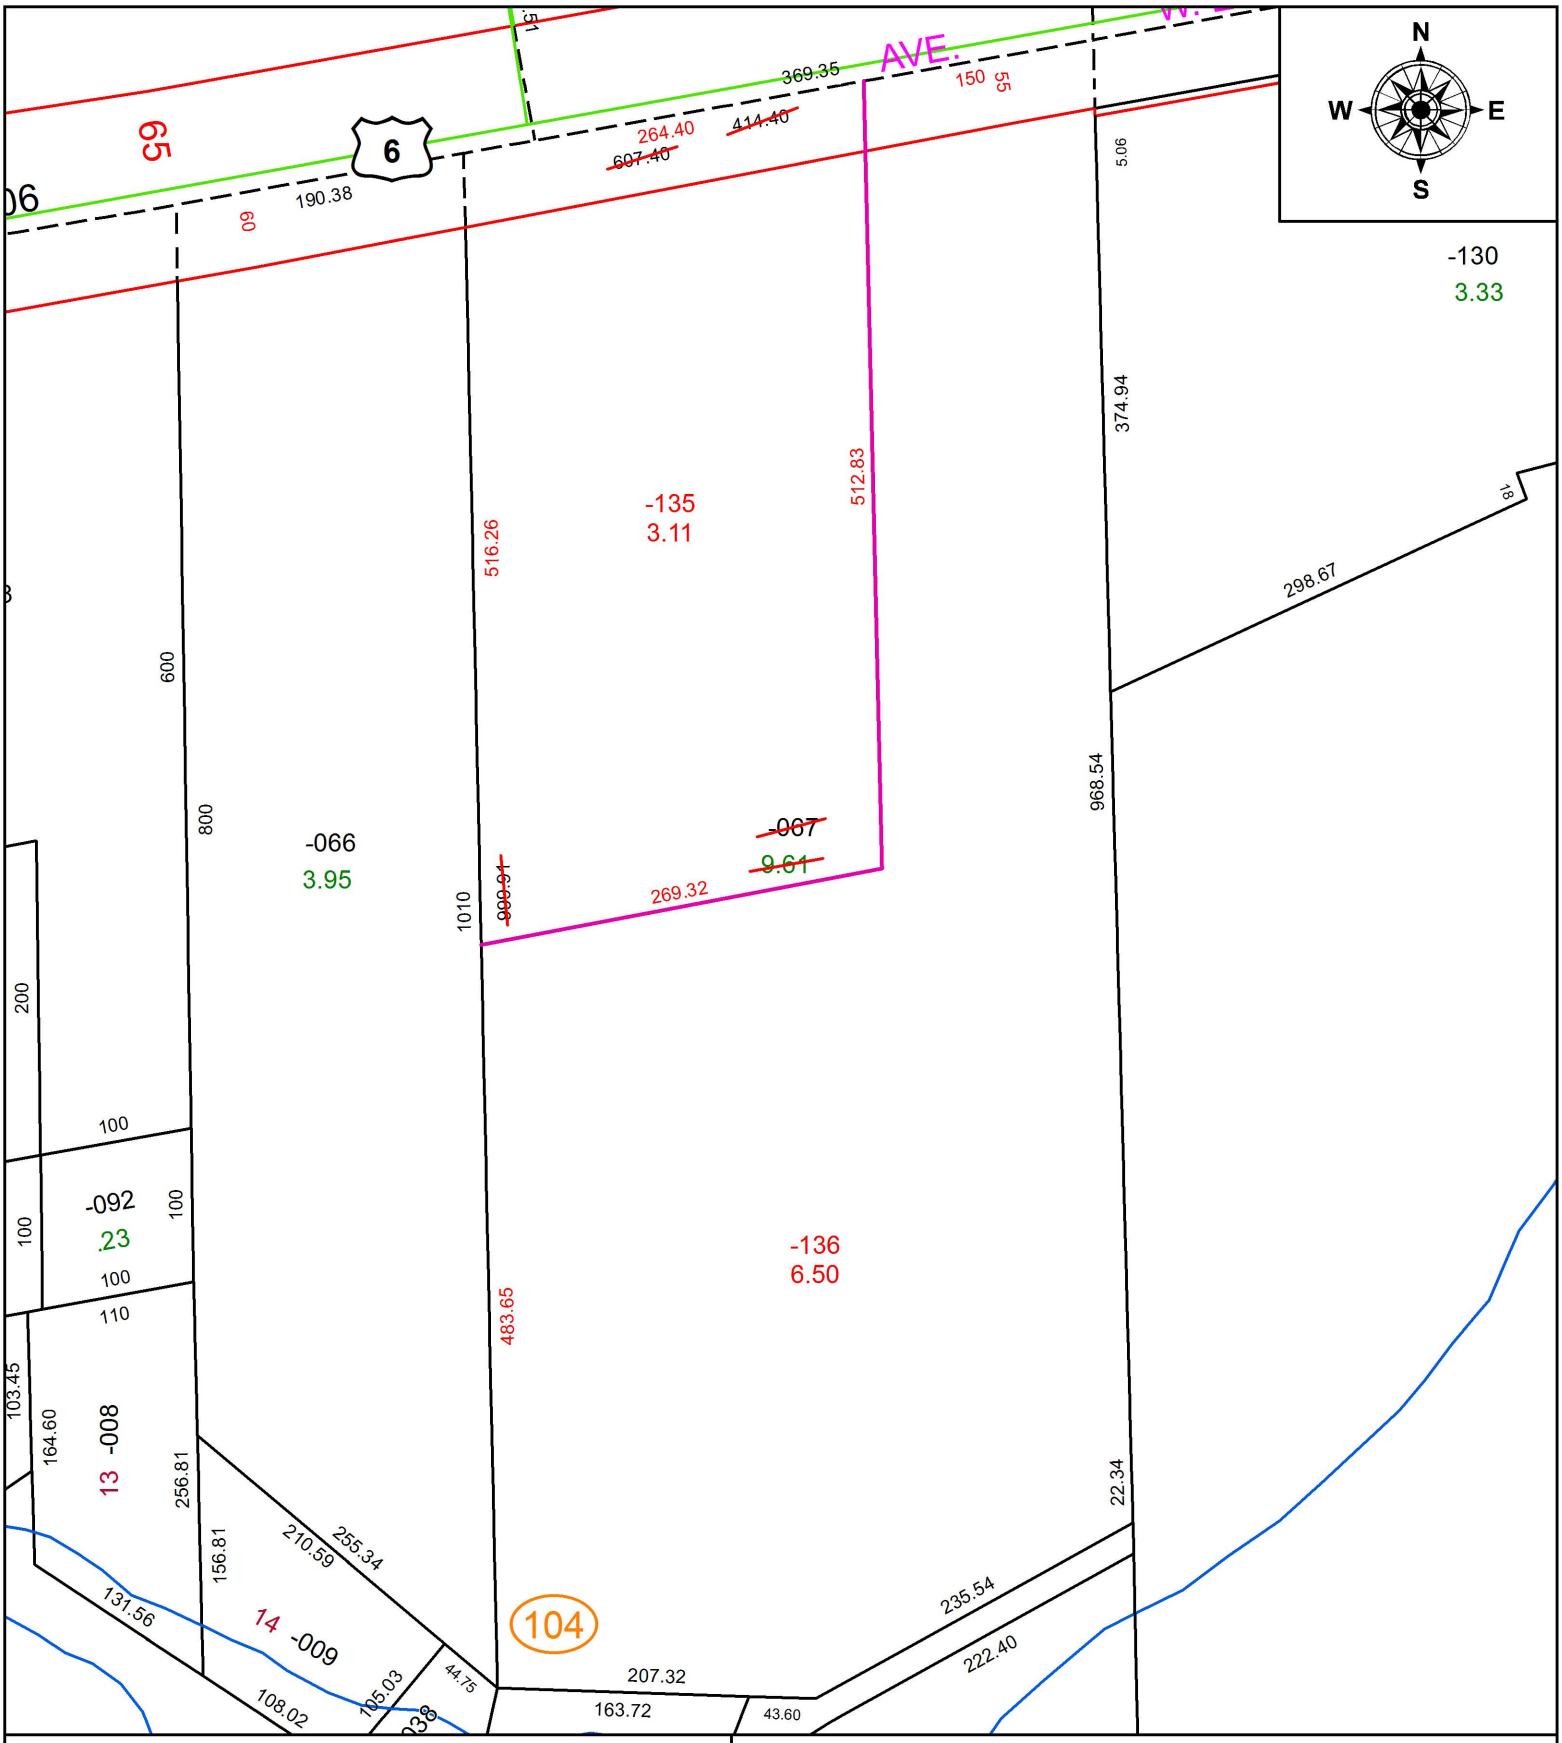

SPLITS/DEEDS PROCESSED

LORAIN COUNTY TAX MAP DEPARTMENT
226 MIDDLE AVE. ELYRIA, OH

SURVEYED BY: KEITH A. DYLEWSKI
CLOSURE: 1: 216,953
MAP PAGE(S): 1-00-005
APPOVED BY: RRM **DATE:** 12-18-18
SCALE: 1" = 125 **PRIOR INSTRUMENT:** 20050088094