**PARENT PARCEL:** 06-26-094-103-008
**CHILD PARCEL:** XX-XX-XXX-XXX-XXX
**STARTING POINT:** SOUTHEAST CORNER OF S/L 9 IN WILLIAM A. ELY'S SUB.

18-03919-D

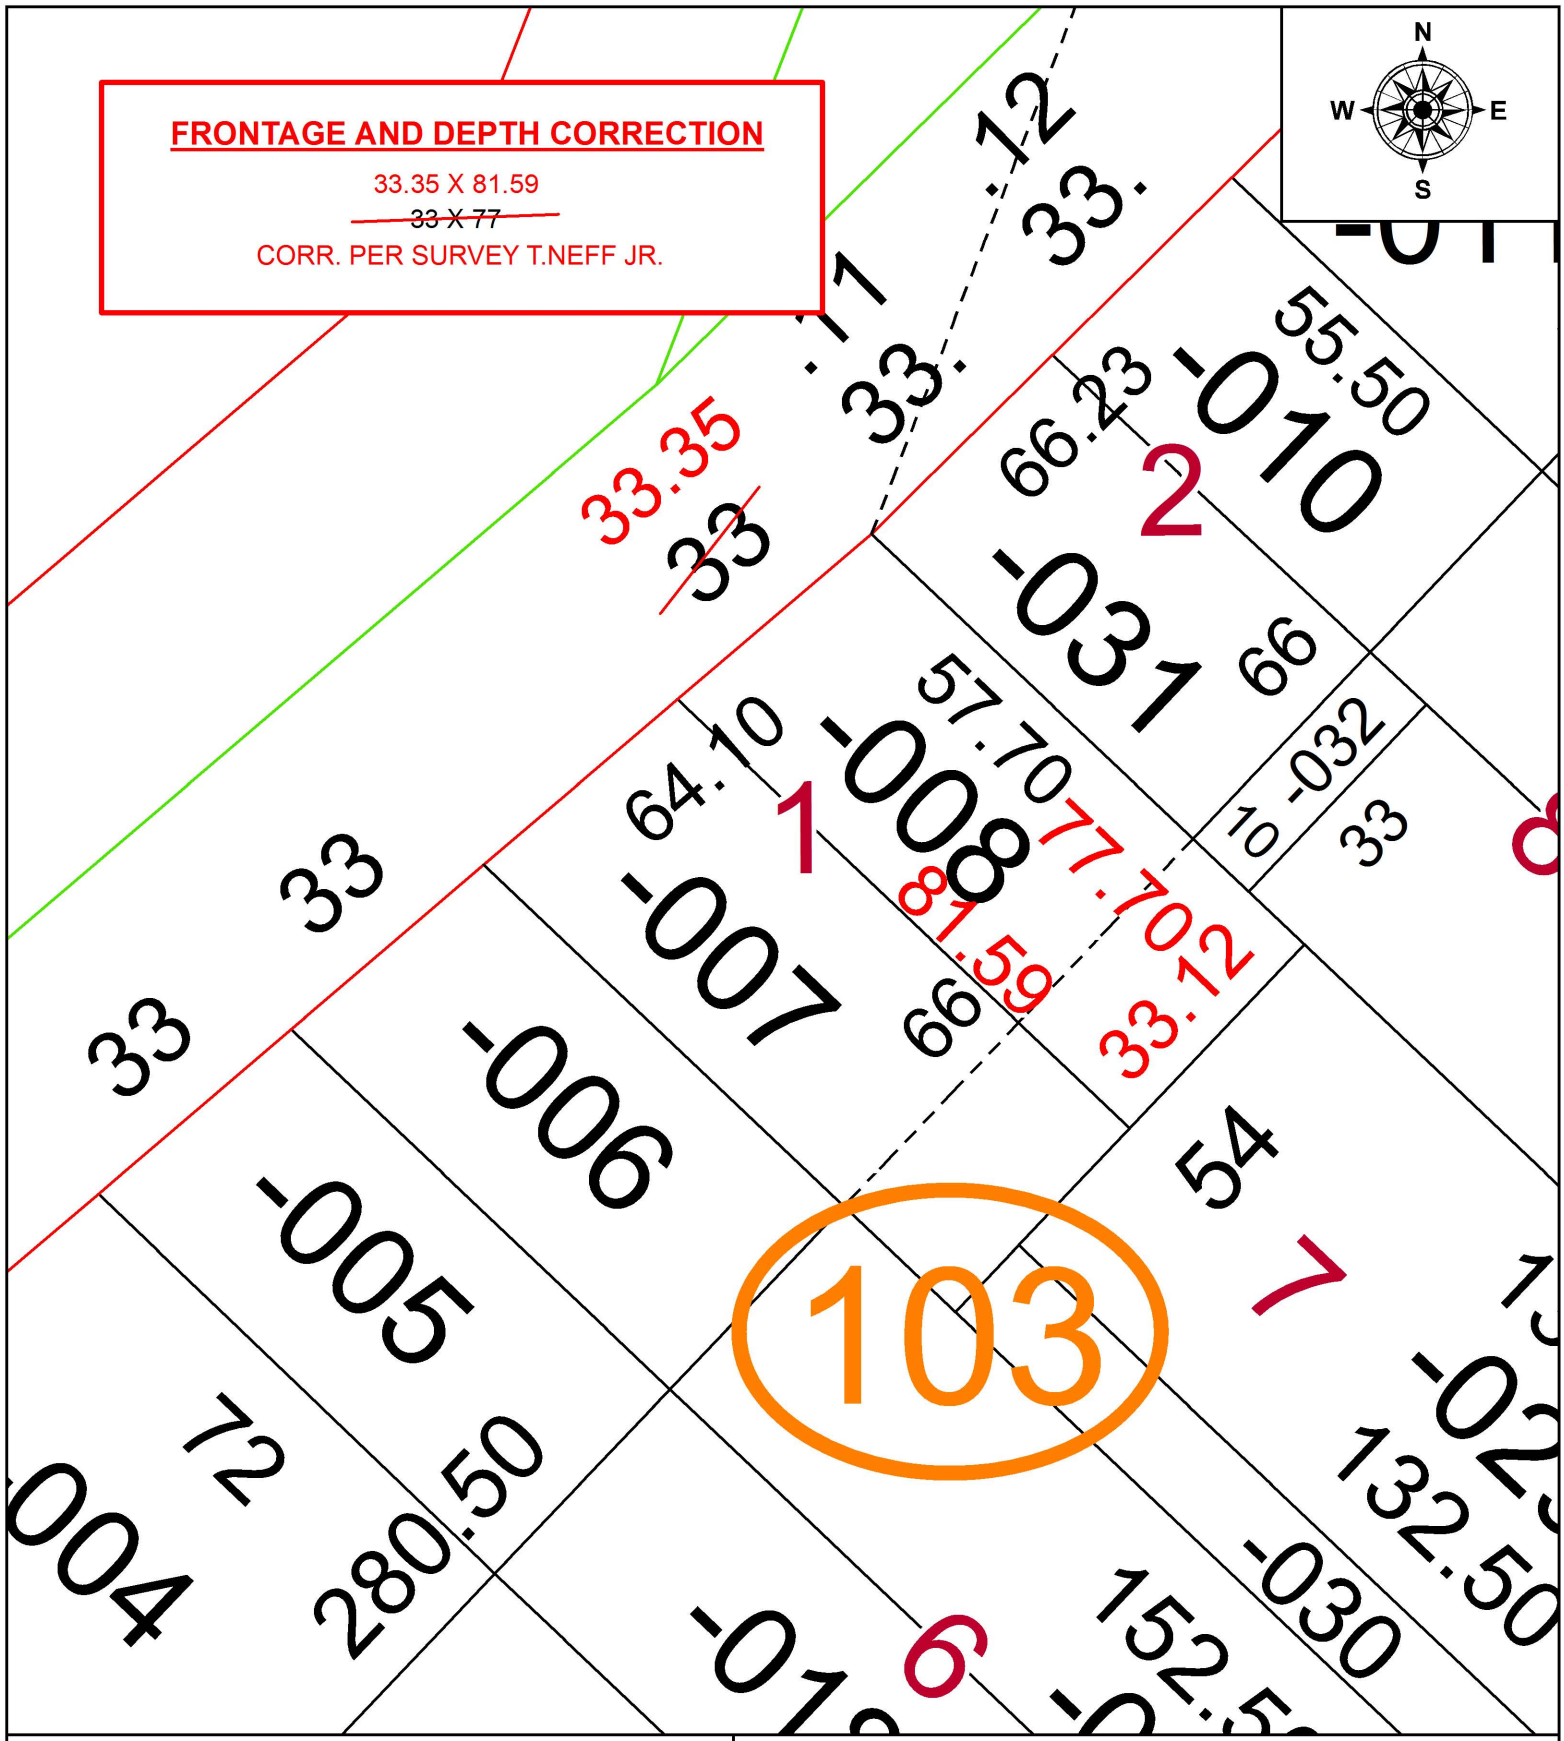


**SPLITS/DEEDS PROCESSED**
LORAIN COUNTY TAX MAP DEPARTMENT
226 MIDDLE AVE. ELYRIA, OH

**SURVEYED BY:** THOMAS J. NEFF JR,
**CLOSURE:** 1: 32,841
**MAP PAGE(S):** 6-101
**APPOVED BY:** RRM **DATE:** 6-29-18
**SCALE:** 1" = 25 **PRIOR INSTRUMENT:** 20160579588