PARENT PARCEL: 09-00-086-106-008
CHILD PARCEL: 09-00-086-106-040, -041
STARTING POINT: INTERSECTION OF C/L OF E. COLLEGE ST. AND C/L OF S. PARK ST.

18-03919

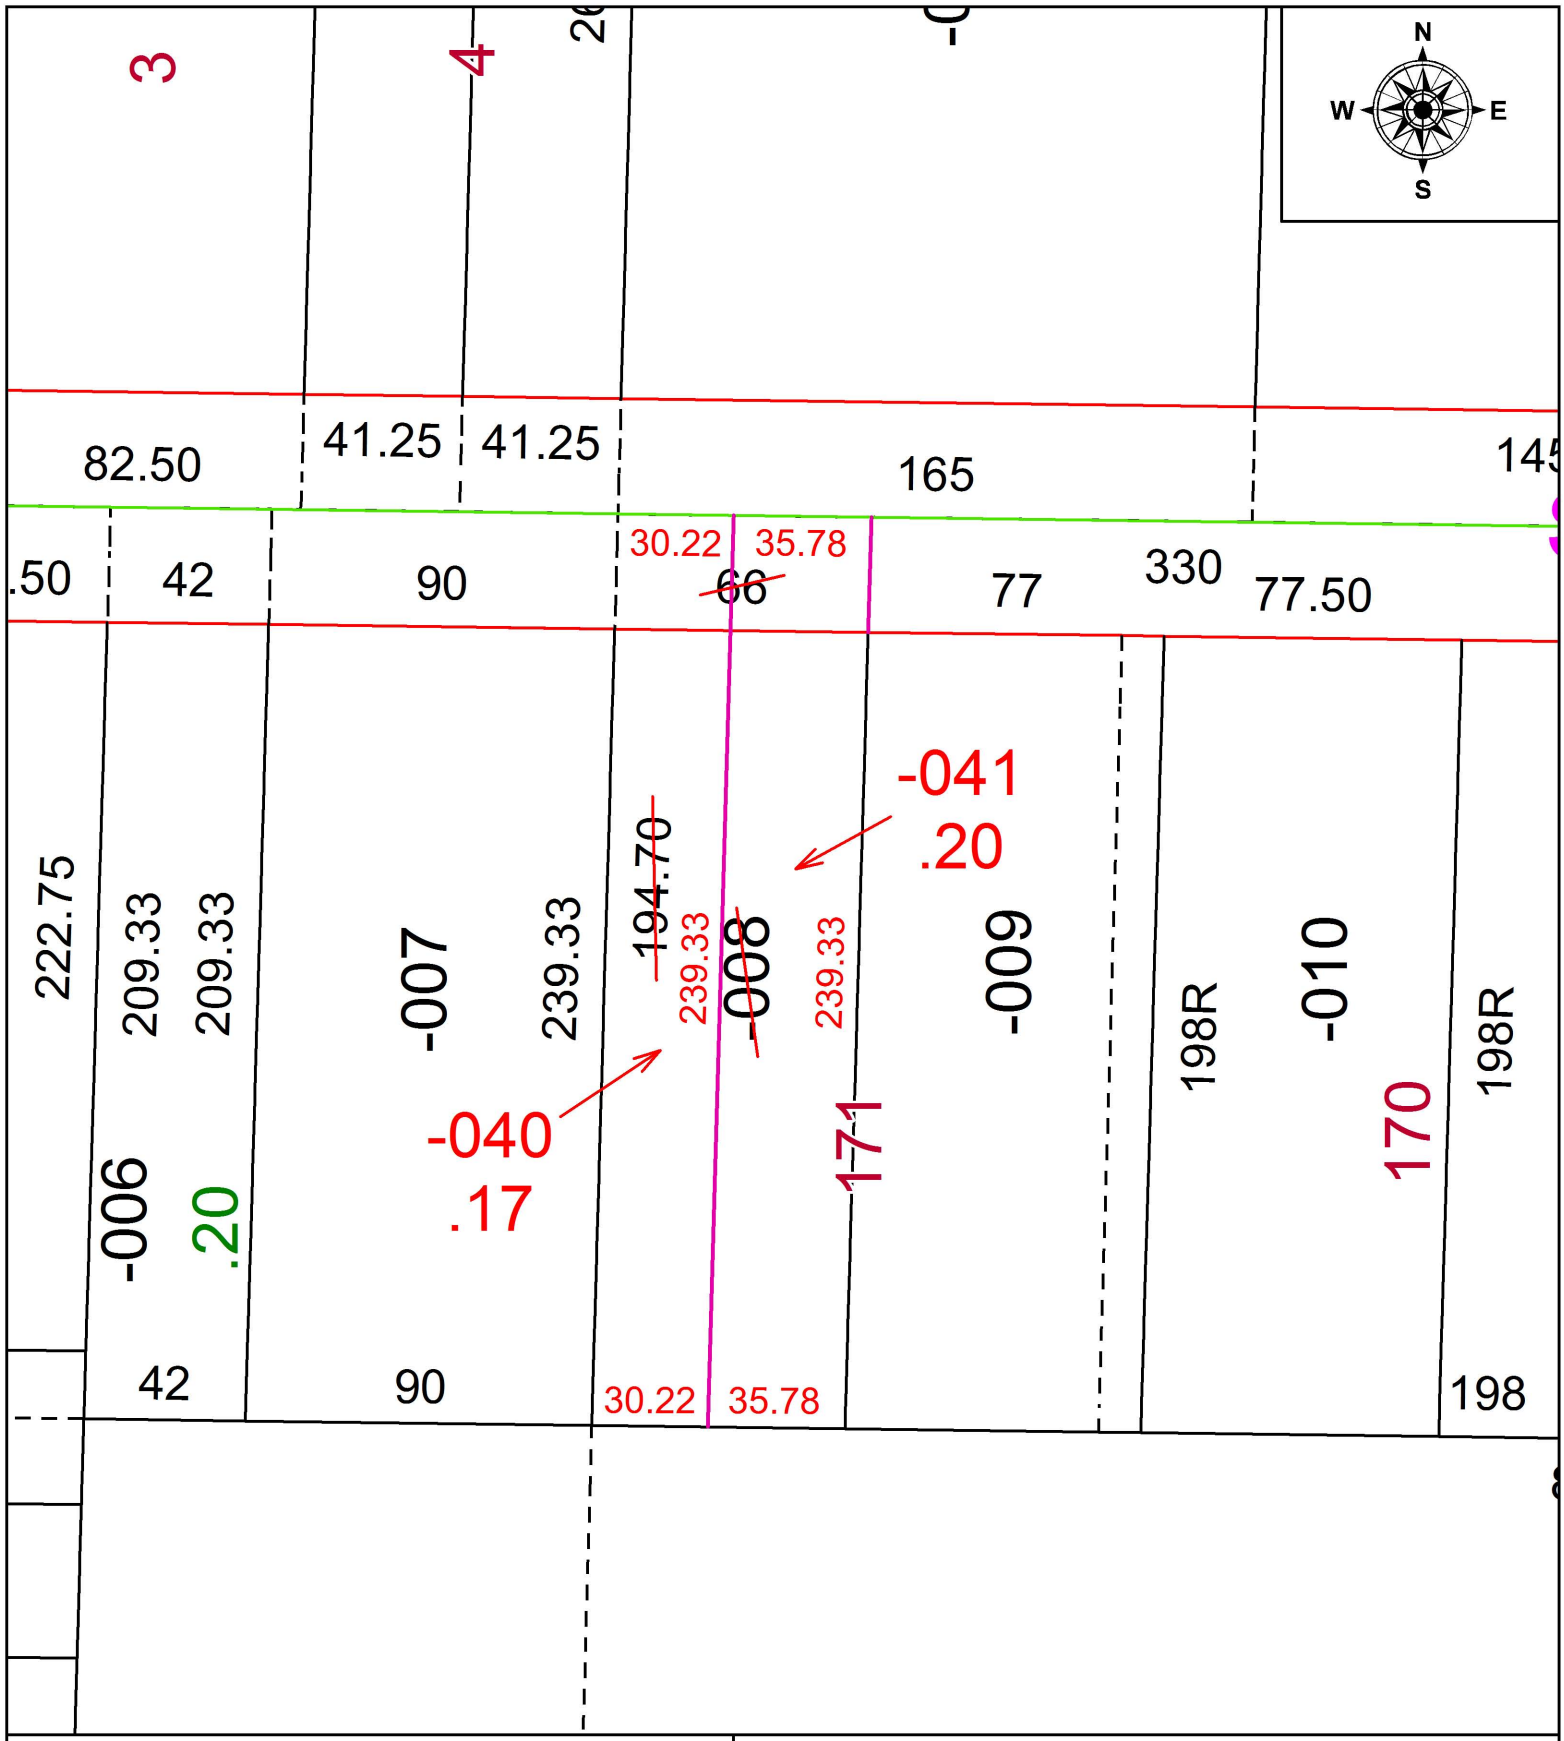

SPLITS/DEEDS PROCESSED
LORAIN COUNTY TAX MAP DEPARTMENT
226 MIDDLE AVE. ELYRIA, OH

SURVEYED BY: THOMAS A. SIMON
CLOSURE: 1: 2147483648
MAP PAGE(S): 9-00-086
APPOVED BY: RRM **DATE:** 12-20-18
SCALE: 1" = 50 **PRIOR INSTRUMENT:** 20170655818