PARENT PARCEL: 04-00-010-111-038, -039
CHILD PARCEL: 04-00-010-111-214
STARTING POINT: INTERSECTION OF C/L OF HALE ST. AND C/L OF S.R.254

19-03928

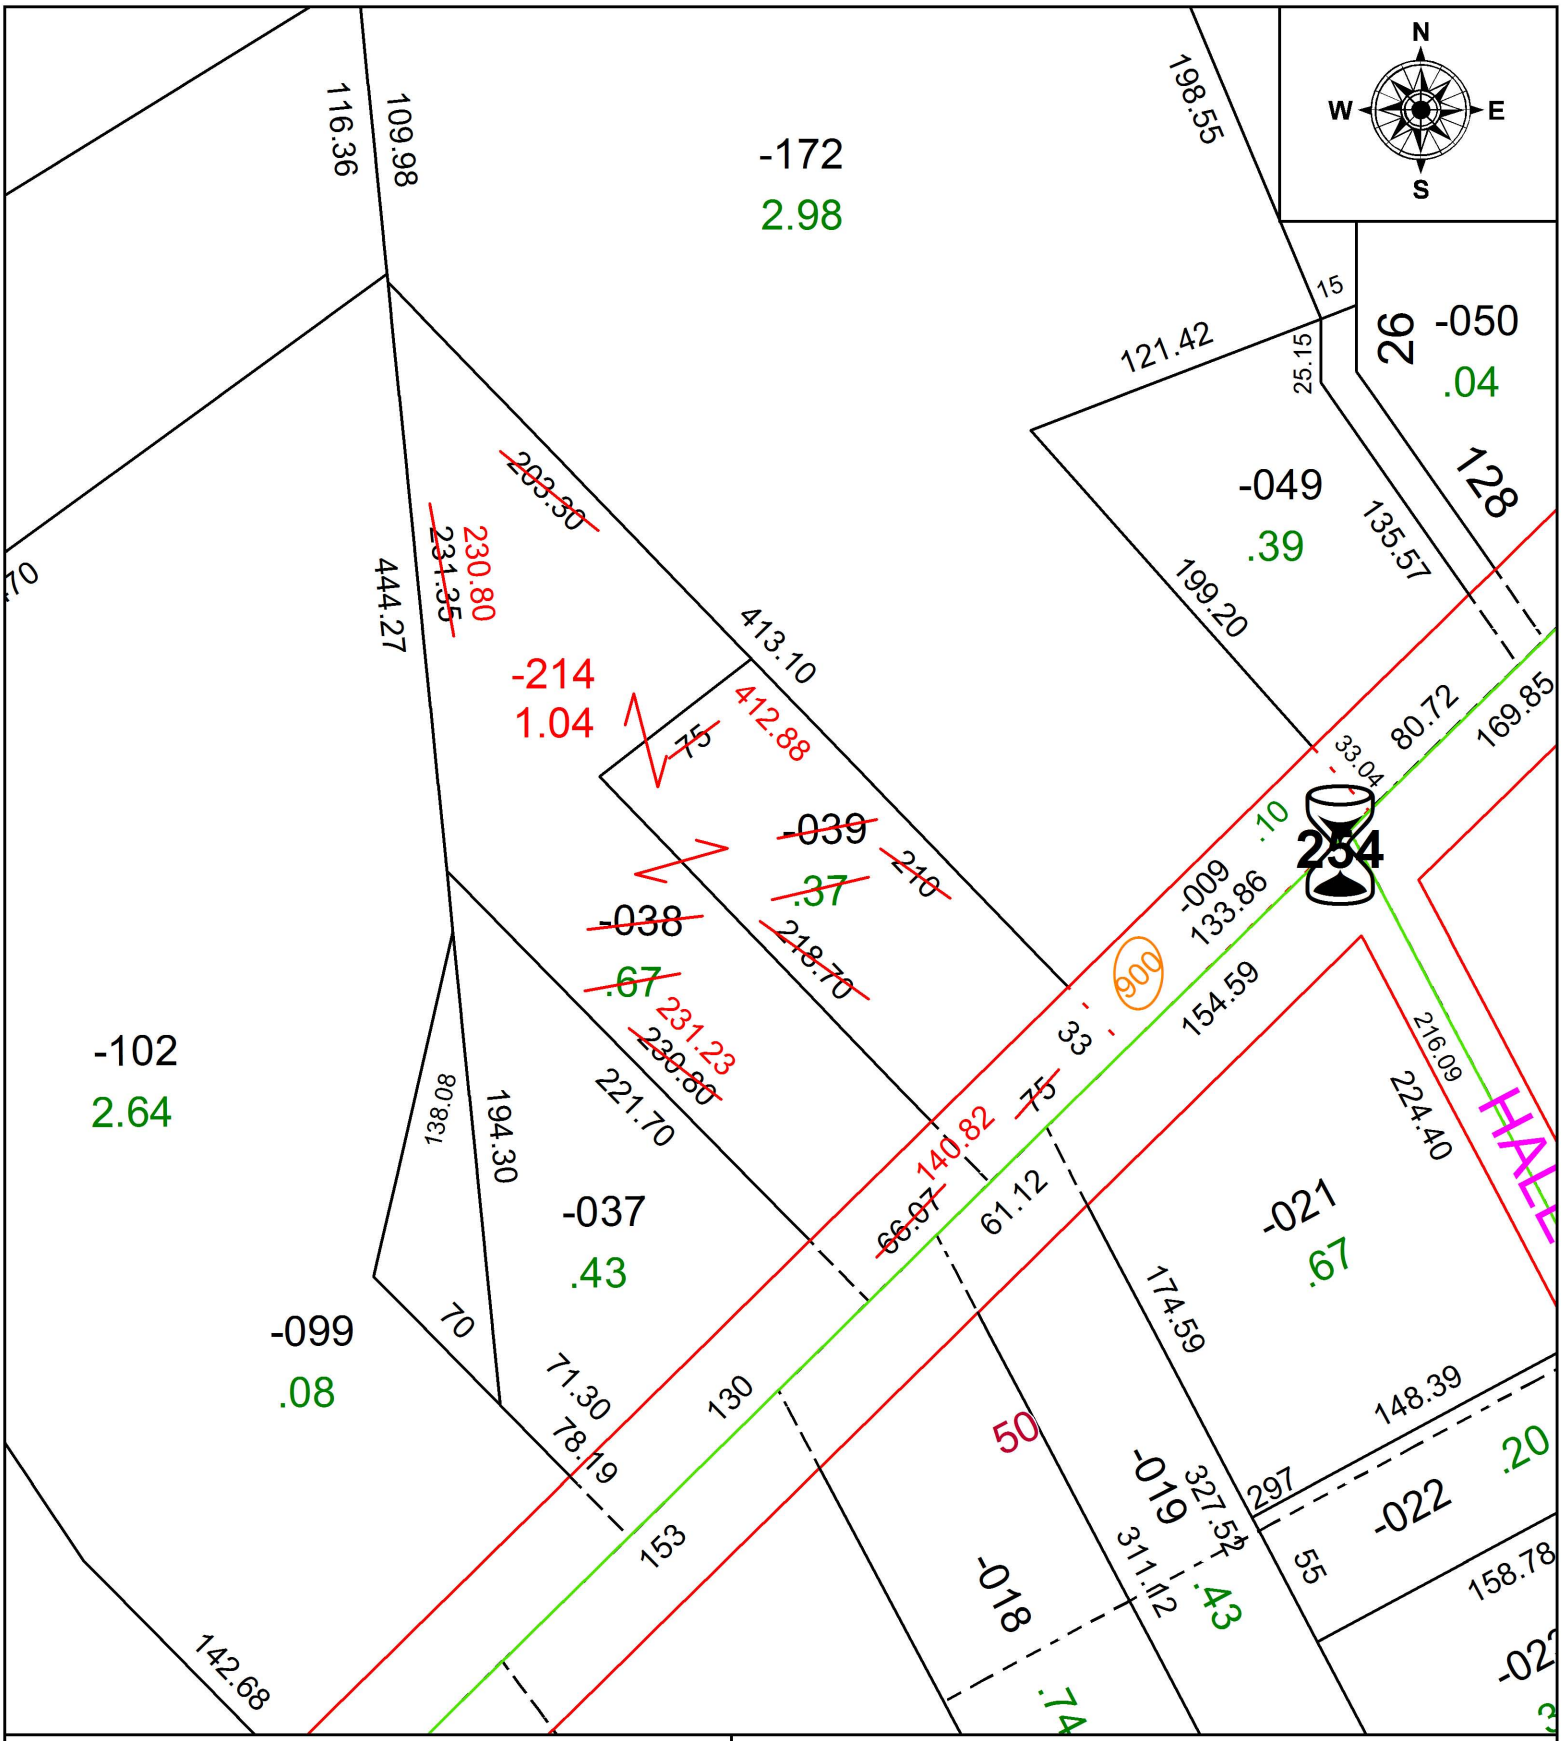

SPLITS/DEEDS PROCESSED
LORAIN COUNTY TAX MAP DEPARTMENT
226 MIDDLE AVE. ELYRIA, OH

SURVEYED BY: JOSHUA S. RIEDY
CLOSURE: 1:243,341
MAP PAGE(S): 4-00-010
APPOVED BY: RRM **DATE:** 1-24-19
SCALE: 1" = 75 **PRIOR INSTRUMENT:** 20170653712