PARENT PARCEL: 12-00-074-000-029
CHILD PARCEL: 12-00-074-000-048, -049
STARTING POINT: INTERSECTION OF C/L OF STATION RD. AND WEST LINE OF O.L.74

19-03930

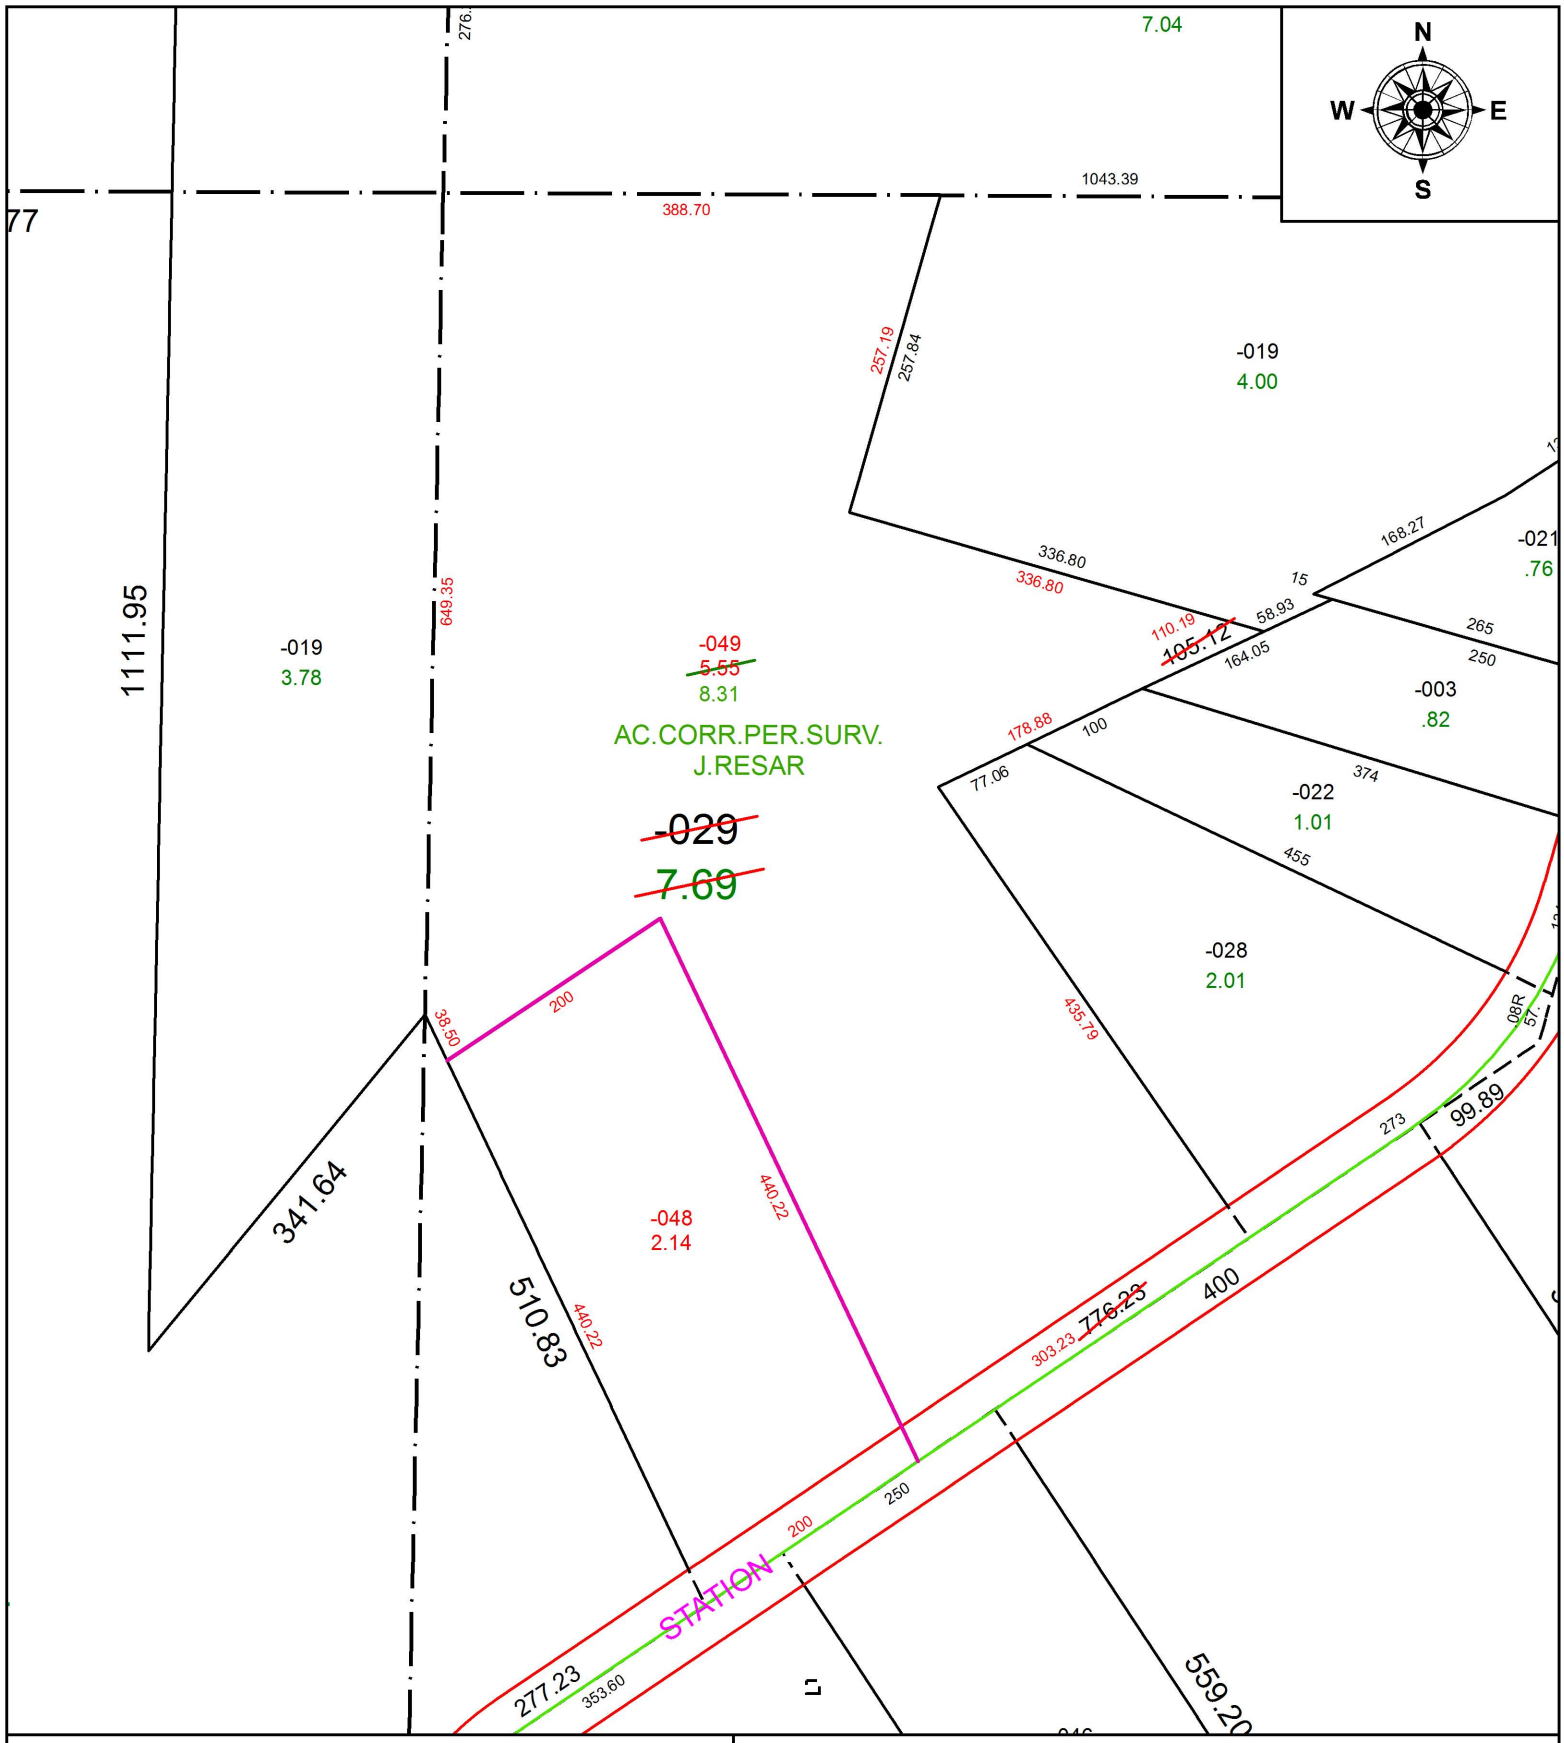

SPLITS/DEEDS PROCESSED
LORAIN COUNTY TAX MAP DEPARTMENT
226 MIDDLE AVE. ELYRIA, OH

SURVEYED BY: JAMES A. RESAR
CLOSURE: 1: 115,748
MAP PAGE(S): 12-00-074
APPOVED BY: RRM **DATE:** 2-1-19
SCALE: 1" = 150 **PRIOR INSTRUMENT:** OR 75/586