PARENT PARCEL: 04-00-017-103-212, -213

CHILD PARCEL: 04-00-017-103-374 THRU -376

STARTING POINT: INTERSECTION OF C/L OF WALKER RD. AND C/L OF DANBURY LN.

19-03931

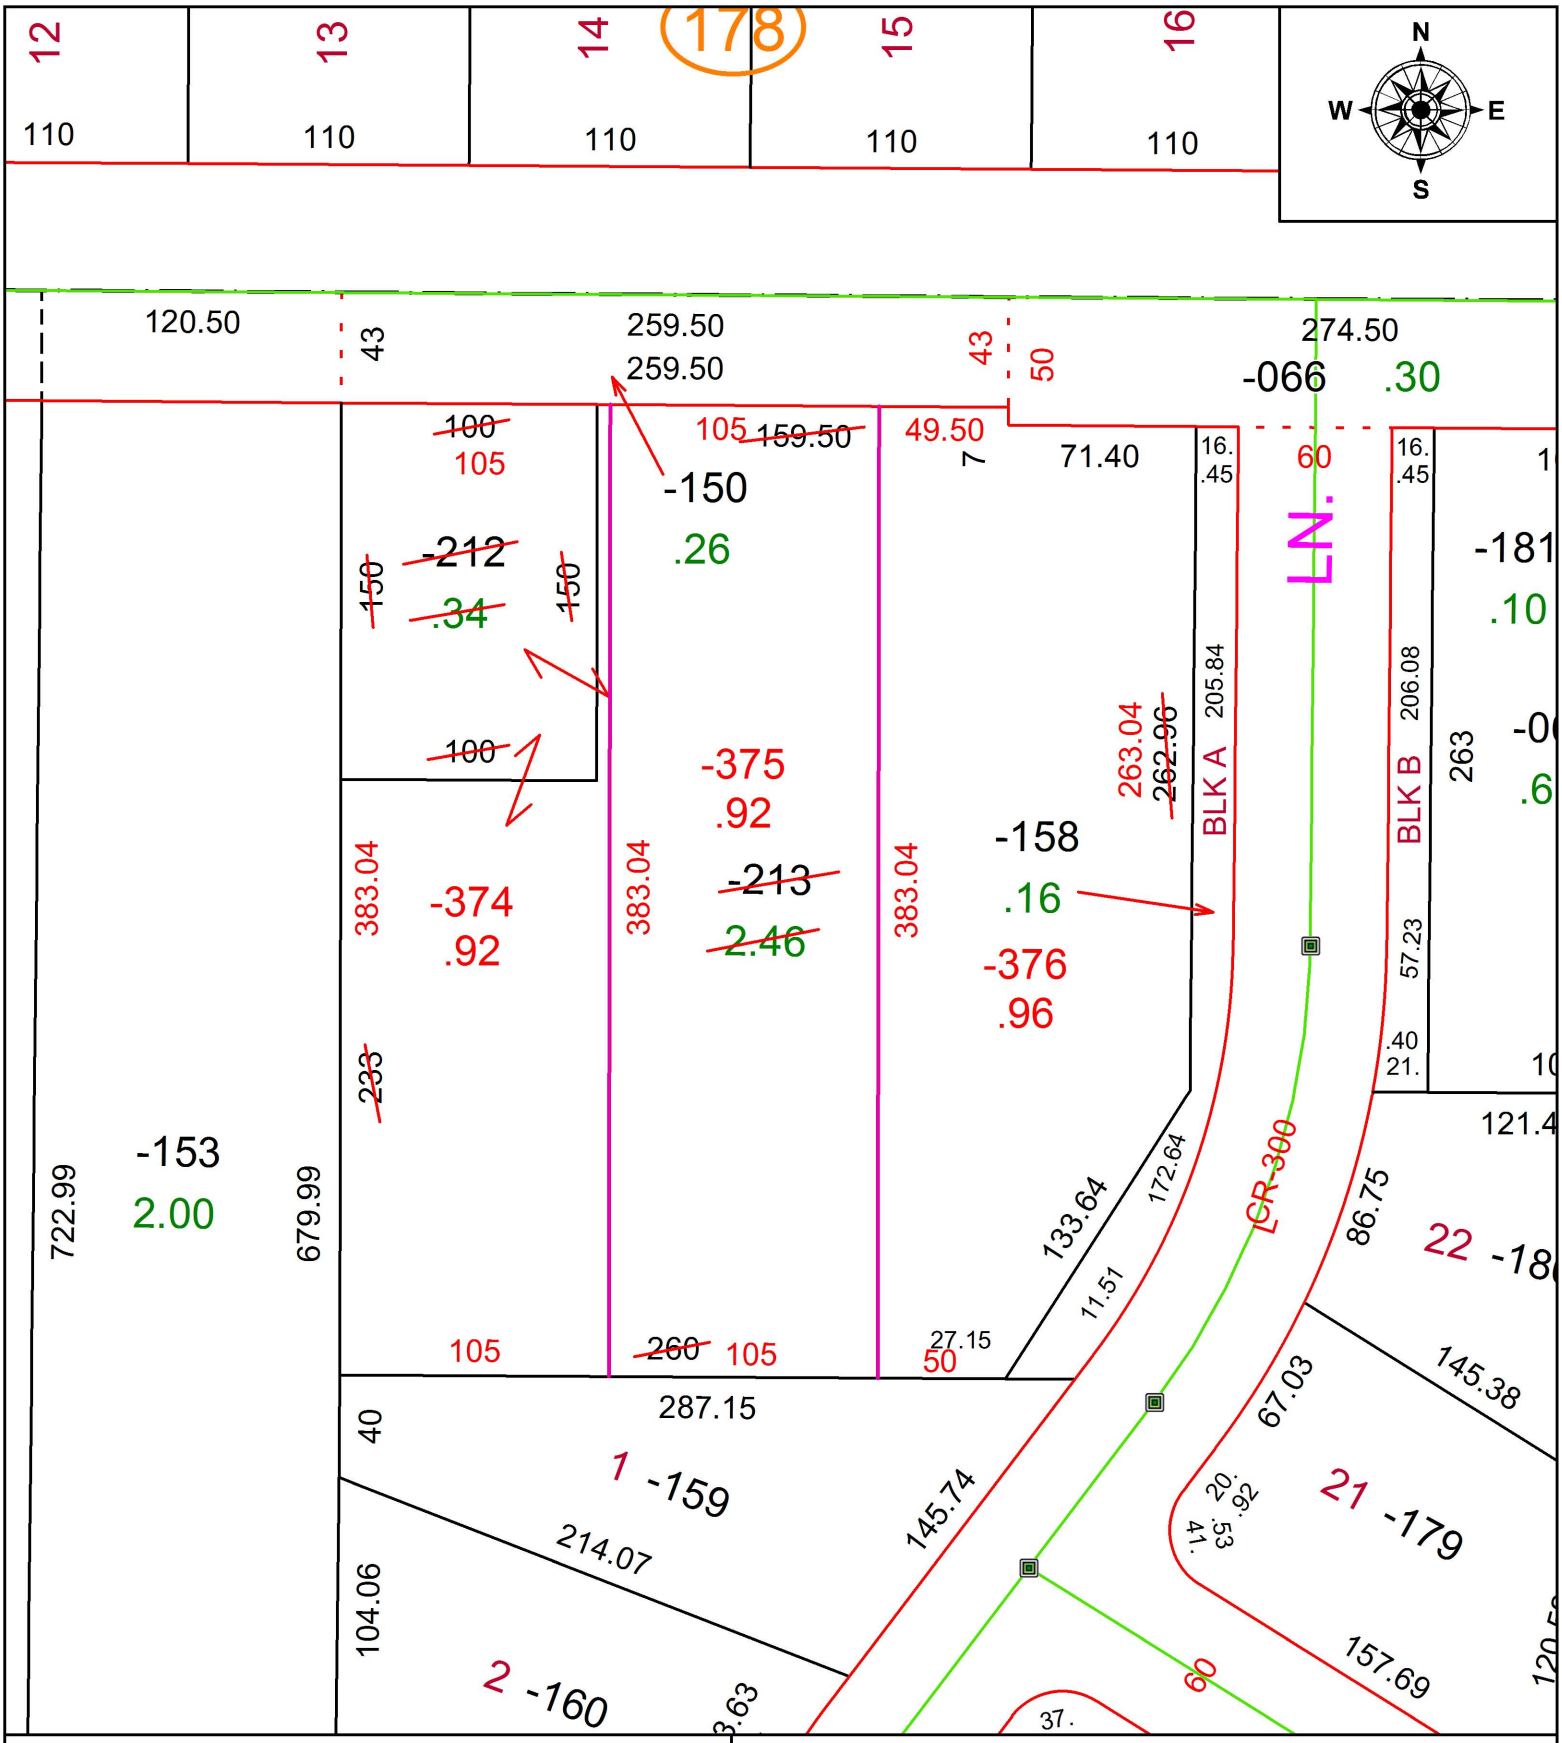

SPLITS/DEEDS PROCESSED

LORAIN COUNTY TAX MAP DEPARTMENT
226 MIDDLE AVE. ELYRIA, OH

SURVEYED BY: THOMAS M. SNEZEK
CLOSURE: 1:180,796
MAP PAGE(S): 4-00-017
APPOVED BY: RRM **DATE:** 2-4-19
SCALE: 1" = 75 **PRIOR INSTRUMENT:** 20180695281