PARENT PARCEL: 11-00-046-000-062

CHILD PARCEL: 11-00-046-000-065, -066

STARTING POINT: INTERSECTION OF C/L OF S.R.83 AND C/L OF S.R.82

19-03932

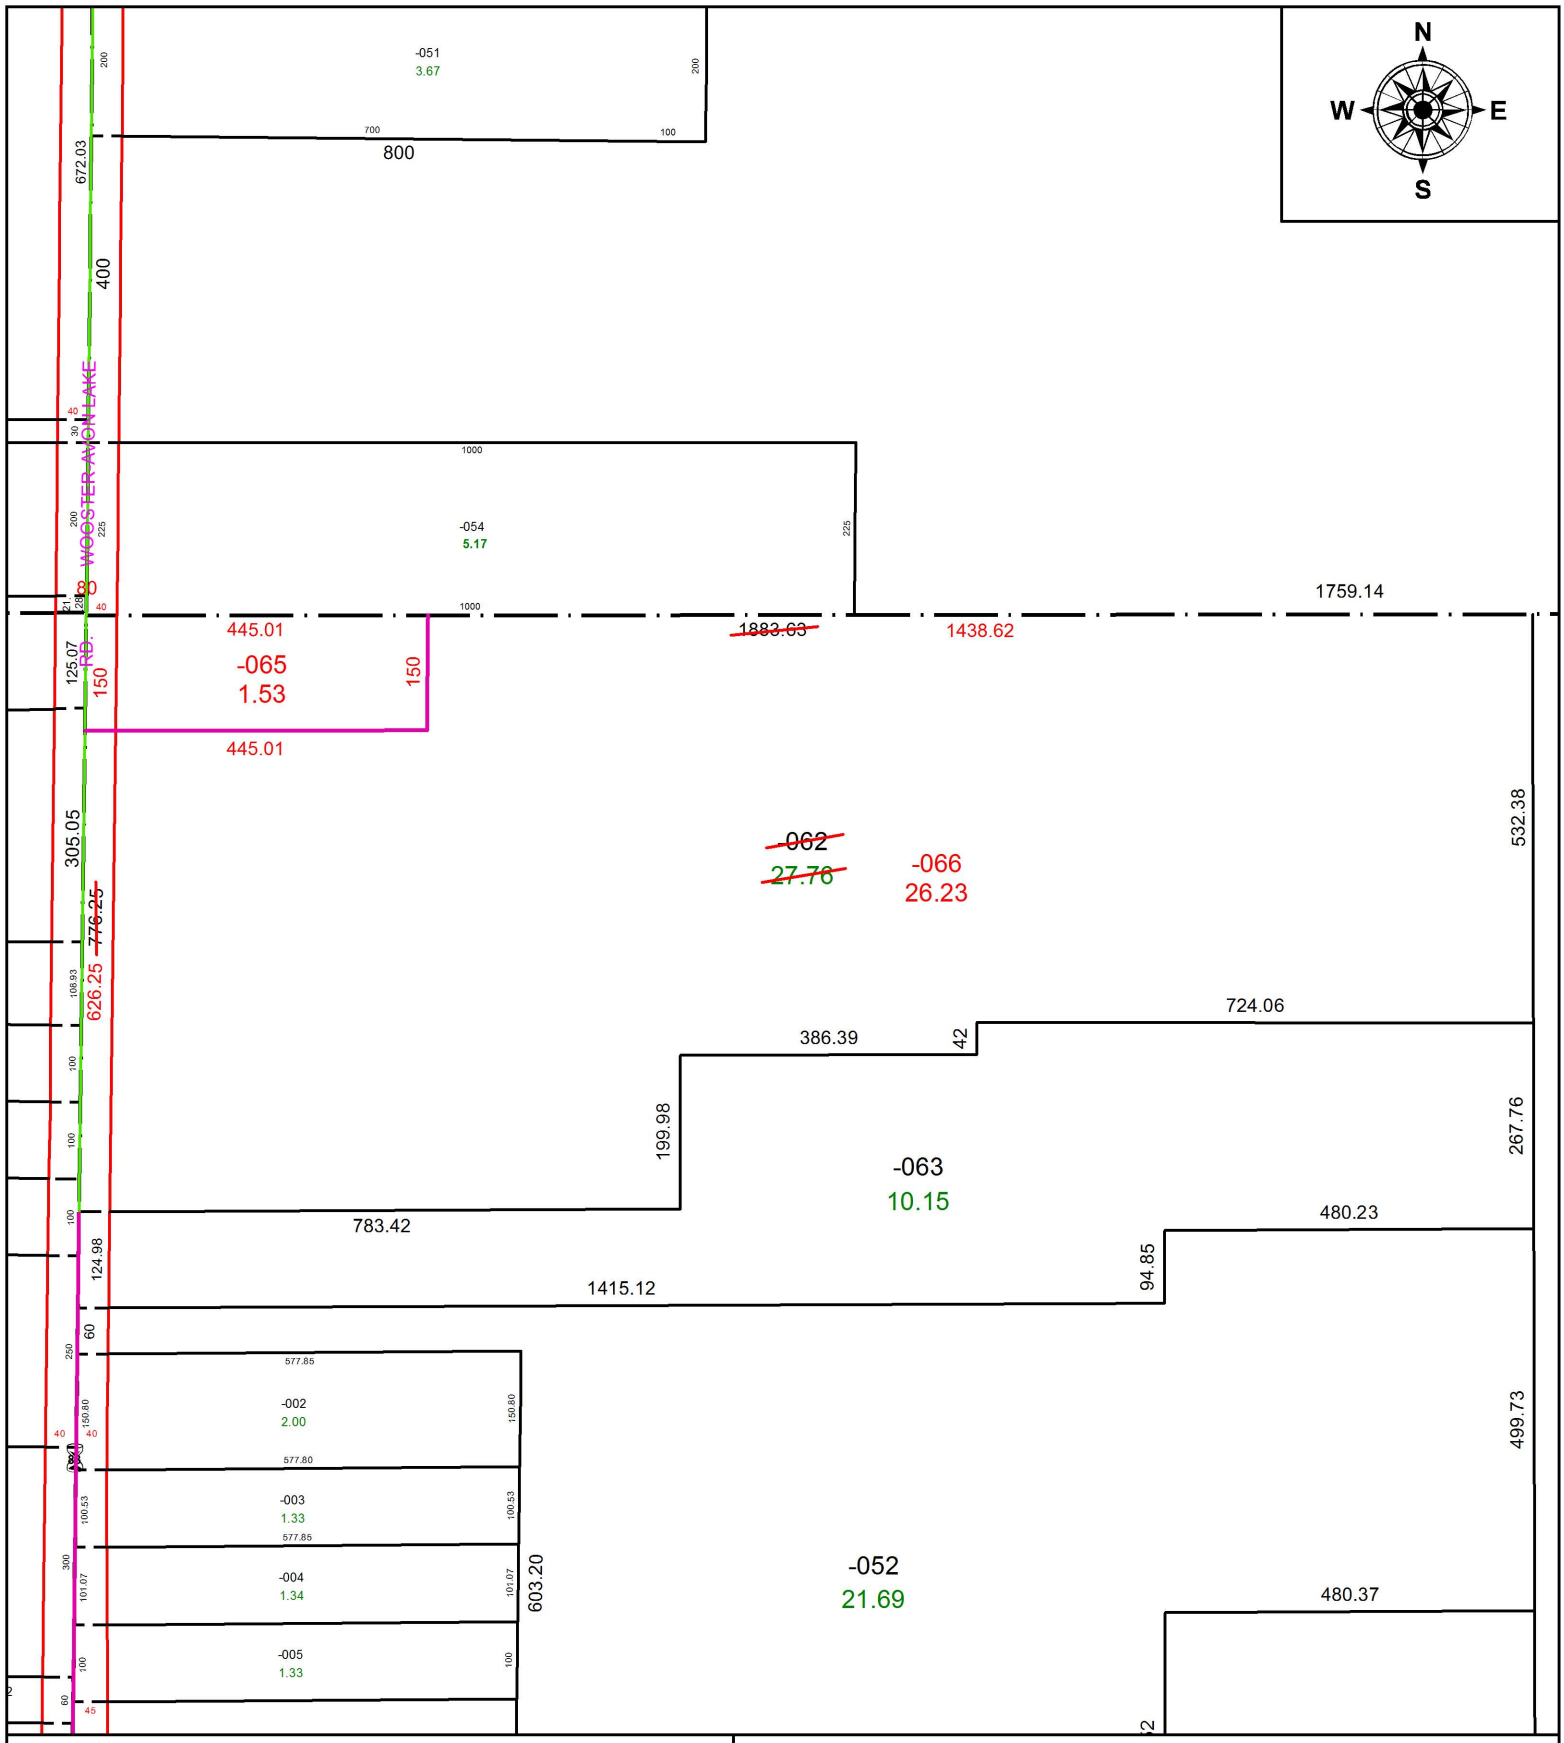

SPLITS/DEEDS PROCESSED

LORAIN COUNTY TAX MAP DEPARTMENT
226 MIDDLE AVE. ELYRIA, OH

SURVEYED BY: STEVEN J. METCALF
CLOSURE: 1:549,861
MAP PAGE(S): 11-00-046
APPOVED BY: RRM **DATE:** 2-5-19
SCALE: 1" = 250 **PRIOR INSTRUMENT:** 20030956320