PARENT PARCEL: 18-00-020-000-129
CHILD PARCEL: 18-00-020-000-147, 148
STARTING POINT: SOUTHEAST CORNER OF O.L.20

19-03934

-039
24.68

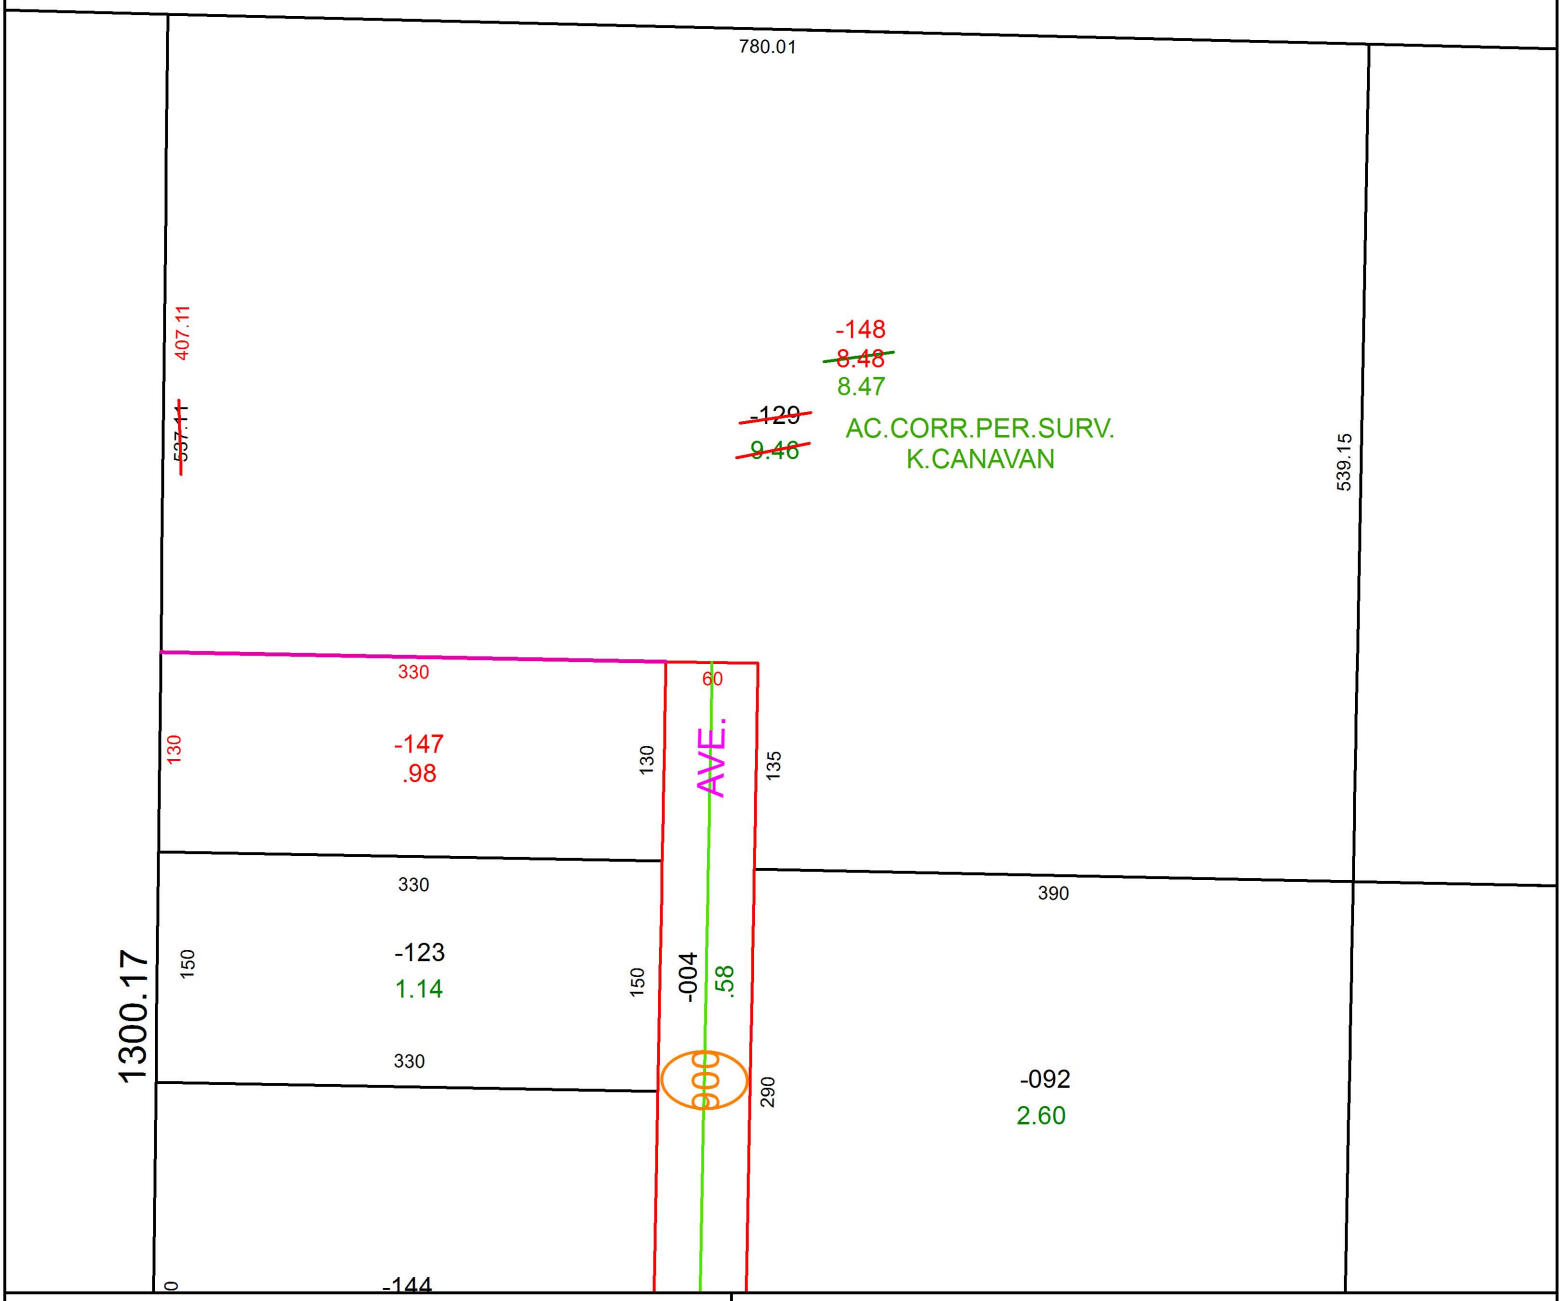

SPLITS/DEEDS PROCESSED
LORAIN COUNTY TAX MAP DEPARTMENT
226 MIDDLE AVE. ELYRIA, OH

SURVEYED BY: KEVIN CANAVAN
CLOSURE: 1: 405,722
MAP PAGE(S): 18-00-020
APPOVED BY: RRM **DATE:** 2-8-19
SCALE: 1" = 125 **PRIOR INSTRUMENT:** 20180673961