PARENT PARCEL: 18-00-021-112-001, -002, -003, -004, & -005

CHILD PARCEL: FRONTAGE & MAP CORR. -001 THRU -005 , MAP CORR. 18-00-021-114-001

STARTING POINT: NA

18-03935-C

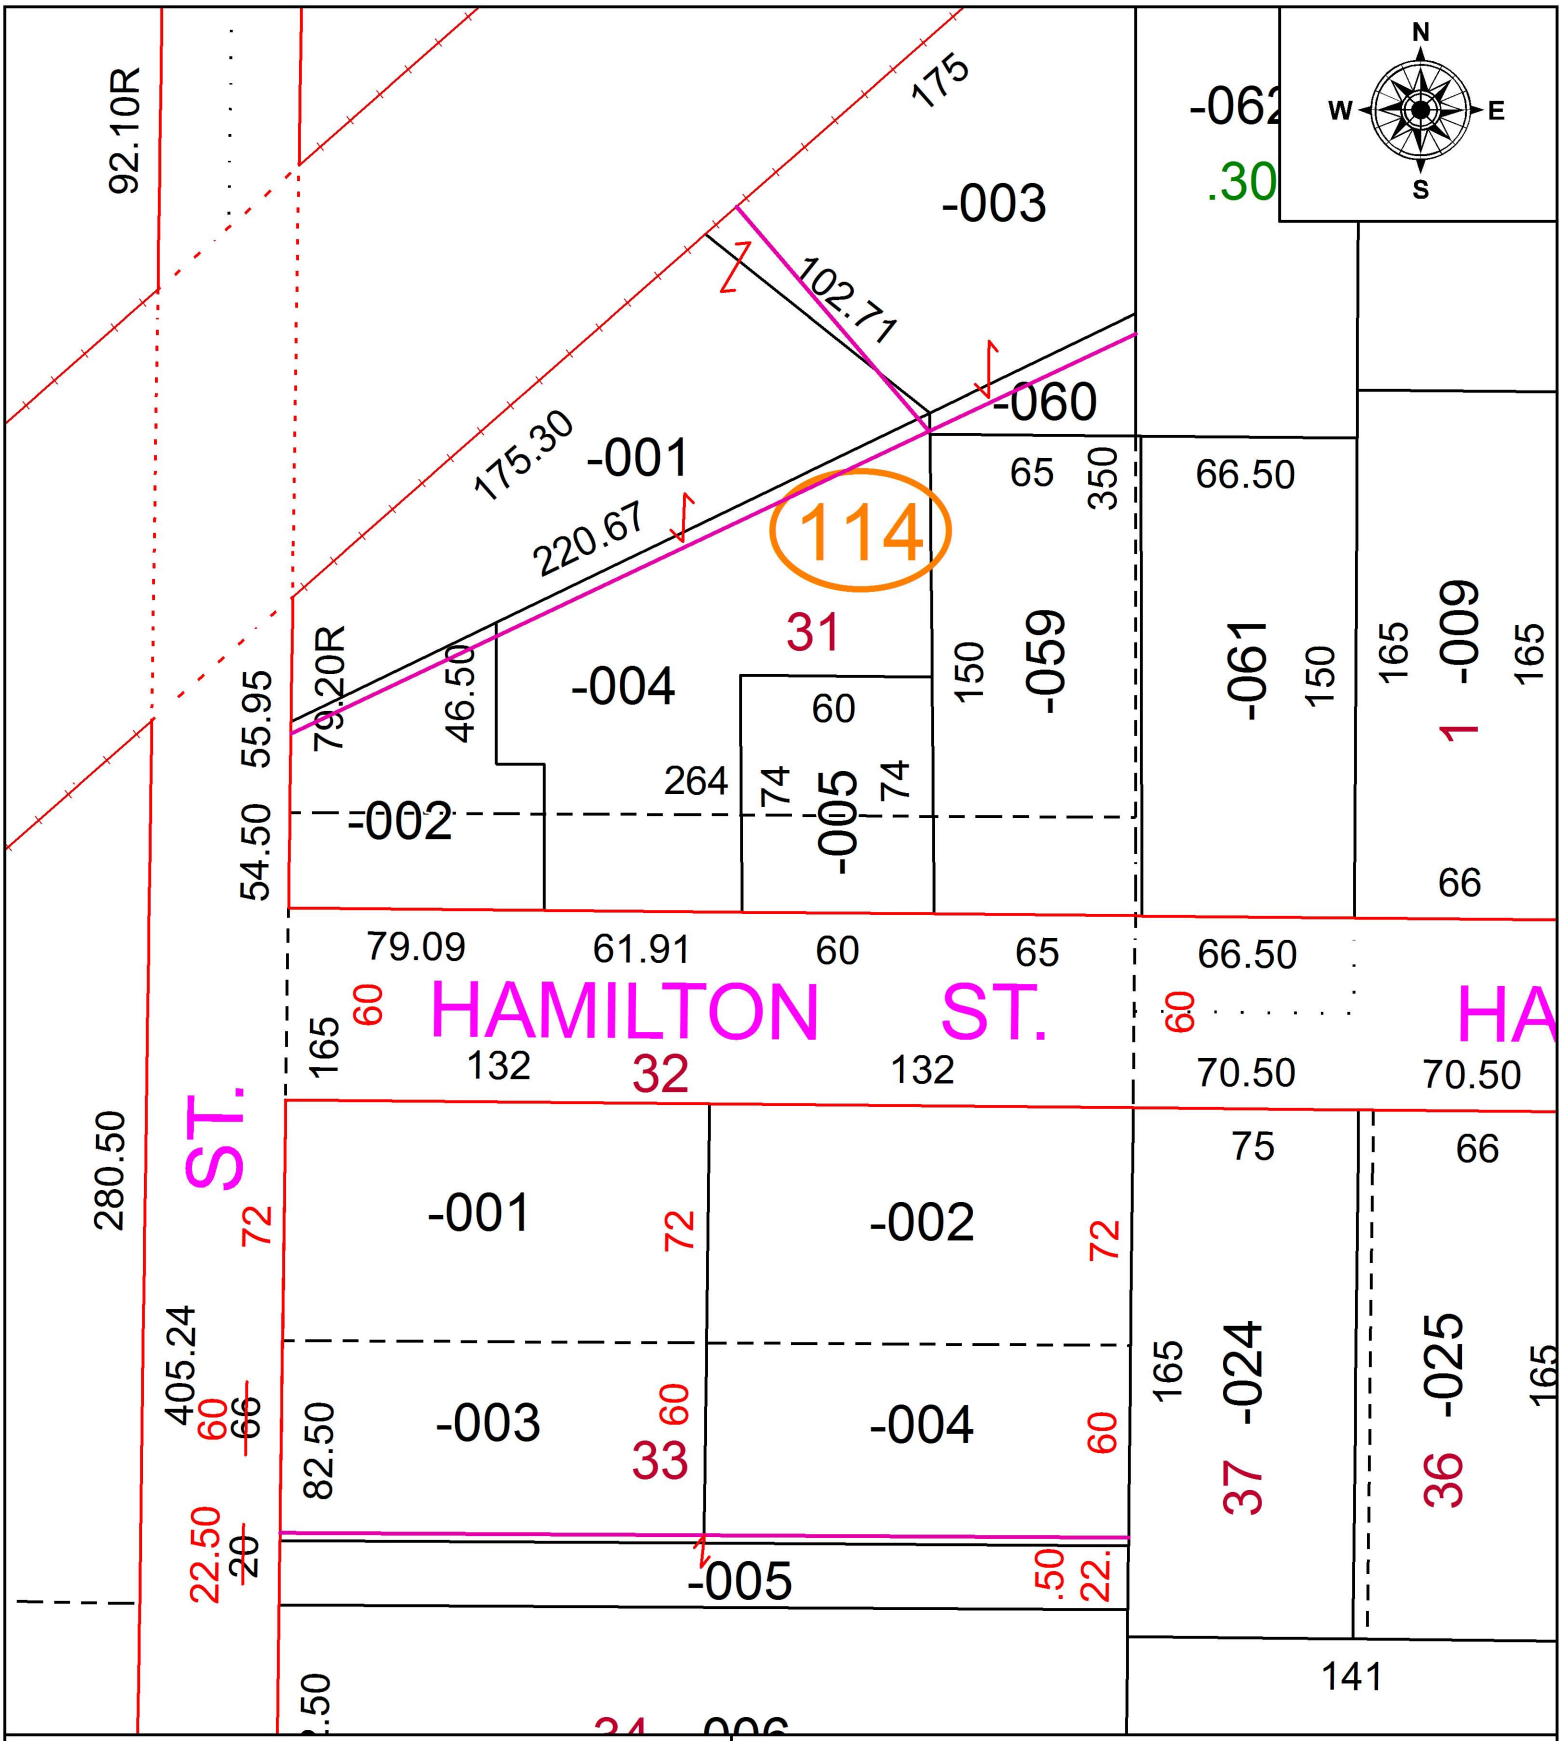

SPLITS/DEEDS PROCESSED

LORAIN COUNTY TAX MAP DEPARTMENT
226 MIDDLE AVE. ELYRIA, OH

SURVEYED BY: NA
CLOSURE: NA
MAP PAGE(S): 18-00-021
APPOVED BY: TJS **DATE:** 9/10/18
SCALE: 1" = 60' **PRIOR INSTRUMENT:** 2010-0355612