PARENT PARCEL: 17-08-032-000-005, -013
CHILD PARCEL: 17-08-032-000-014 THRU -016
STARTING POINT: INTERSECTION OF C/L OF S.R, 511 AND C/L OF PECK WADSWORTH RD.

19-03936

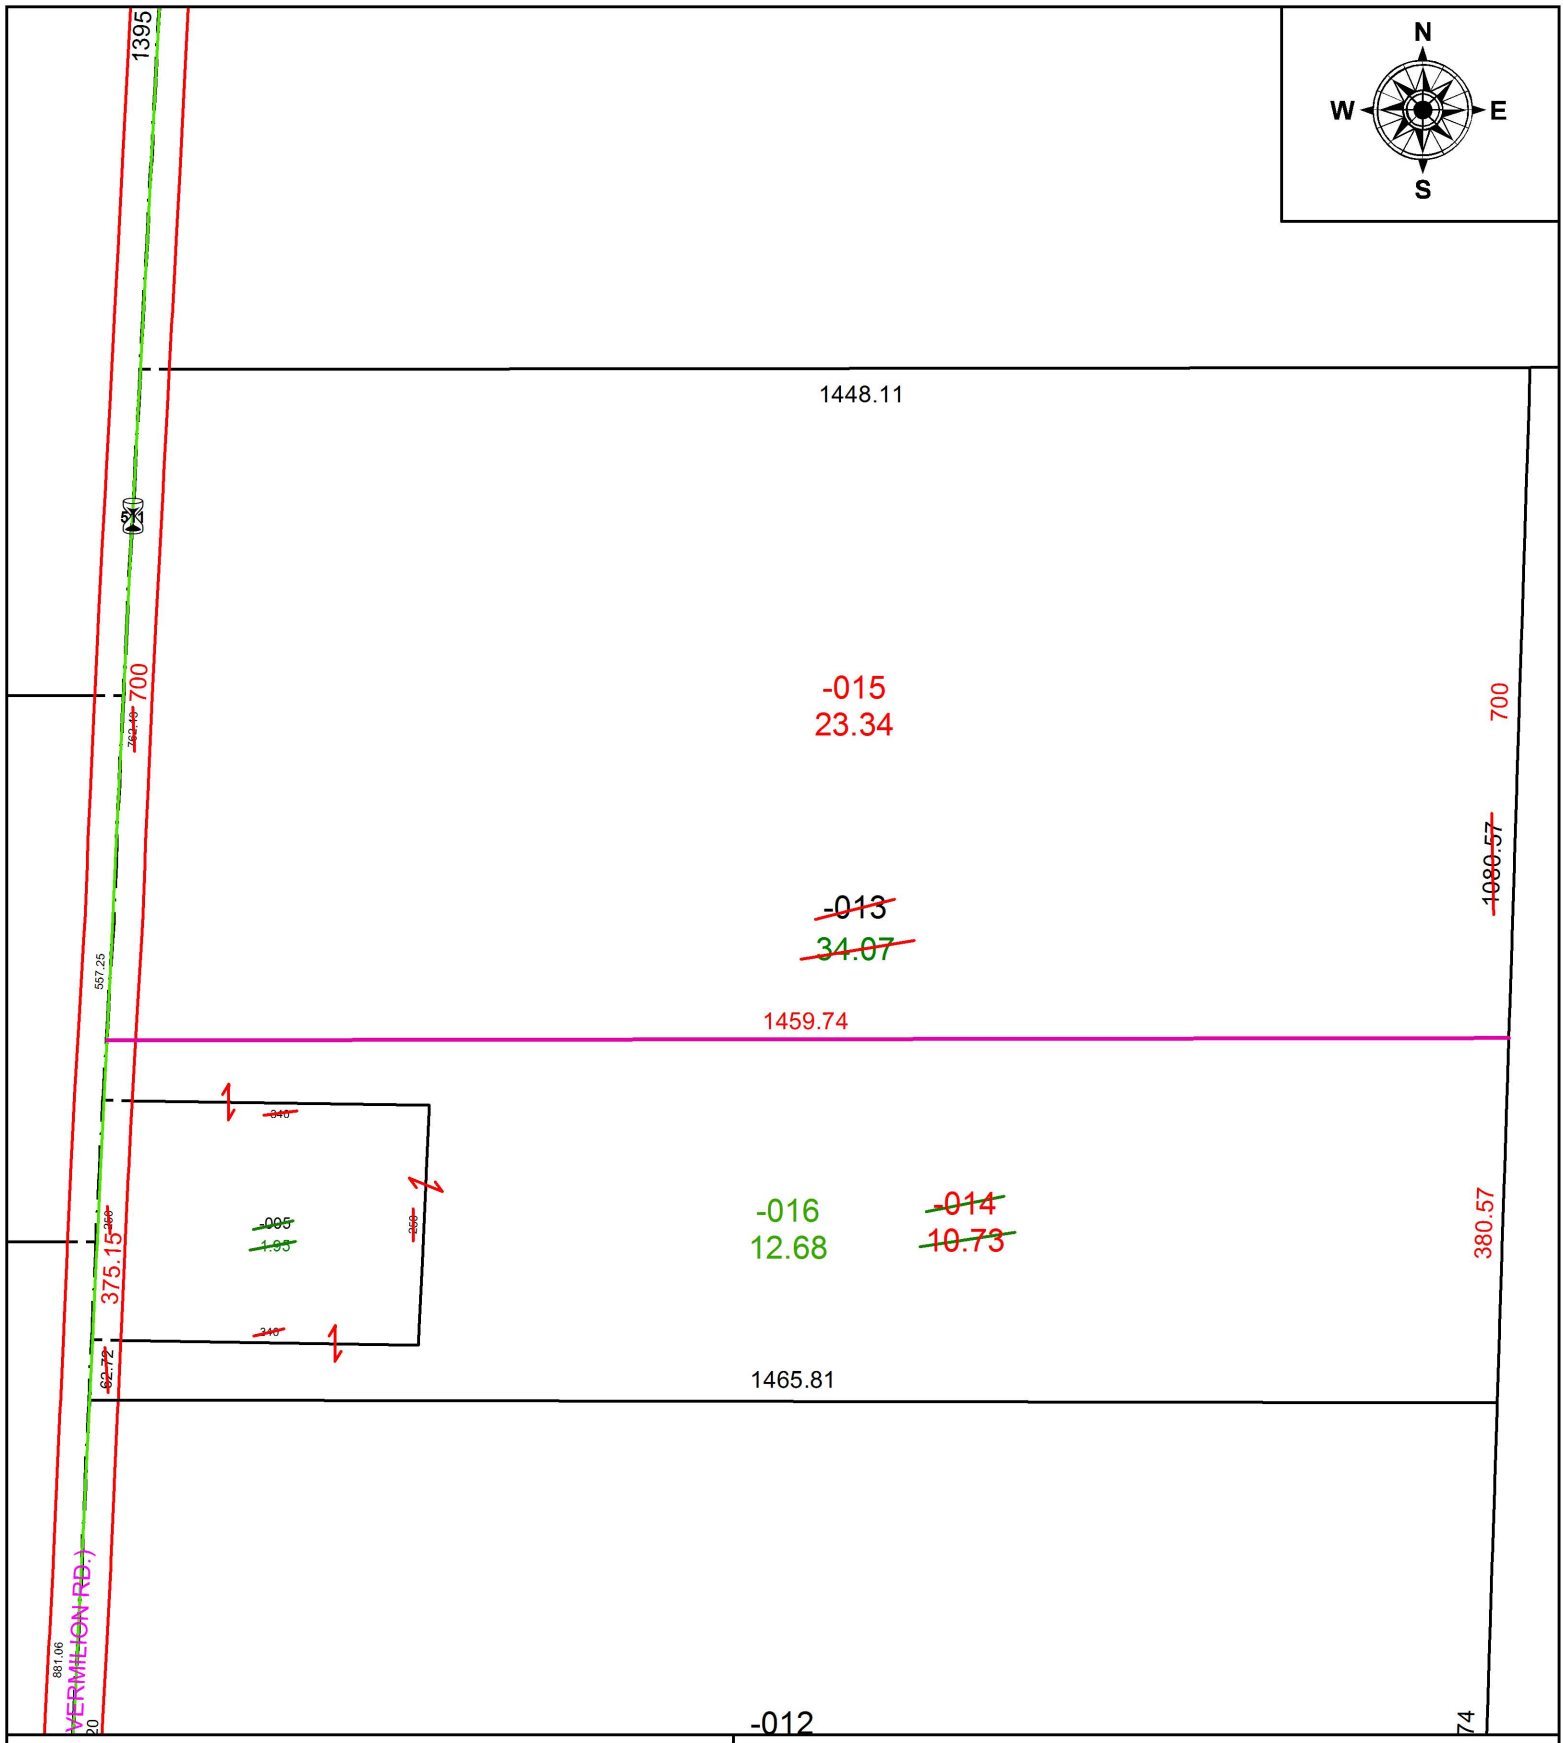

SPLITS/DEEDS PROCESSED
LORAIN COUNTY TAX MAP DEPARTMENT
226 MIDDLE AVE. ELYRIA, OH

SURVEYED BY: TIMOHTY D. HOZALSKI
CLOSURE: 1:479,336
MAP PAGE(S): 17-08-032
APPOVED BY: RRM **DATE:** 2-11-19
SCALE: 1" = 200 **PRIOR INSTRUMENT:** 20170641011