PARENT PARCEL: 04-00-024-116-032
CHILD PARCEL: 04-00-024-116-231 THRU -235
STARTING POINT: INTERSECTION OF C/L OF MILLS RD. AND C/L OF MILLS INDUSTRIAL PKWY.

19-03940

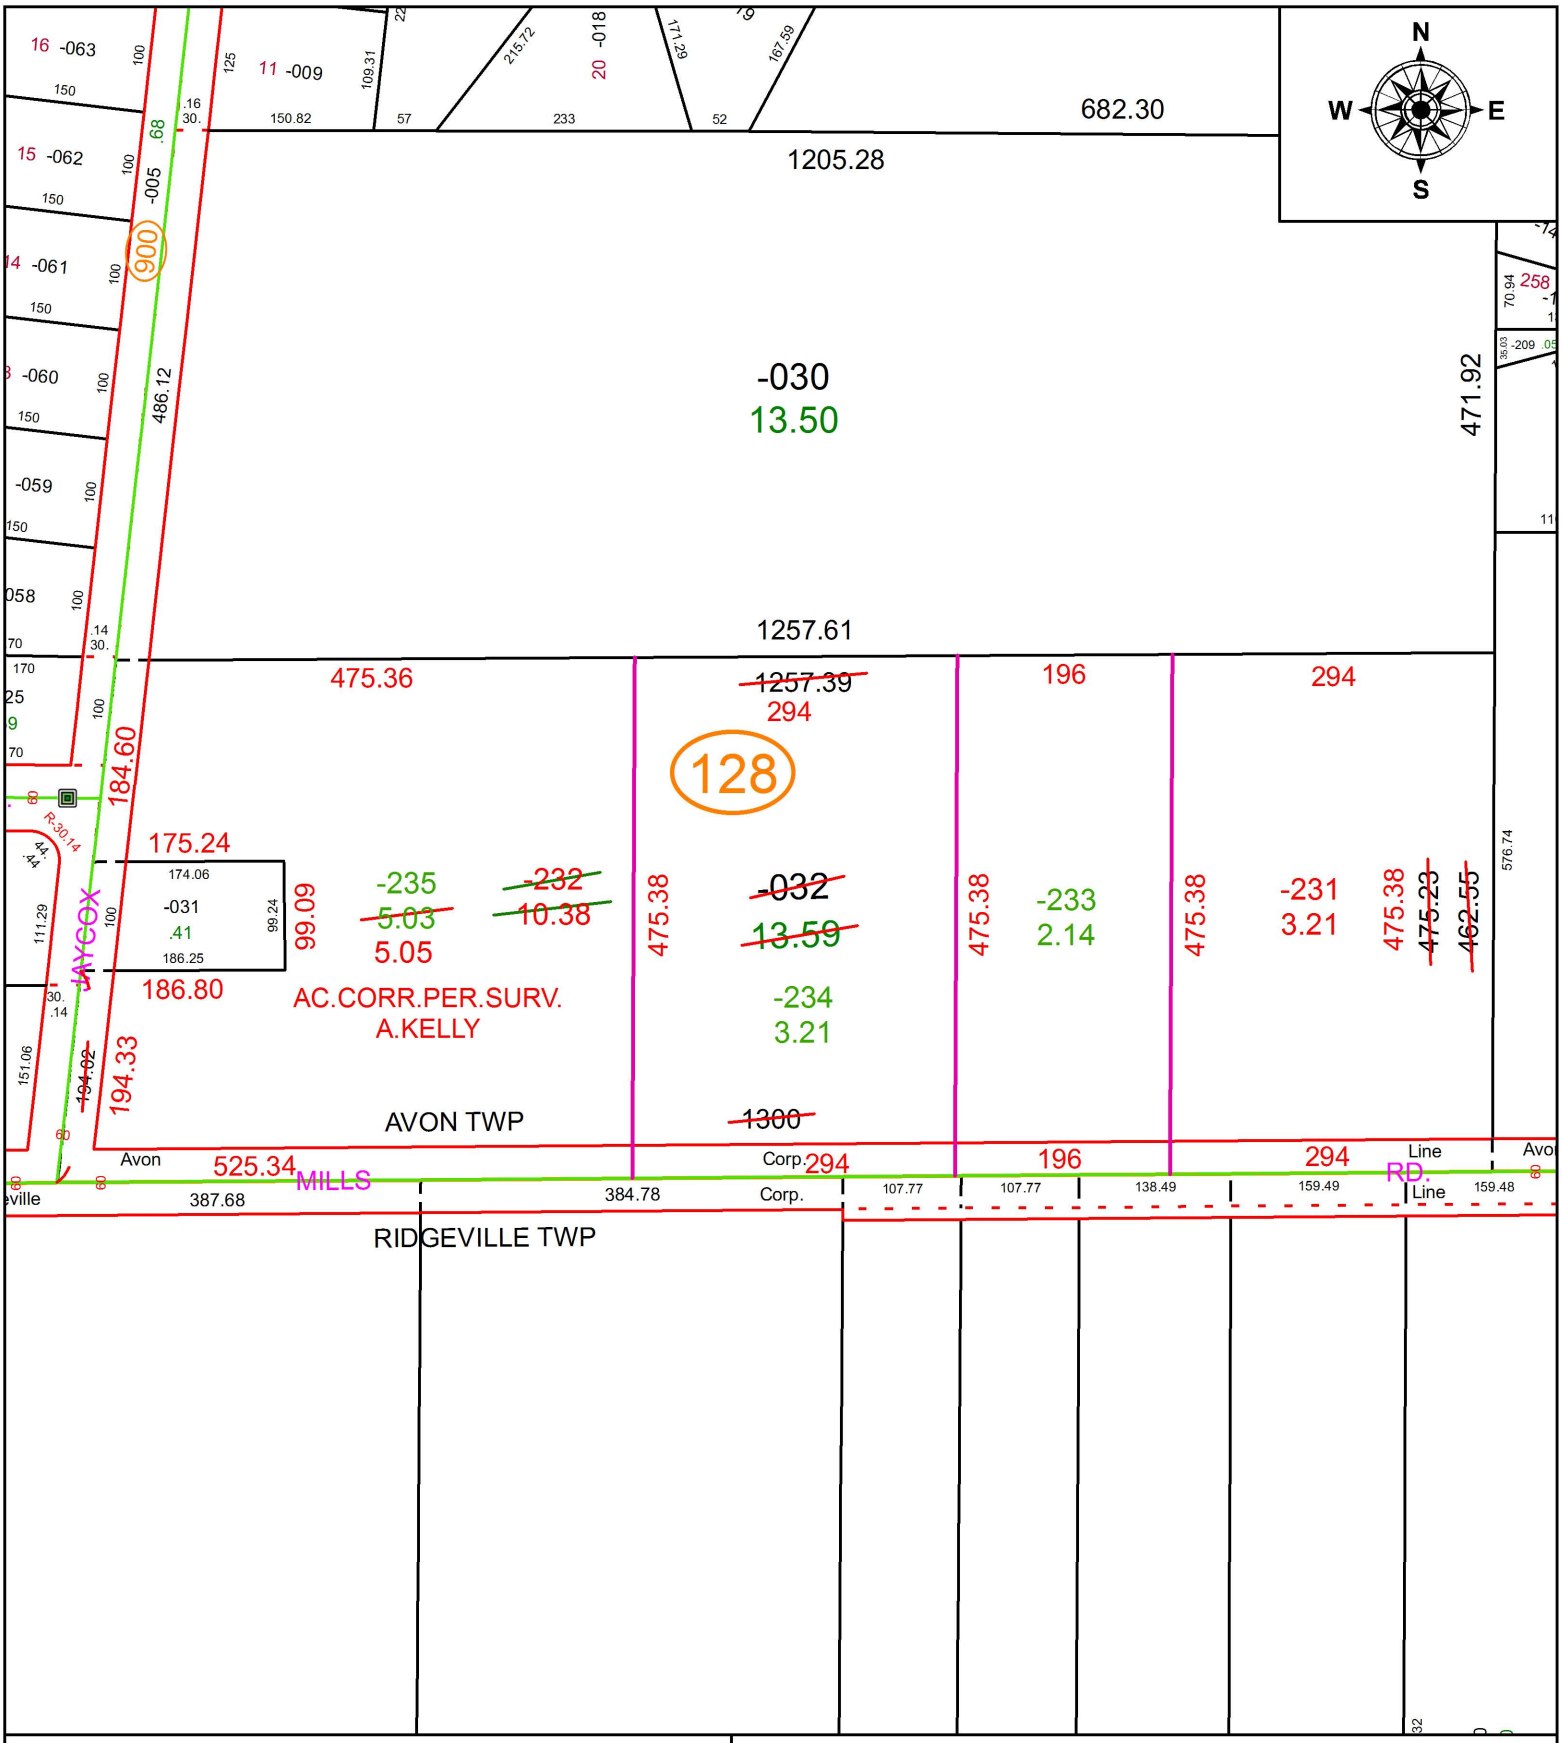

SPLITS/DEEDS PROCESSED

LORAIN COUNTY TAX MAP DEPARTMENT
226 MIDDLE AVE. ELYRIA, OH

SURVEYED BY: AMY M. KELLY
CLOSURE: 1:1,083,025
MAP PAGE(S): 4-00-024
APPOVED BY: RRM **DATE:** 2-21-19
SCALE: 1" = 175 **PRIOR INSTRUMENT:** 20140529608