PARENT PARCEL: 05-00-043-104-007, -026, 05-00-043-107-007, -017, -018, -022, -038

CHILD PARCEL: 05-00-043-104-028, 05-00-043-107-038, -039 THRU -041

STARTING POINT: INTERSECTION OF C/L OF NICHOLSON AVE. AND C/L OF LIBERTY AVE.

19-03941

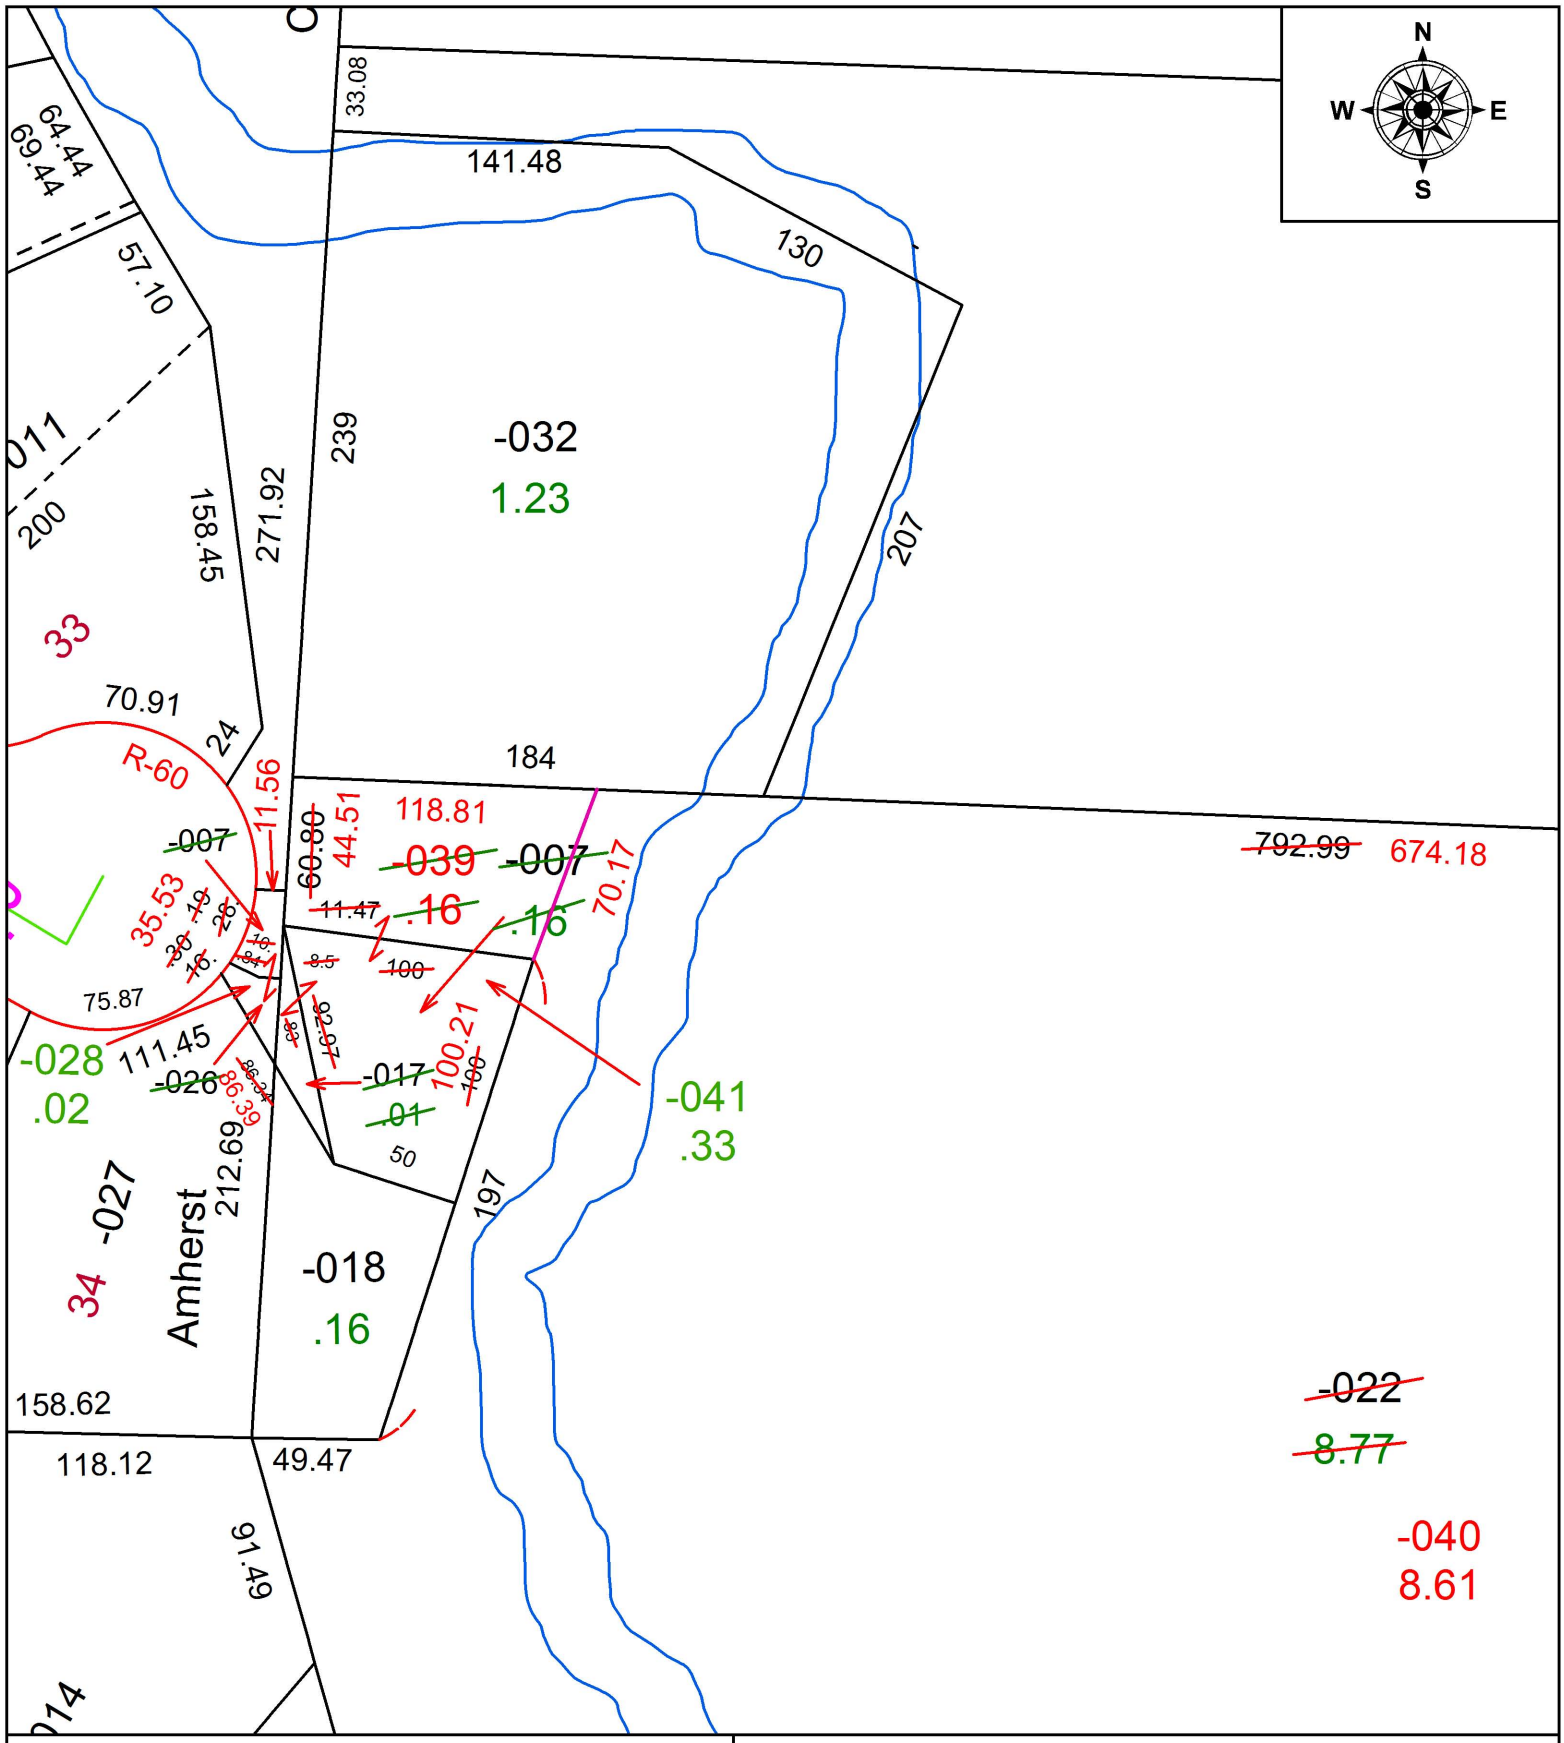

SPLITS/DEEDS PROCESSED

LORAIN COUNTY TAX MAP DEPARTMENT
226 MIDDLE AVE. ELYRIA, OH

SURVEYED BY: TIMOTHY D. HOZALSKI
CLOSURE: 1:48,353
MAP PAGE(S): 5-00-043
APPOVED BY: RRM **DATE:** 2-22-19
SCALE: 1" = 75 **PRIOR INSTRUMENT:** 20180687146