PARENT PARCEL: 06-25-007-000-141, -197
CHILD PARCEL: 06-25-007-000-271
STARTING POINT: SOUTHEAST CORNER OF S/L 19 IN REASER INDUSTRIAL PARK SUB. (PV 54/54)

19-03942

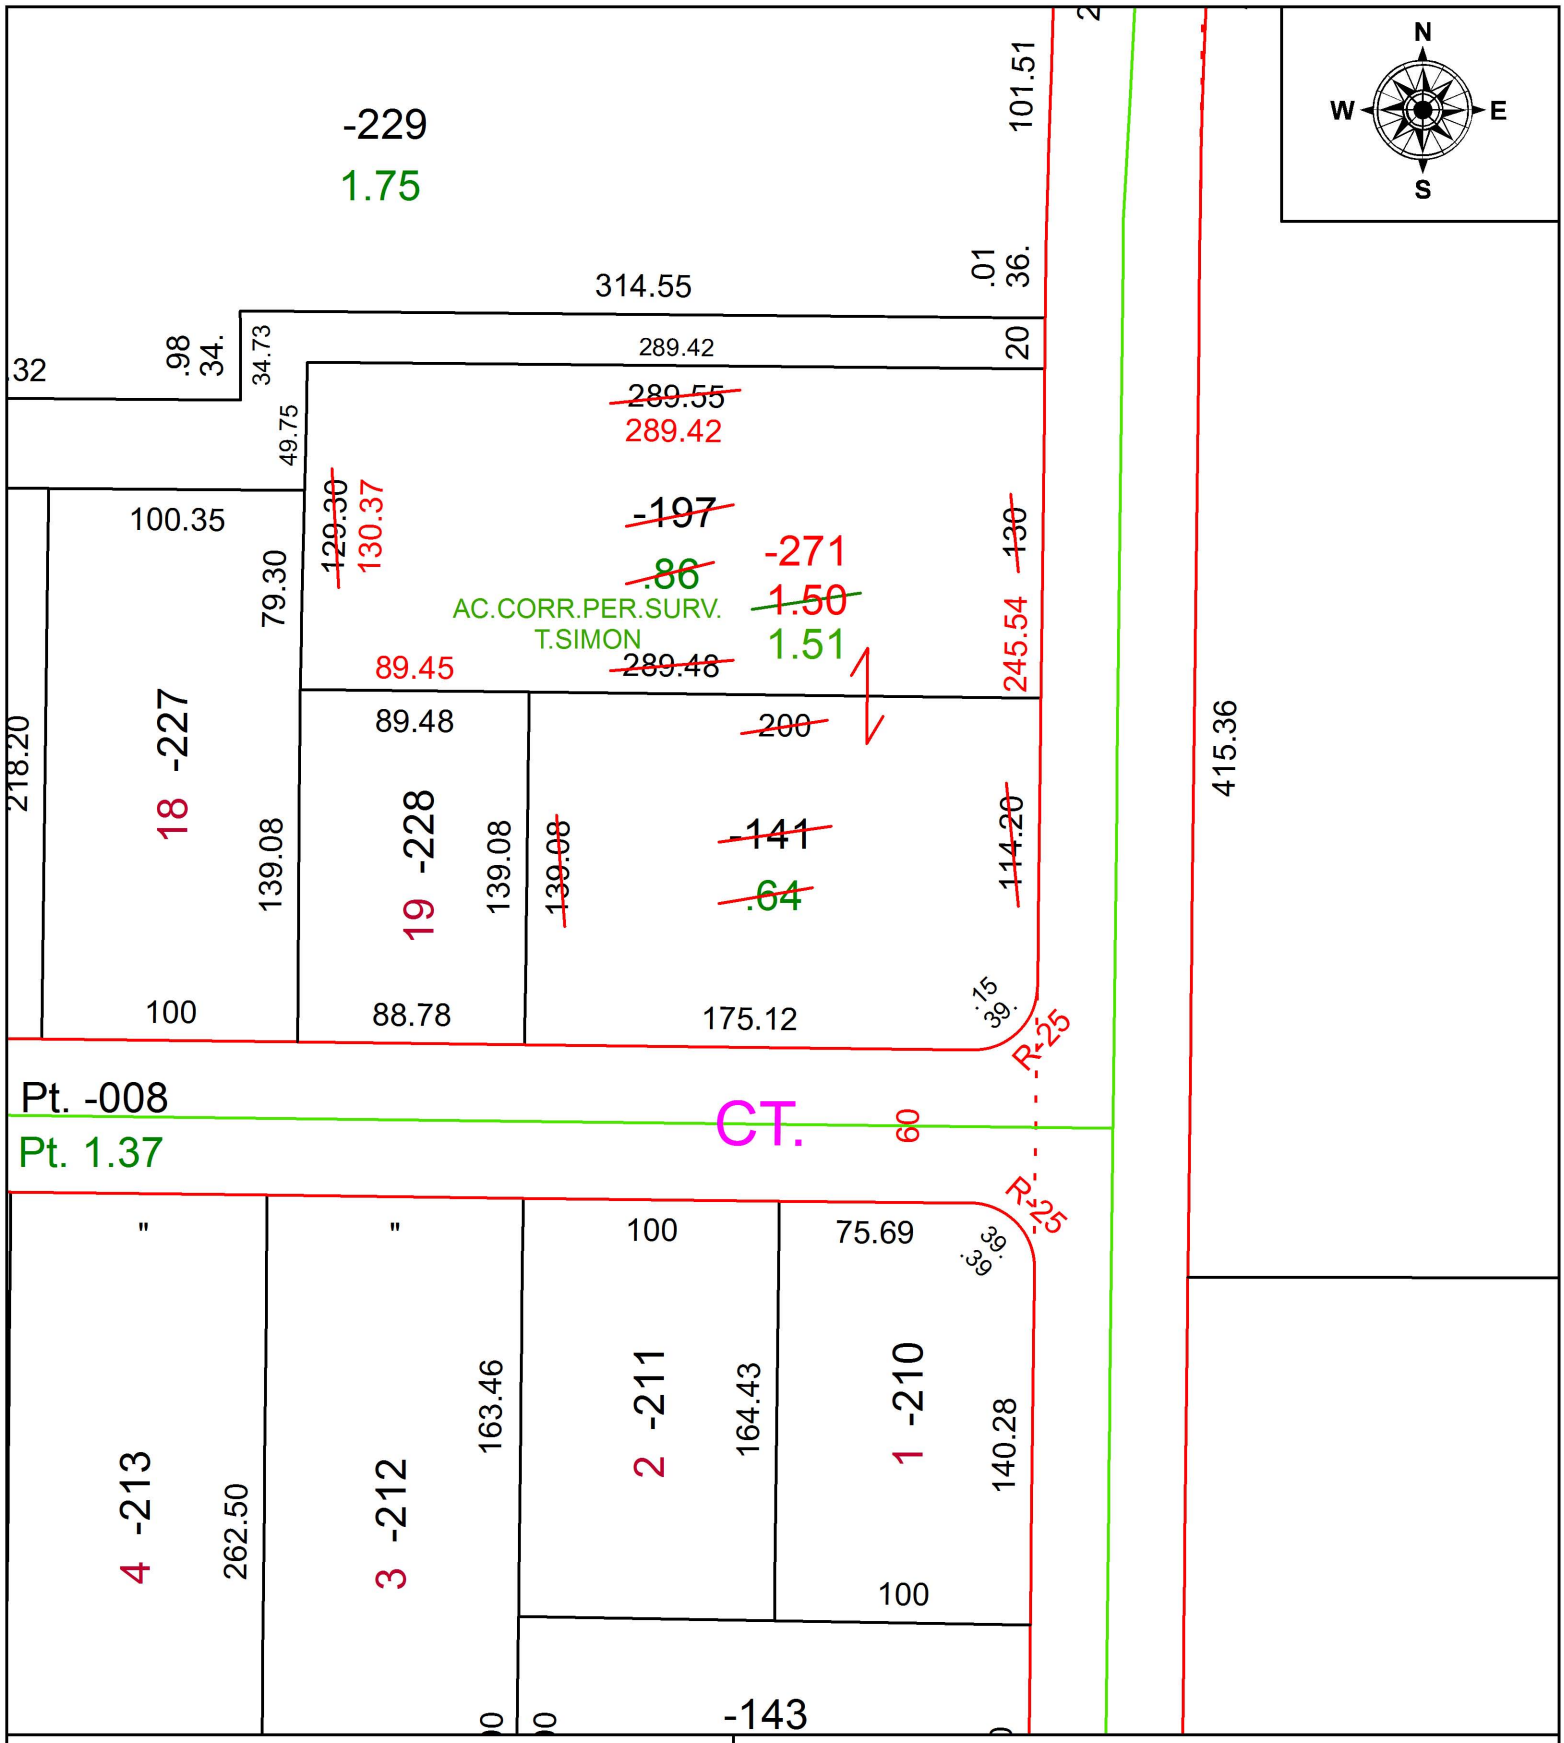

SPLITS/DEEDS PROCESSED
LORAIN COUNTY TAX MAP DEPARTMENT
226 MIDDLE AVE. ELYRIA, OH

SURVEYED BY: THOMAS A. SIMON
CLOSURE: 1: 86,992
MAP PAGE(S): 6-25-007
APPOVED BY: RRM **DATE:** 2-22-19
SCALE: 1" = 75 **PRIOR INSTRUMENT:** 20160574140