PARENT PARCEL: 17-08-033-000-008, 17-08-034-000-013

CHILD PARCEL: 17-08-033-000-008, 17-08-034-000-014 THRU -016

STARTING POINT: INTERSECTION OF C/L OF PECK WADSWORTH RD. AND C/L OF S.R. 511

19-03943

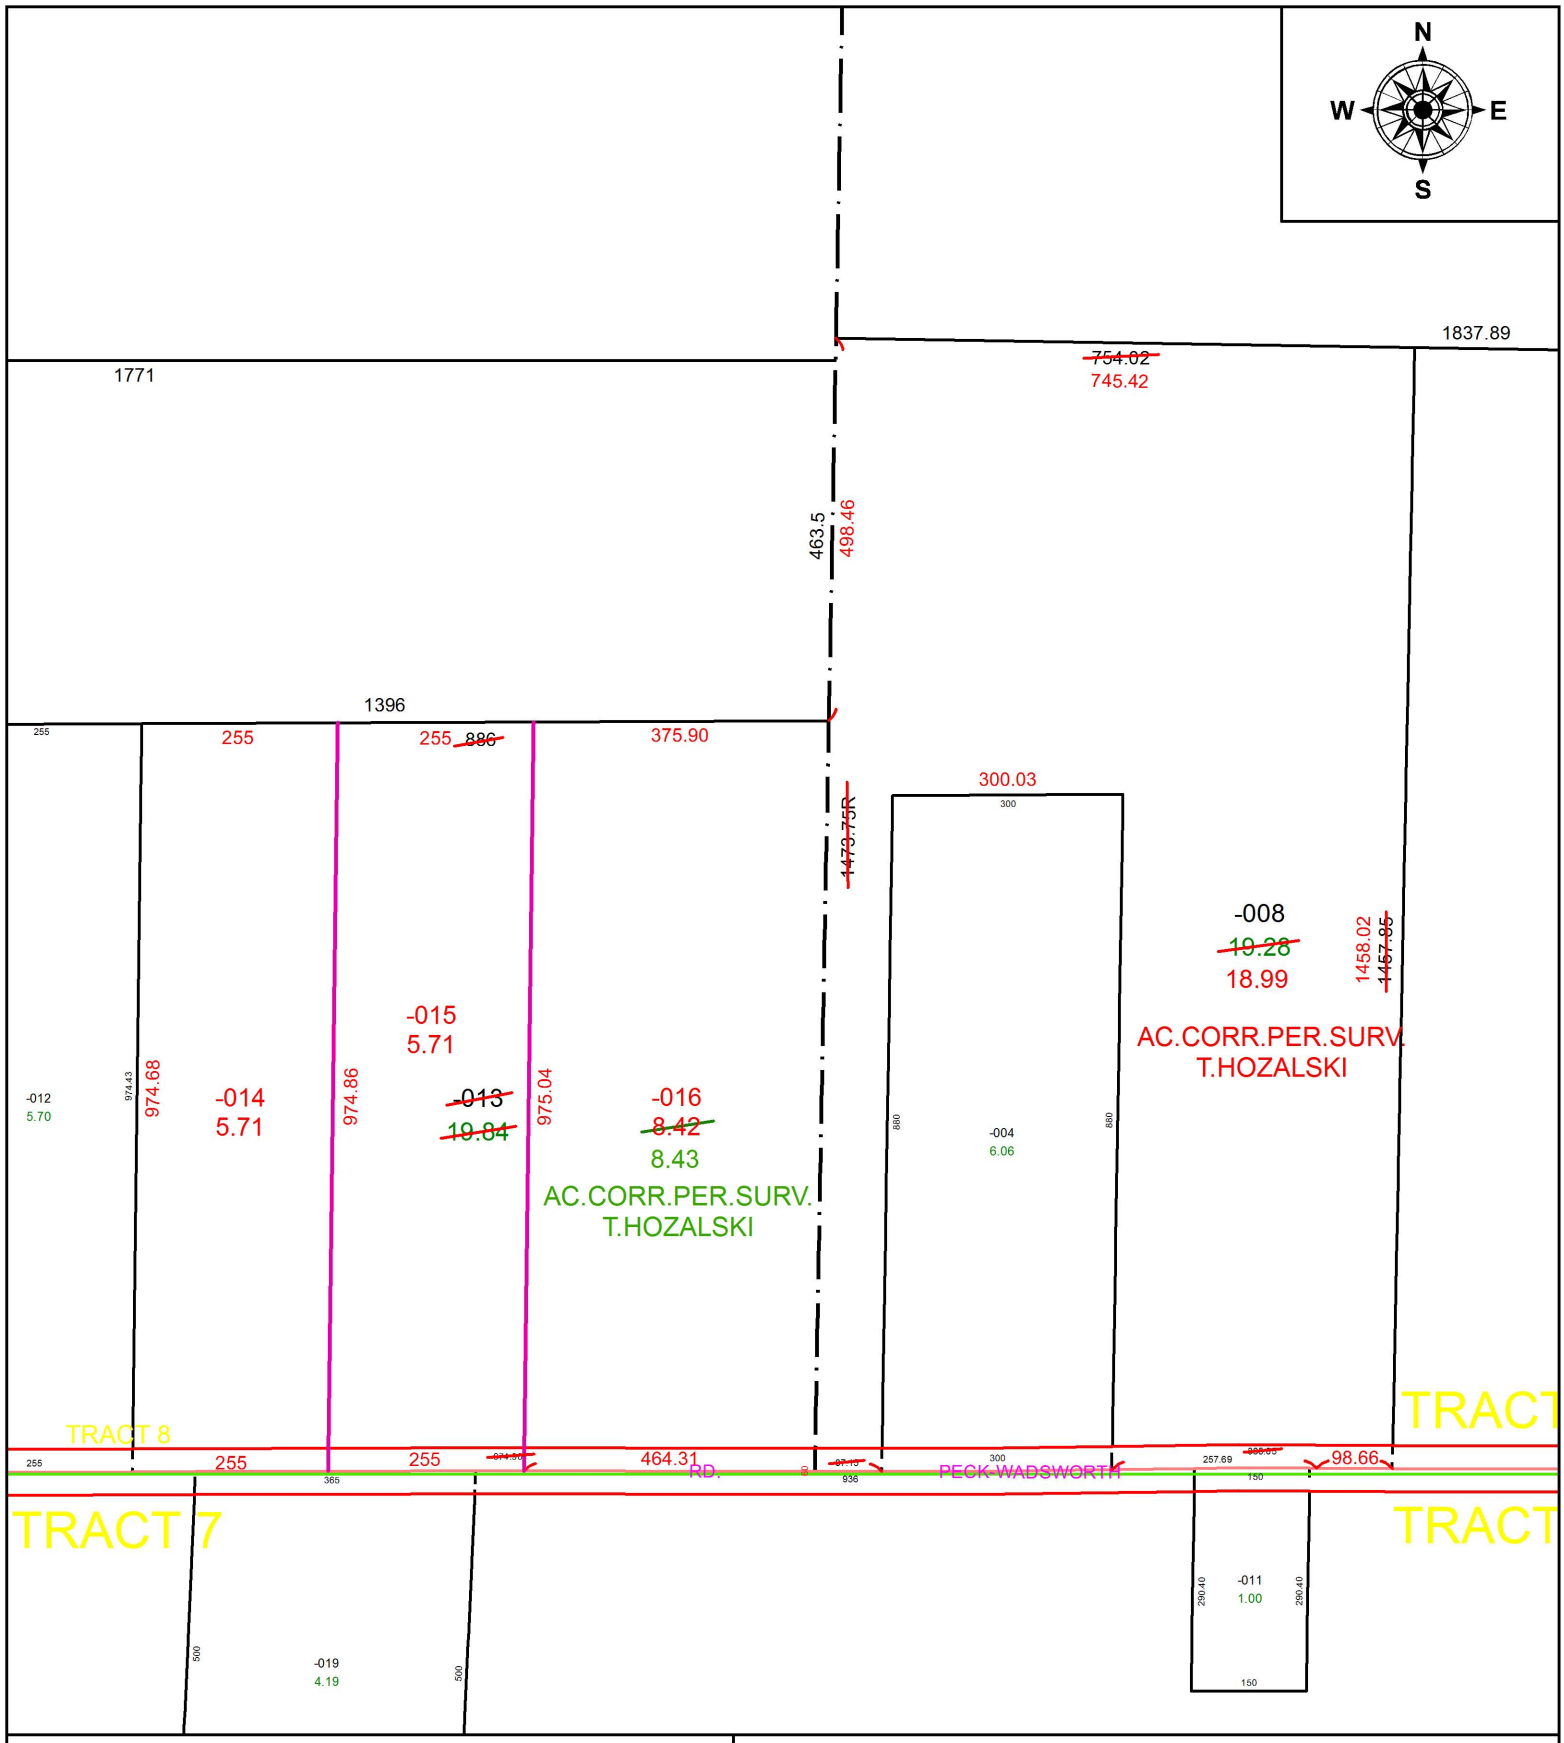

SPLITS/DEEDS PROCESSED

LORAIN COUNTY TAX MAP DEPARTMENT
226 MIDDLE AVE. ELYRIA, OH

SURVEYED BY: TIMOTHY D. HOZALSKI
CLOSURE: 1:726,444
MAP PAGE(S): 17-08-034
APPOVED BY: RRM **DATE:** 2-26-19
SCALE: 1" = 250 **PRIOR INSTRUMENT:** 19990627537